


13 H

* () * *

13-09-025-000
 Map of Survey of 4.00 Acres
 For Slot Grills
 D.L. 25 Tract 9 - Camden Twp.
 John R. Hamilton - Reg. Surv.
 5/11/88 Rev. 6/14/88 #6861

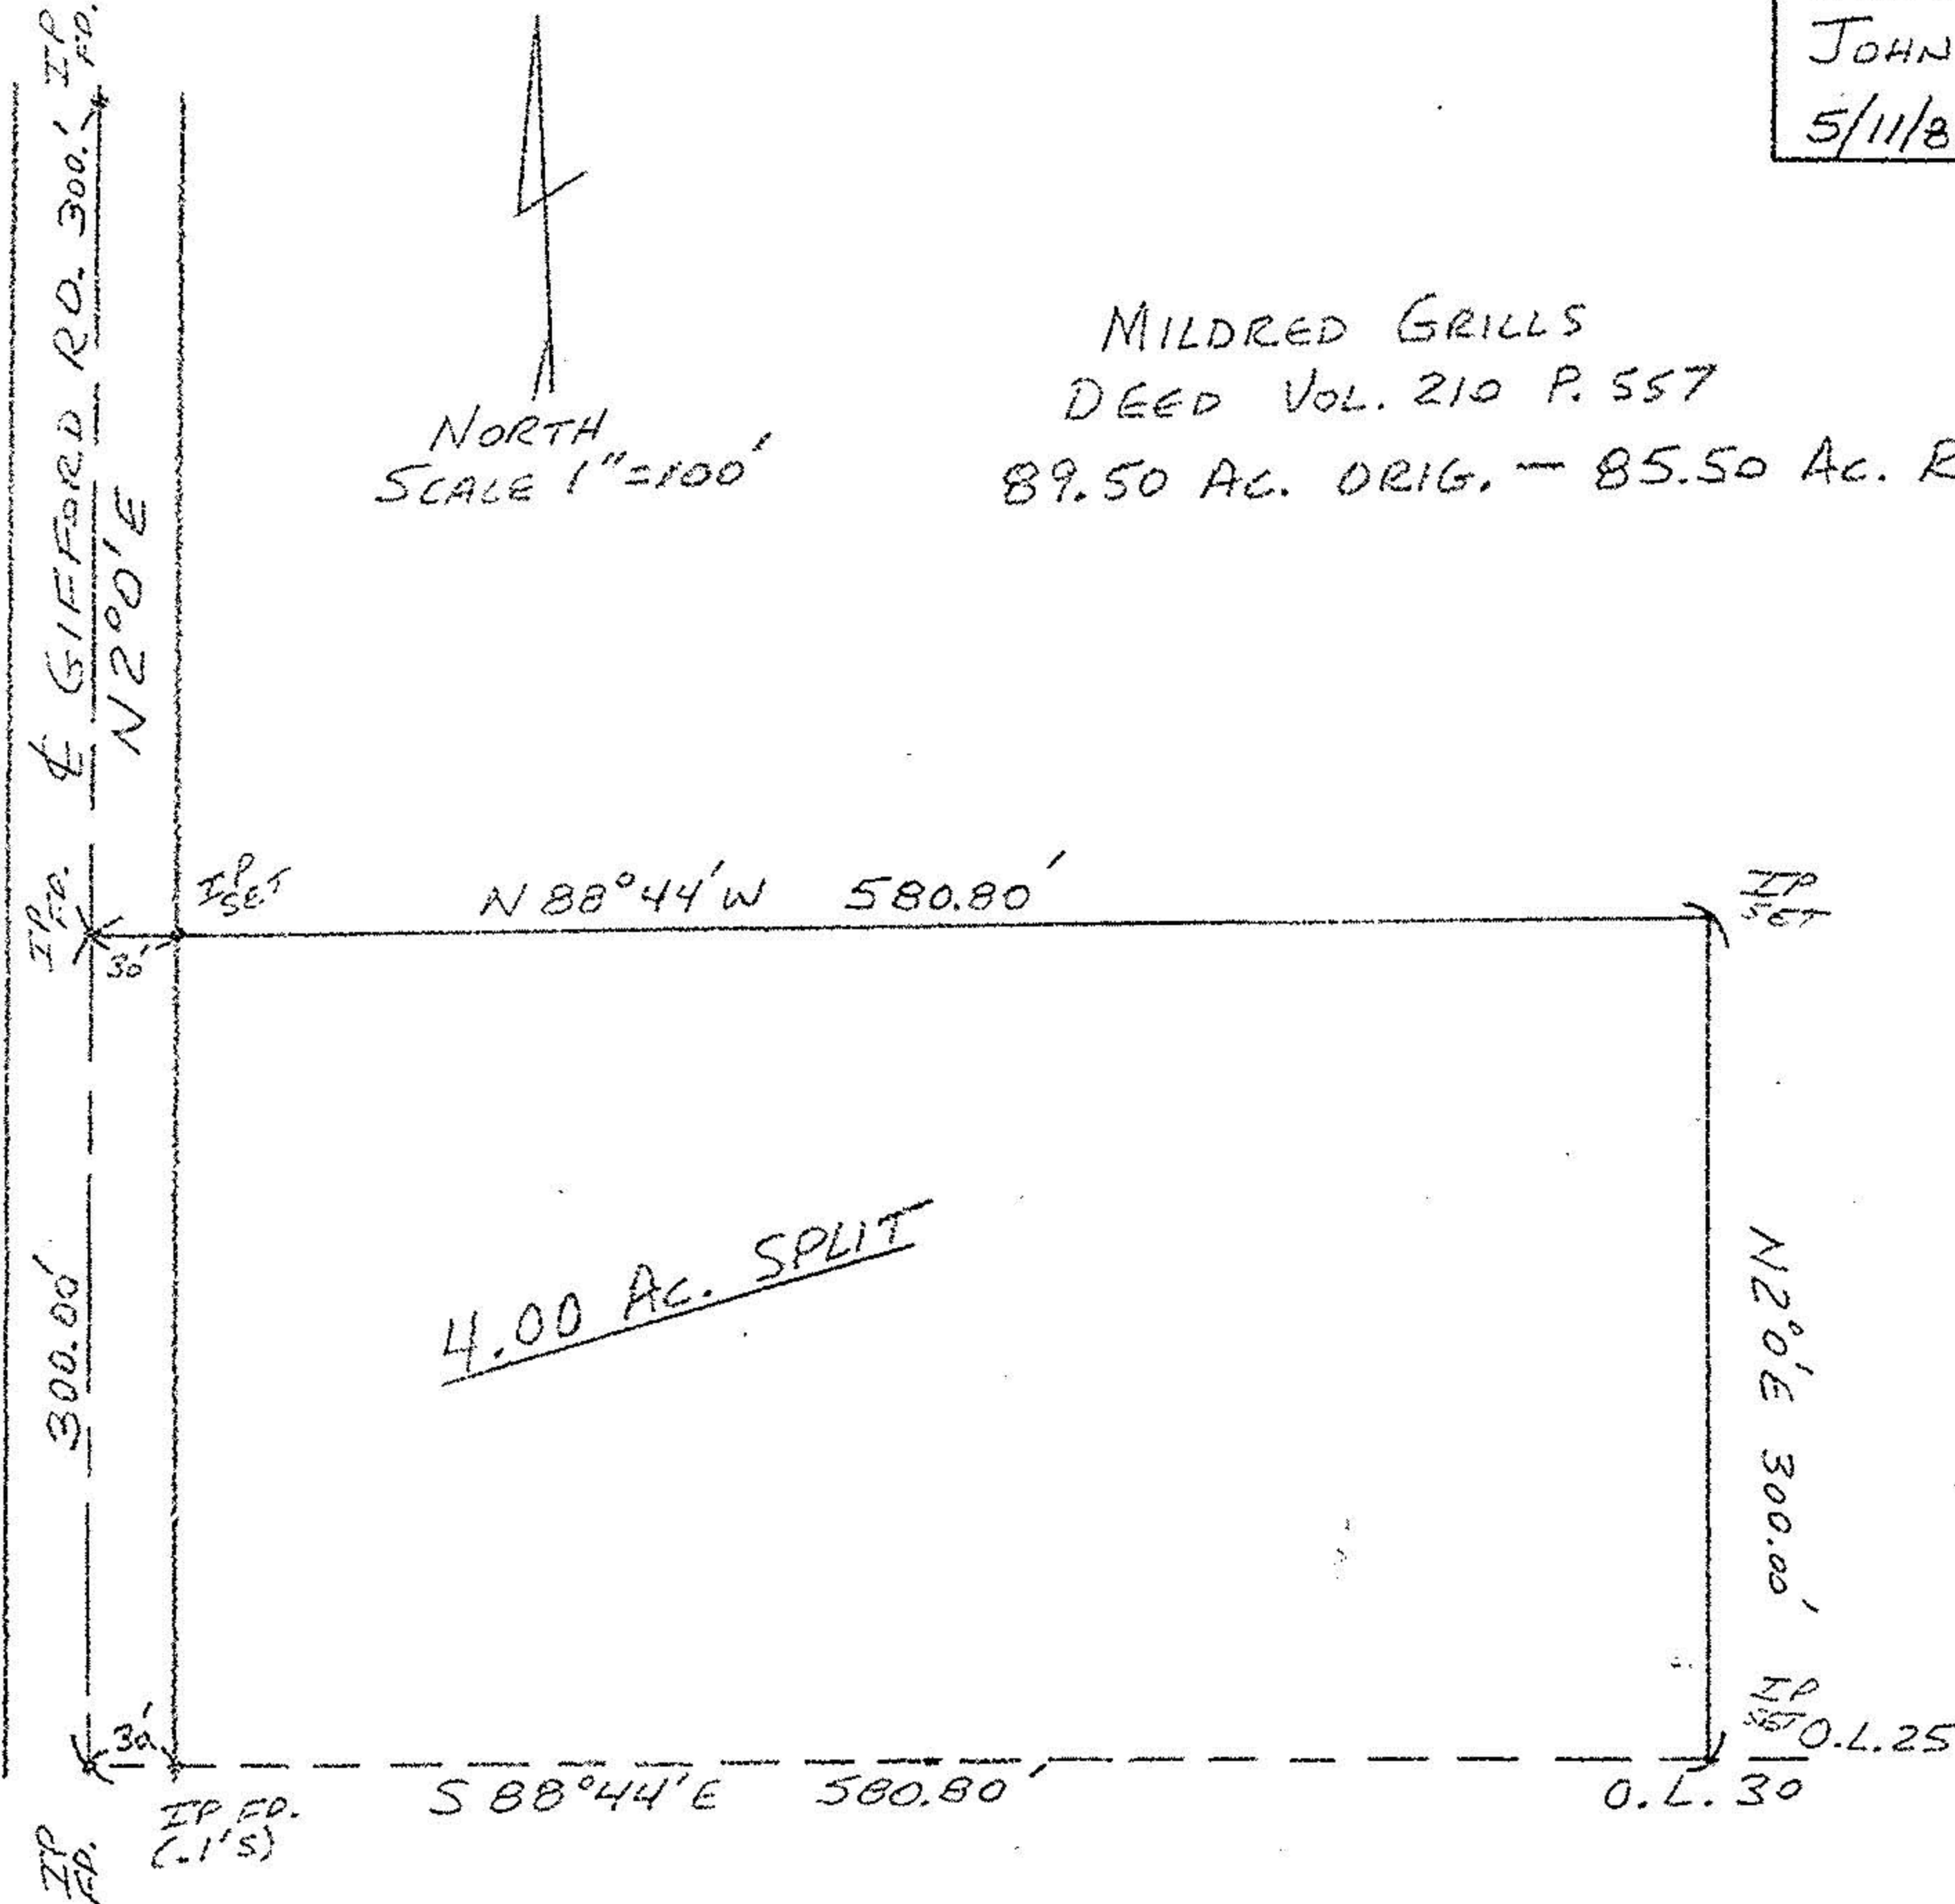

MILDRED GRILLS
 DEED VOL. 210 P. 557
 89.50 AC. ORIG. - 85.50 AC. REM.



18014

APPROVED
LORAIN CO.
MAP DEPT.
DATE 6-29-88
PAGE 13-H
BY Carol-Francis
VOID AFTER # 18014