


#8805#

DISTANCES MISSING X

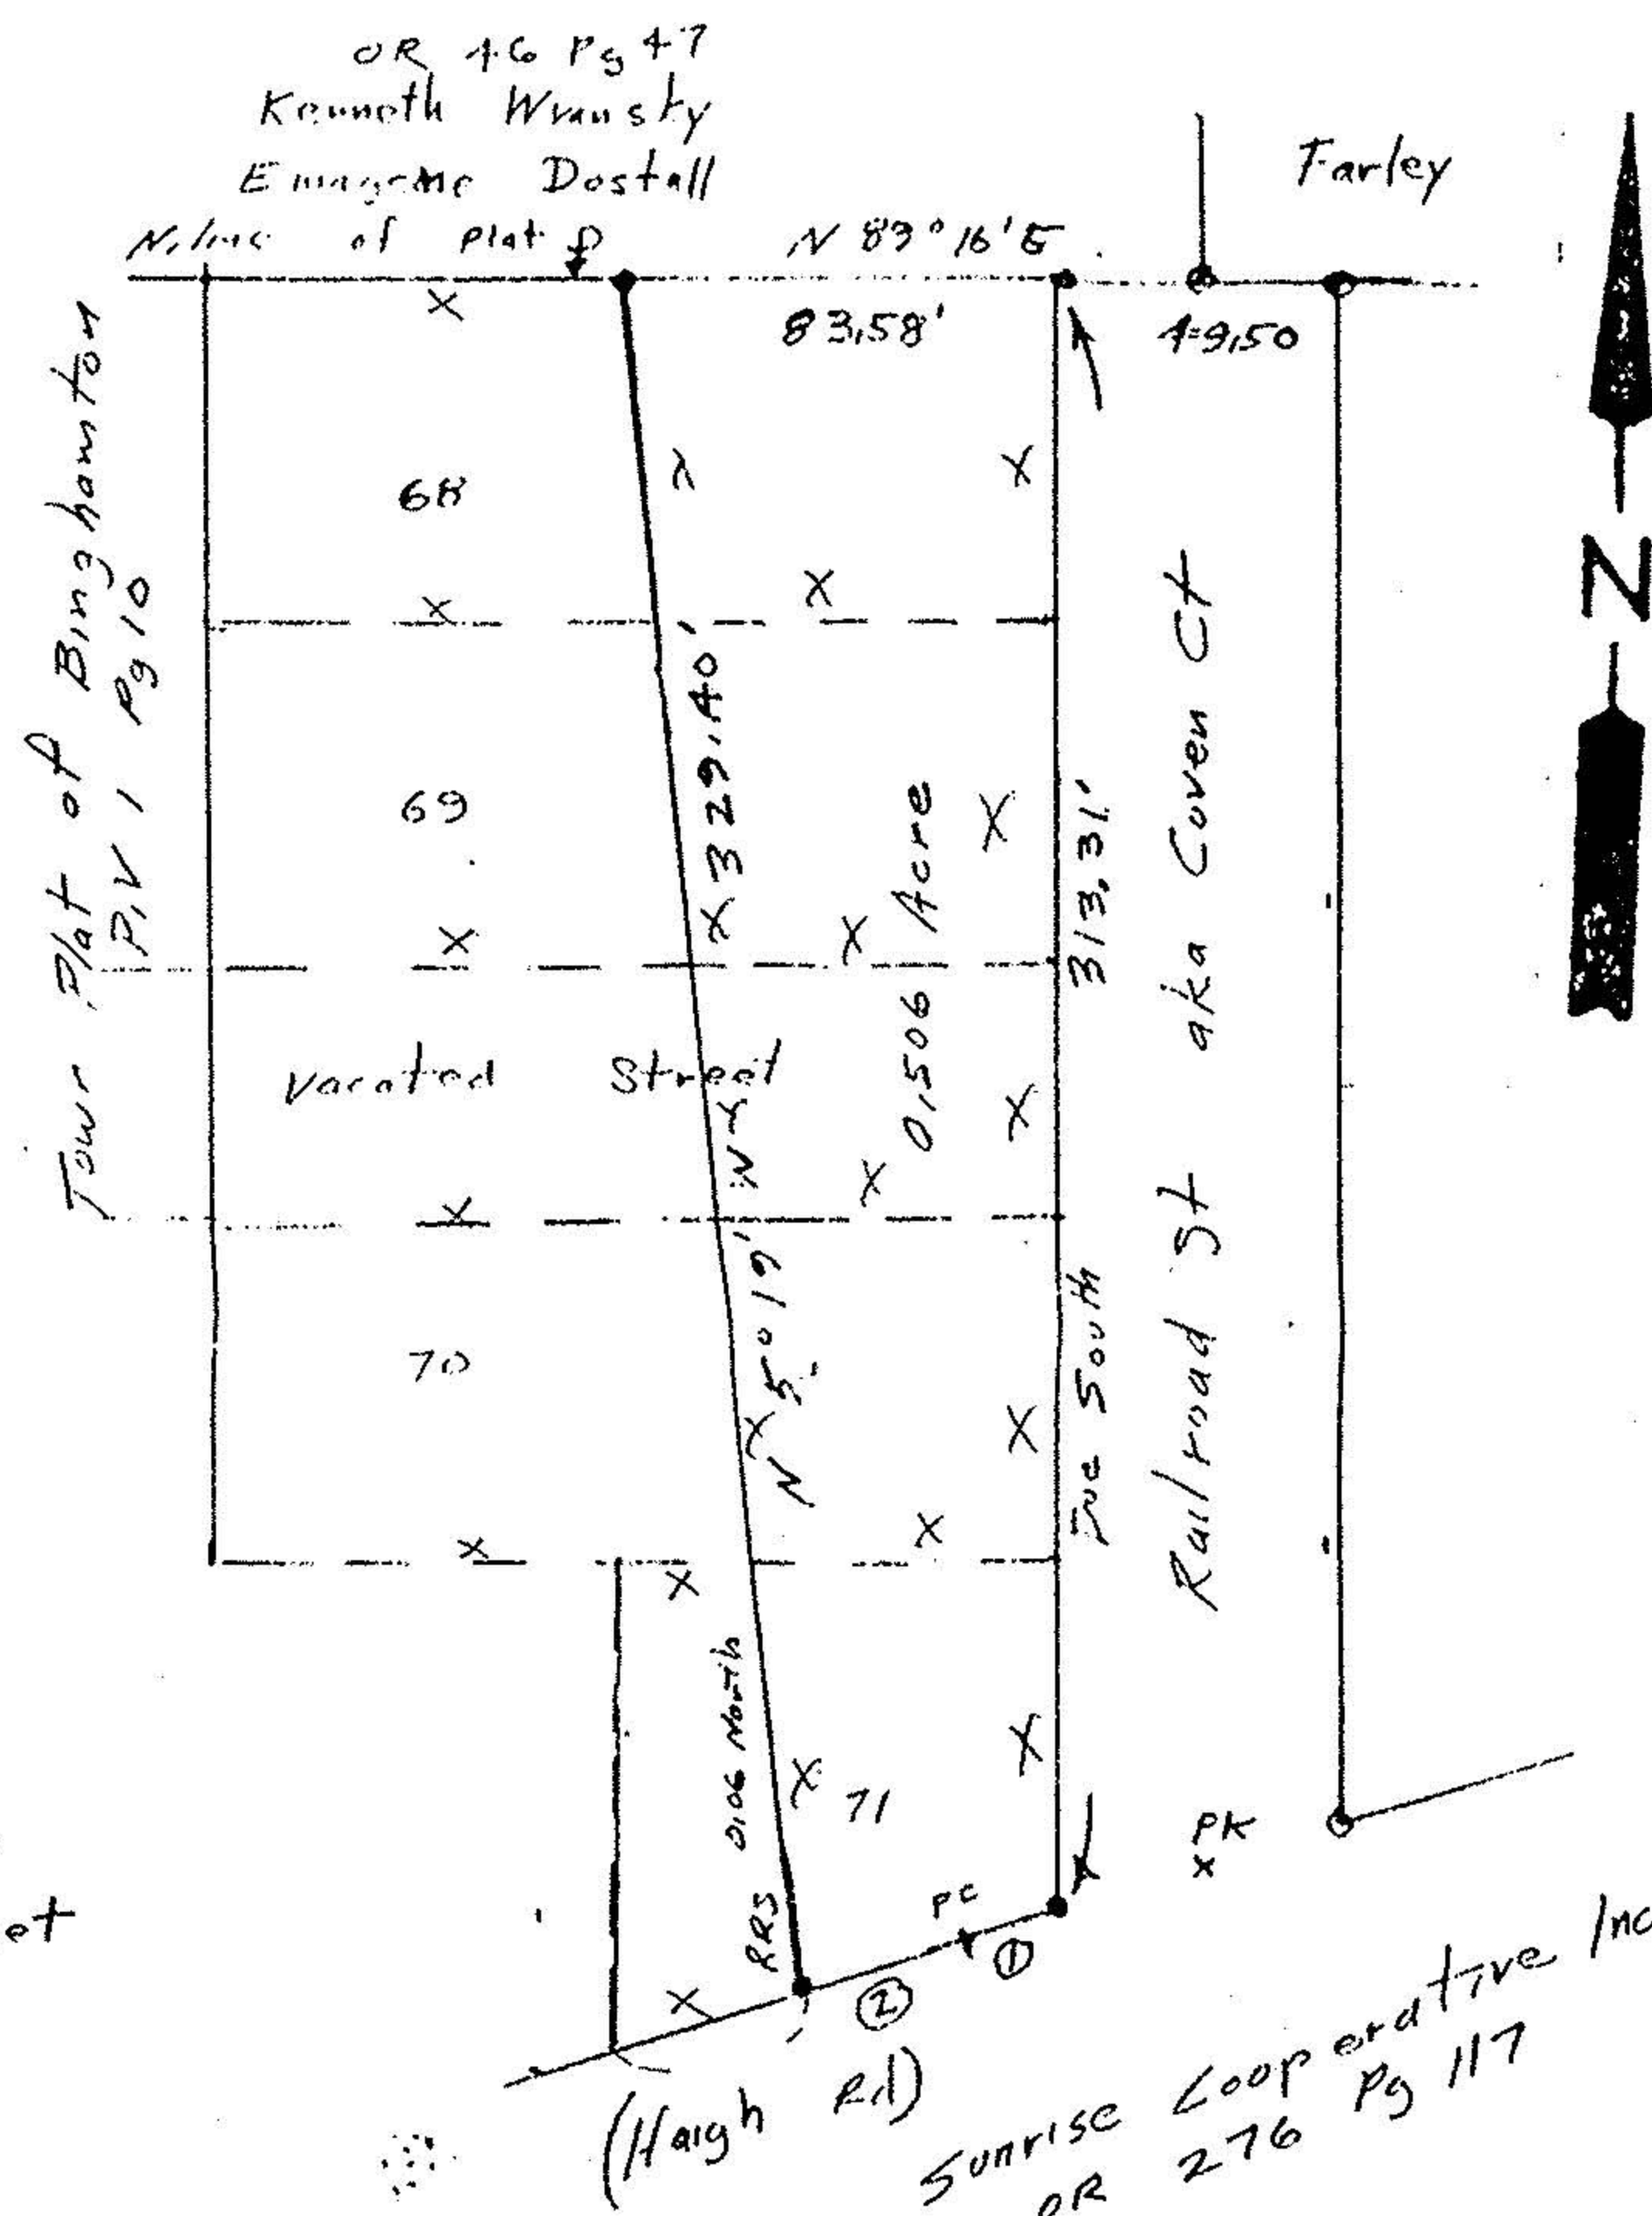

- o iron pipes fd
- iron pipes set
- x PK nail


① S 73° 32' W 18.00'

② S 73° 26' 34" W CB
 Arc 37.24'
 Ch 37.24
 R = 11,784.35'

John Pozywak
 Reg Surveyor
 5292


Survey of
 Parts of sublots 68, 69, 70
 Town Plat Binghamton
 P. Vol 1 Pg 10
 Tract 11 Original Lot 16

Original Camden Townshd
 Lorain County Ohio
 Scale 1" = 60' Nov 1992

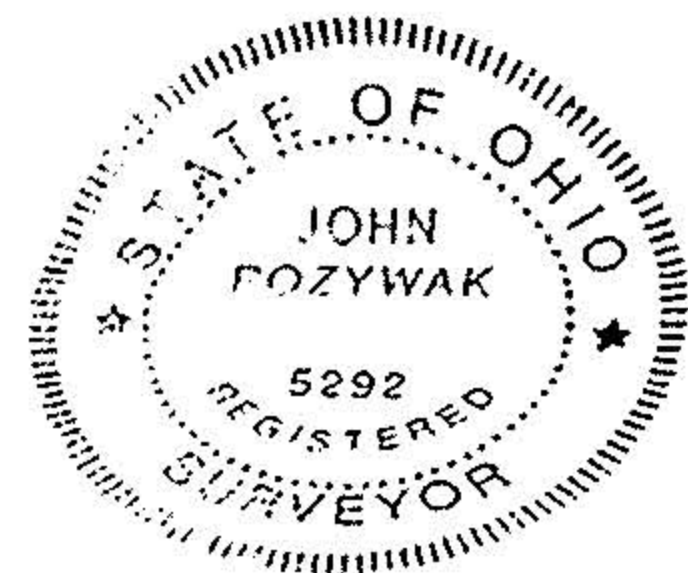

13-11-016-101
102

#20287

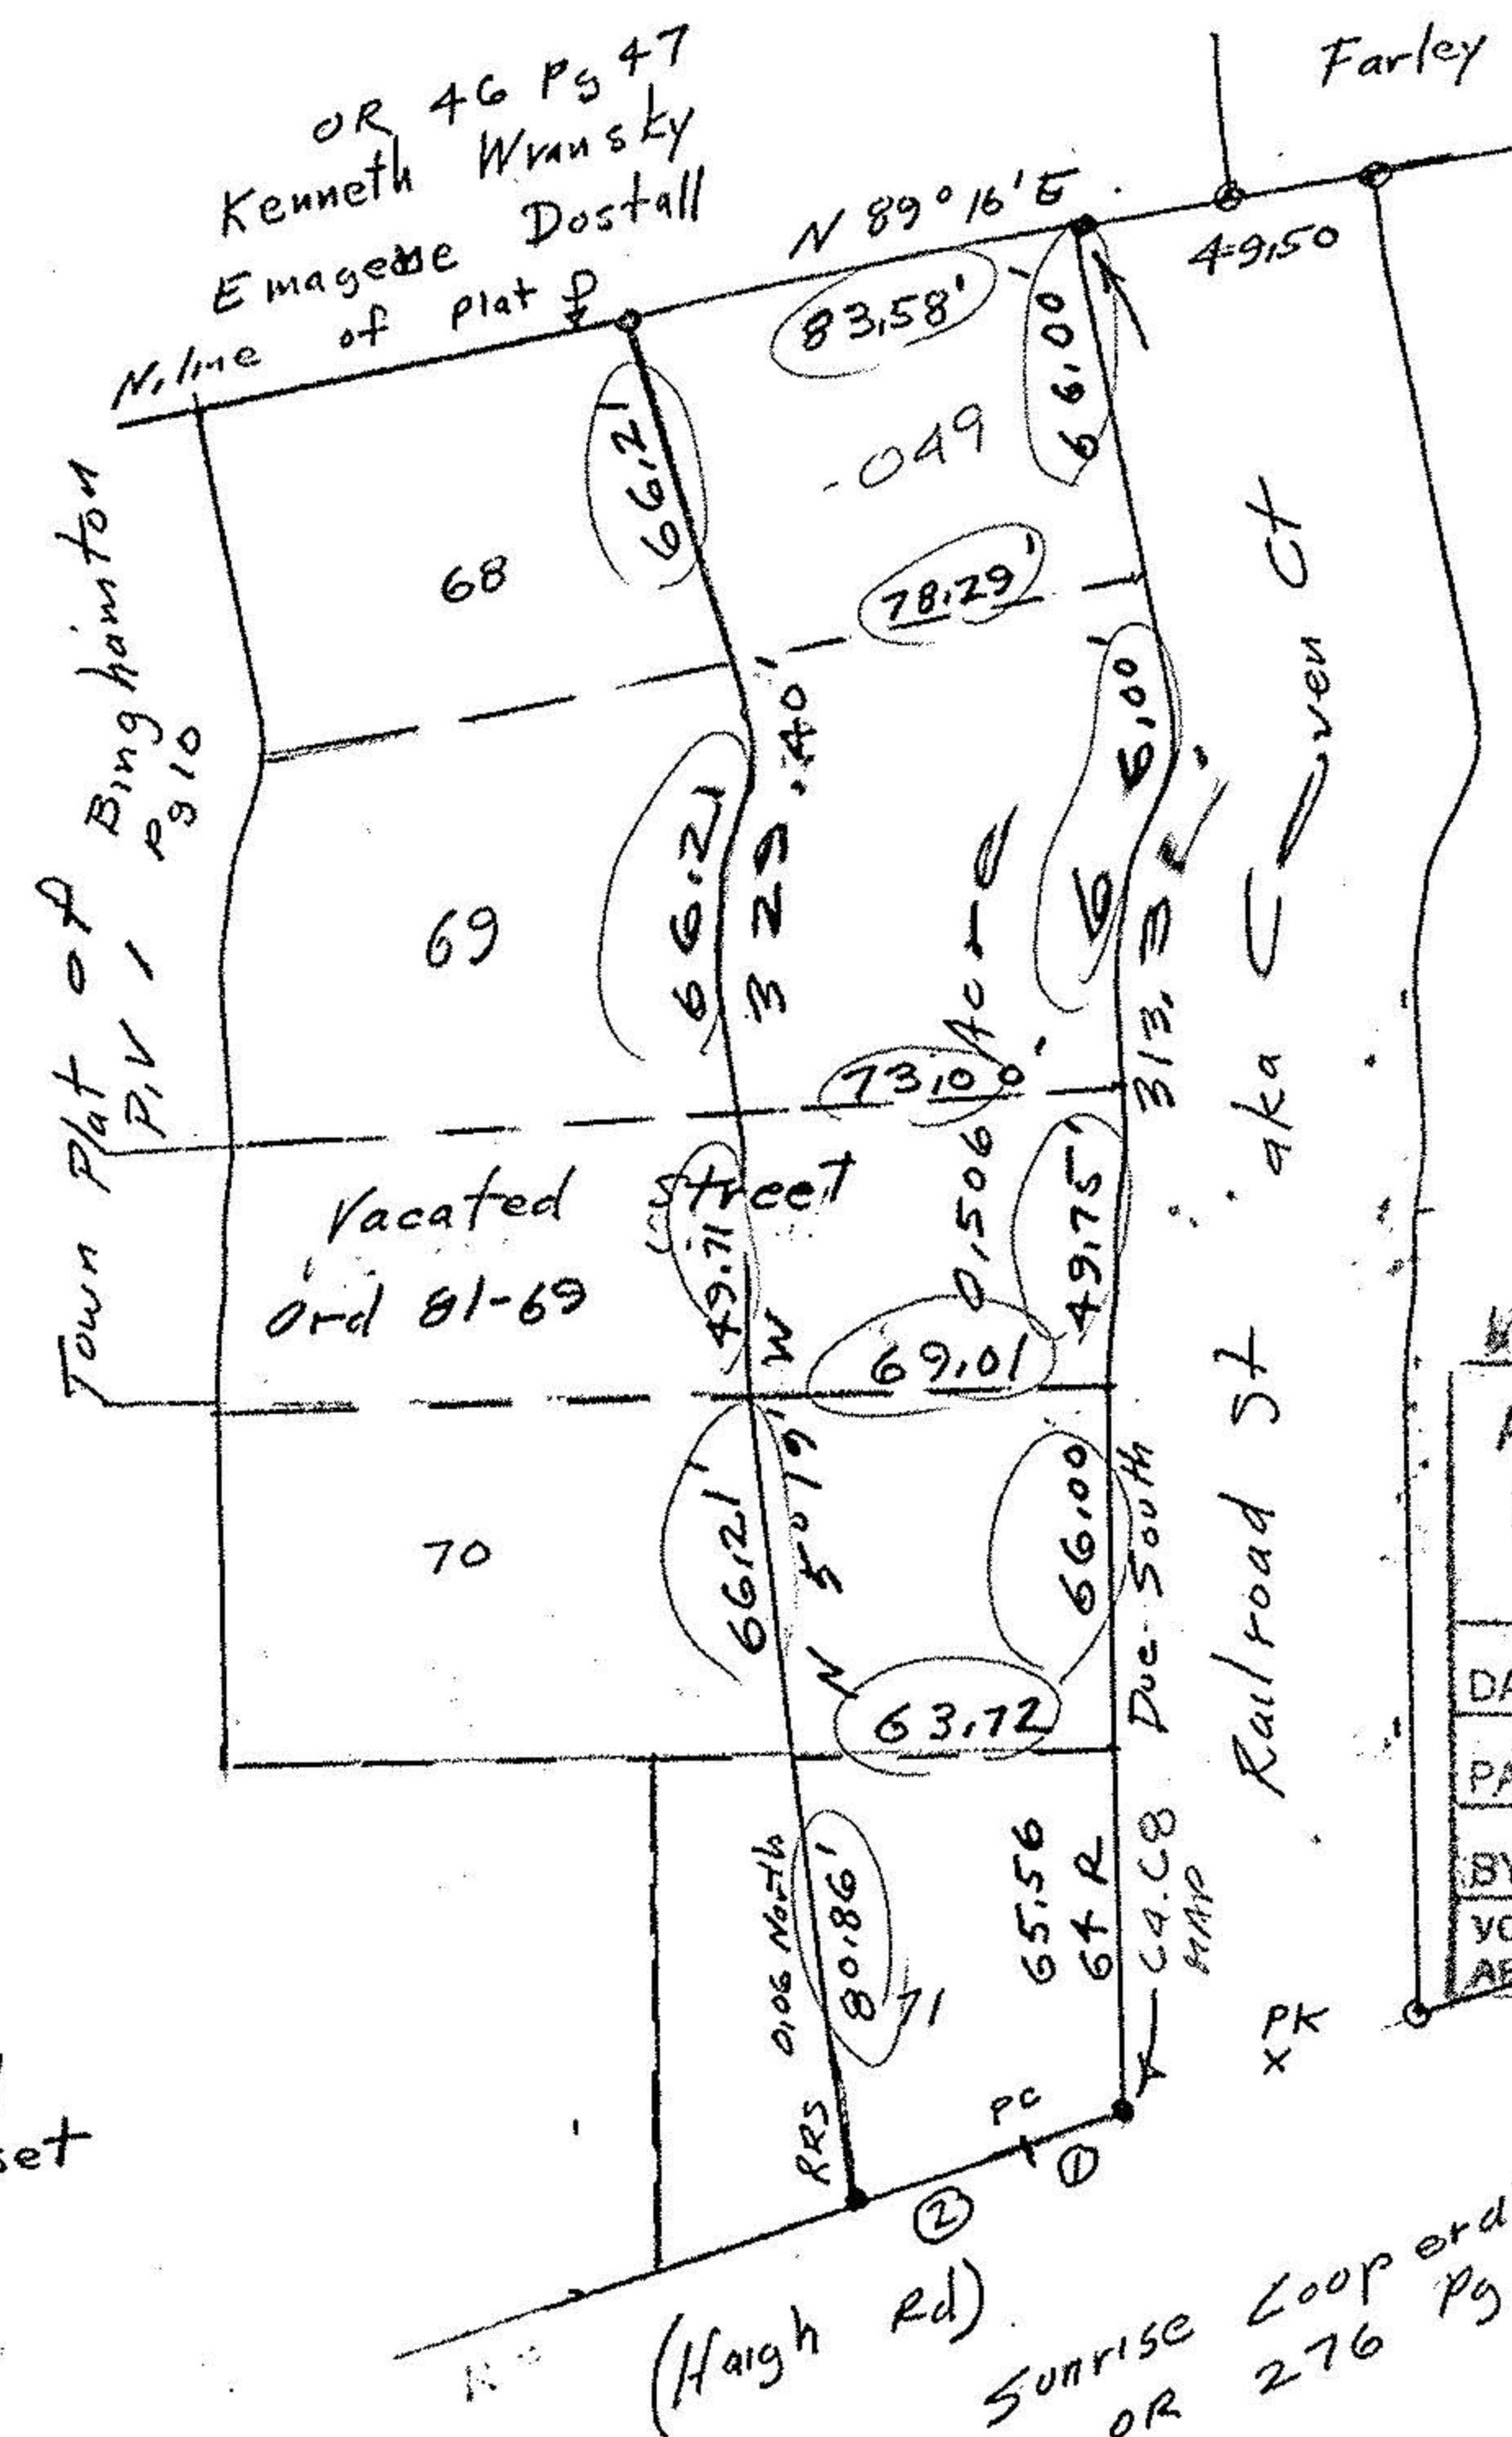

- o iron pipes fd
- iron pipes set
- x PK nail

① S 73° 32' W 18.00'


② S 73° 26' 34" W CB
 Arc 37.24'
 Ch 37.24
 R = 11,784.35'

John Pozywak
 Reg Surveyor
 5292

Survey of
 Parts of sublots 68, 69, 70, 71

Town Plat Binghamton
 P. Vol 1 Pg 10
 Tract 11 Original Lot 16
 Original Camden Townshd by
 Lorain County Ohio
 Scale 1" = 60' Nov 1992

Revised 3/4/93 subplot dimensions

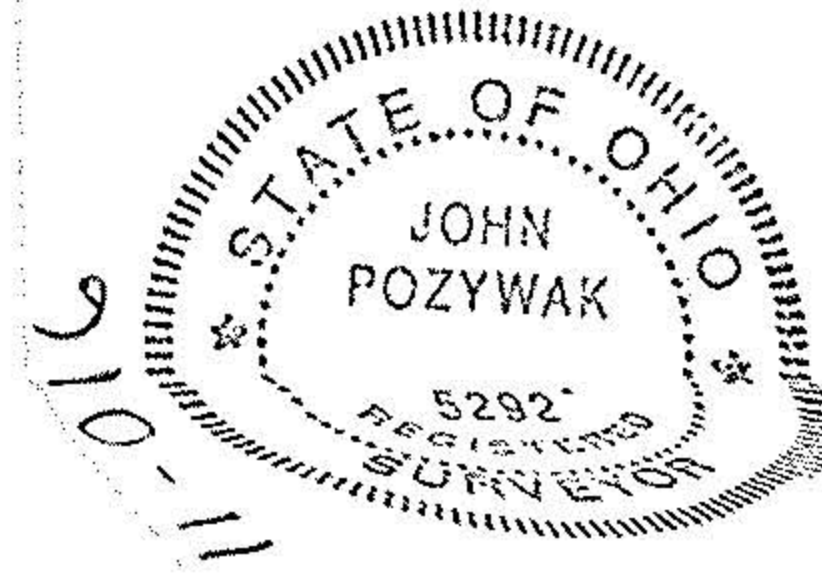

#20287

APPROVED
LORAIN CO. MAP DEPT.
DATE 3-16-93
PAGE 13-11-016
BY CAROLYN FRANCIS
VOID AFTER #20287