


285028#

DISTANCES MISSING X

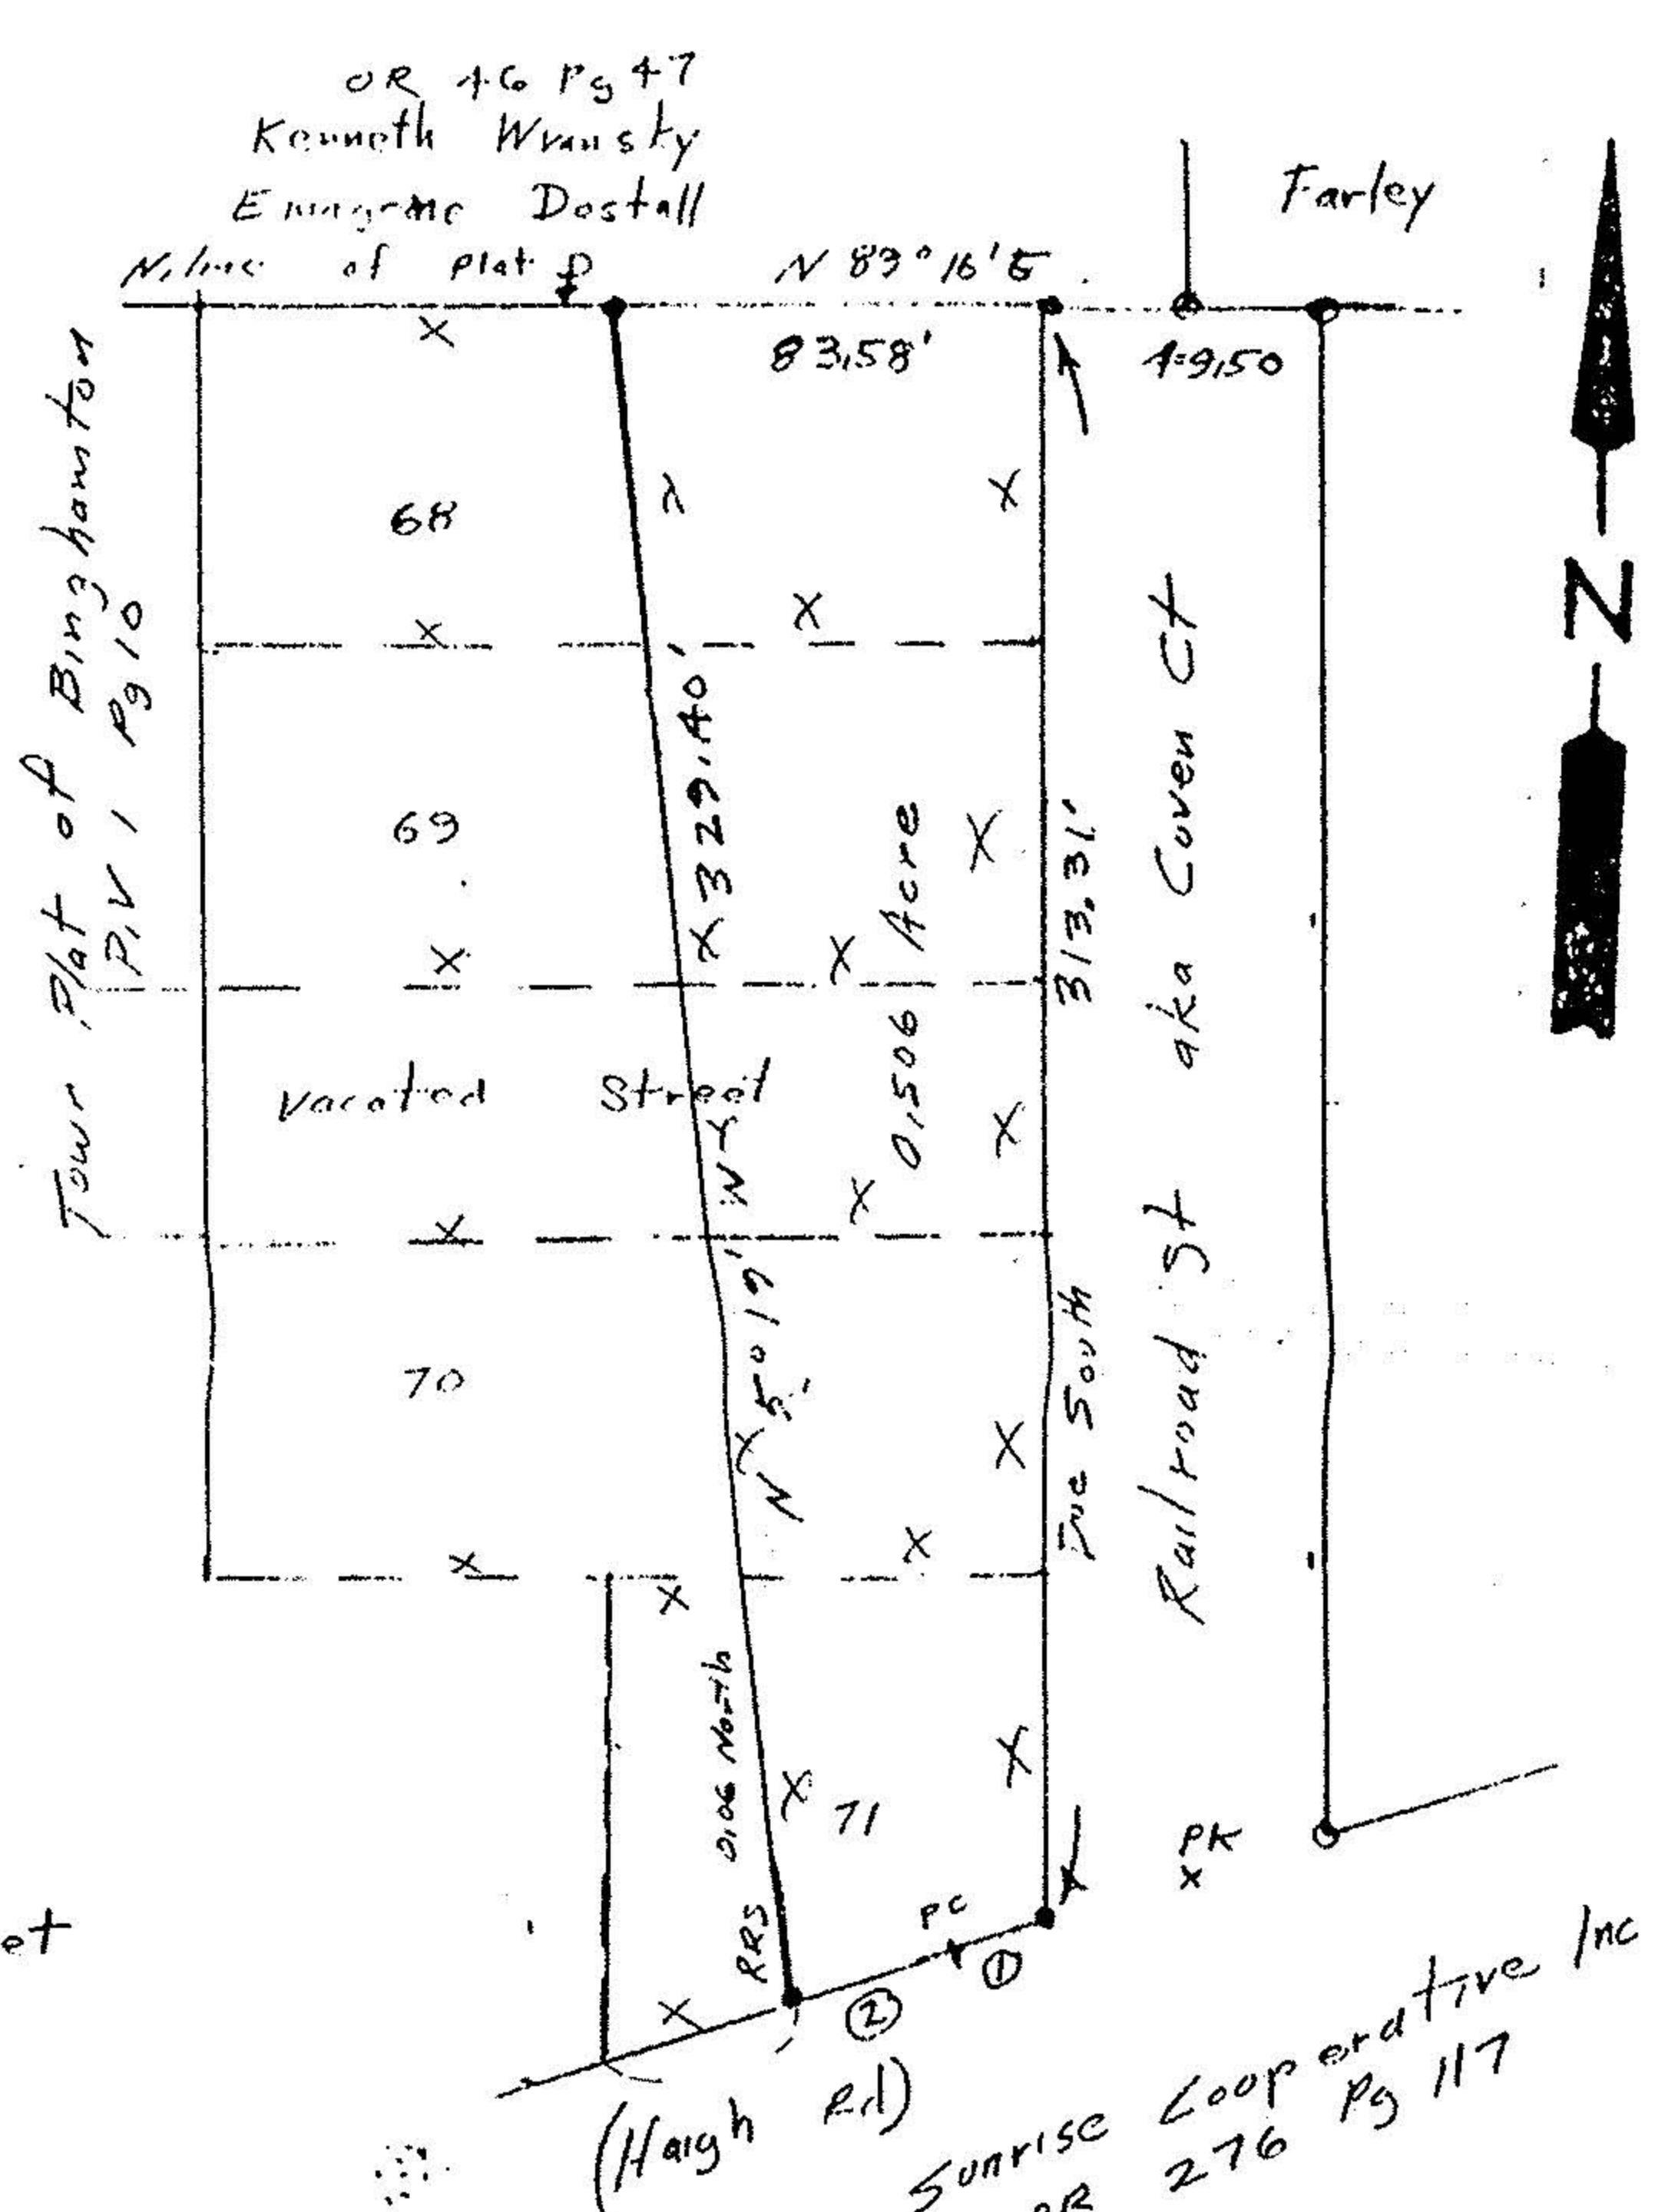


- o iron pipes fd
- iron pipes set
- x PK nail

- ① $S 73^{\circ} 32' W$ 18.00'
- ② $S 73^{\circ} 26' 34'' W$ CB
Arc 37.24'
Ch 37.24
 $R = 11,784.35'$

Sunrise Cooperative Inc
OR 276 Pg 117

Survey of
Parts of sublots 68, 69, 70, 71
Town Plat Binghamton
P. Vol 1 Pg 10
Tract 11 Original Lot 16
Original Camden Townsh
Lorain County Ohio
Scale 1"=60' Nov 1992

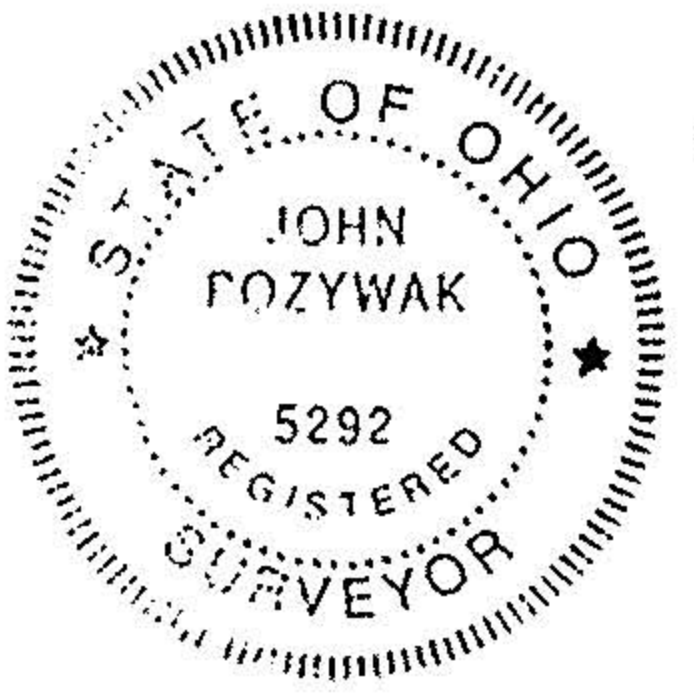


John Pozywak
Reg Surveyor
5292

13-11-016-

20287

016

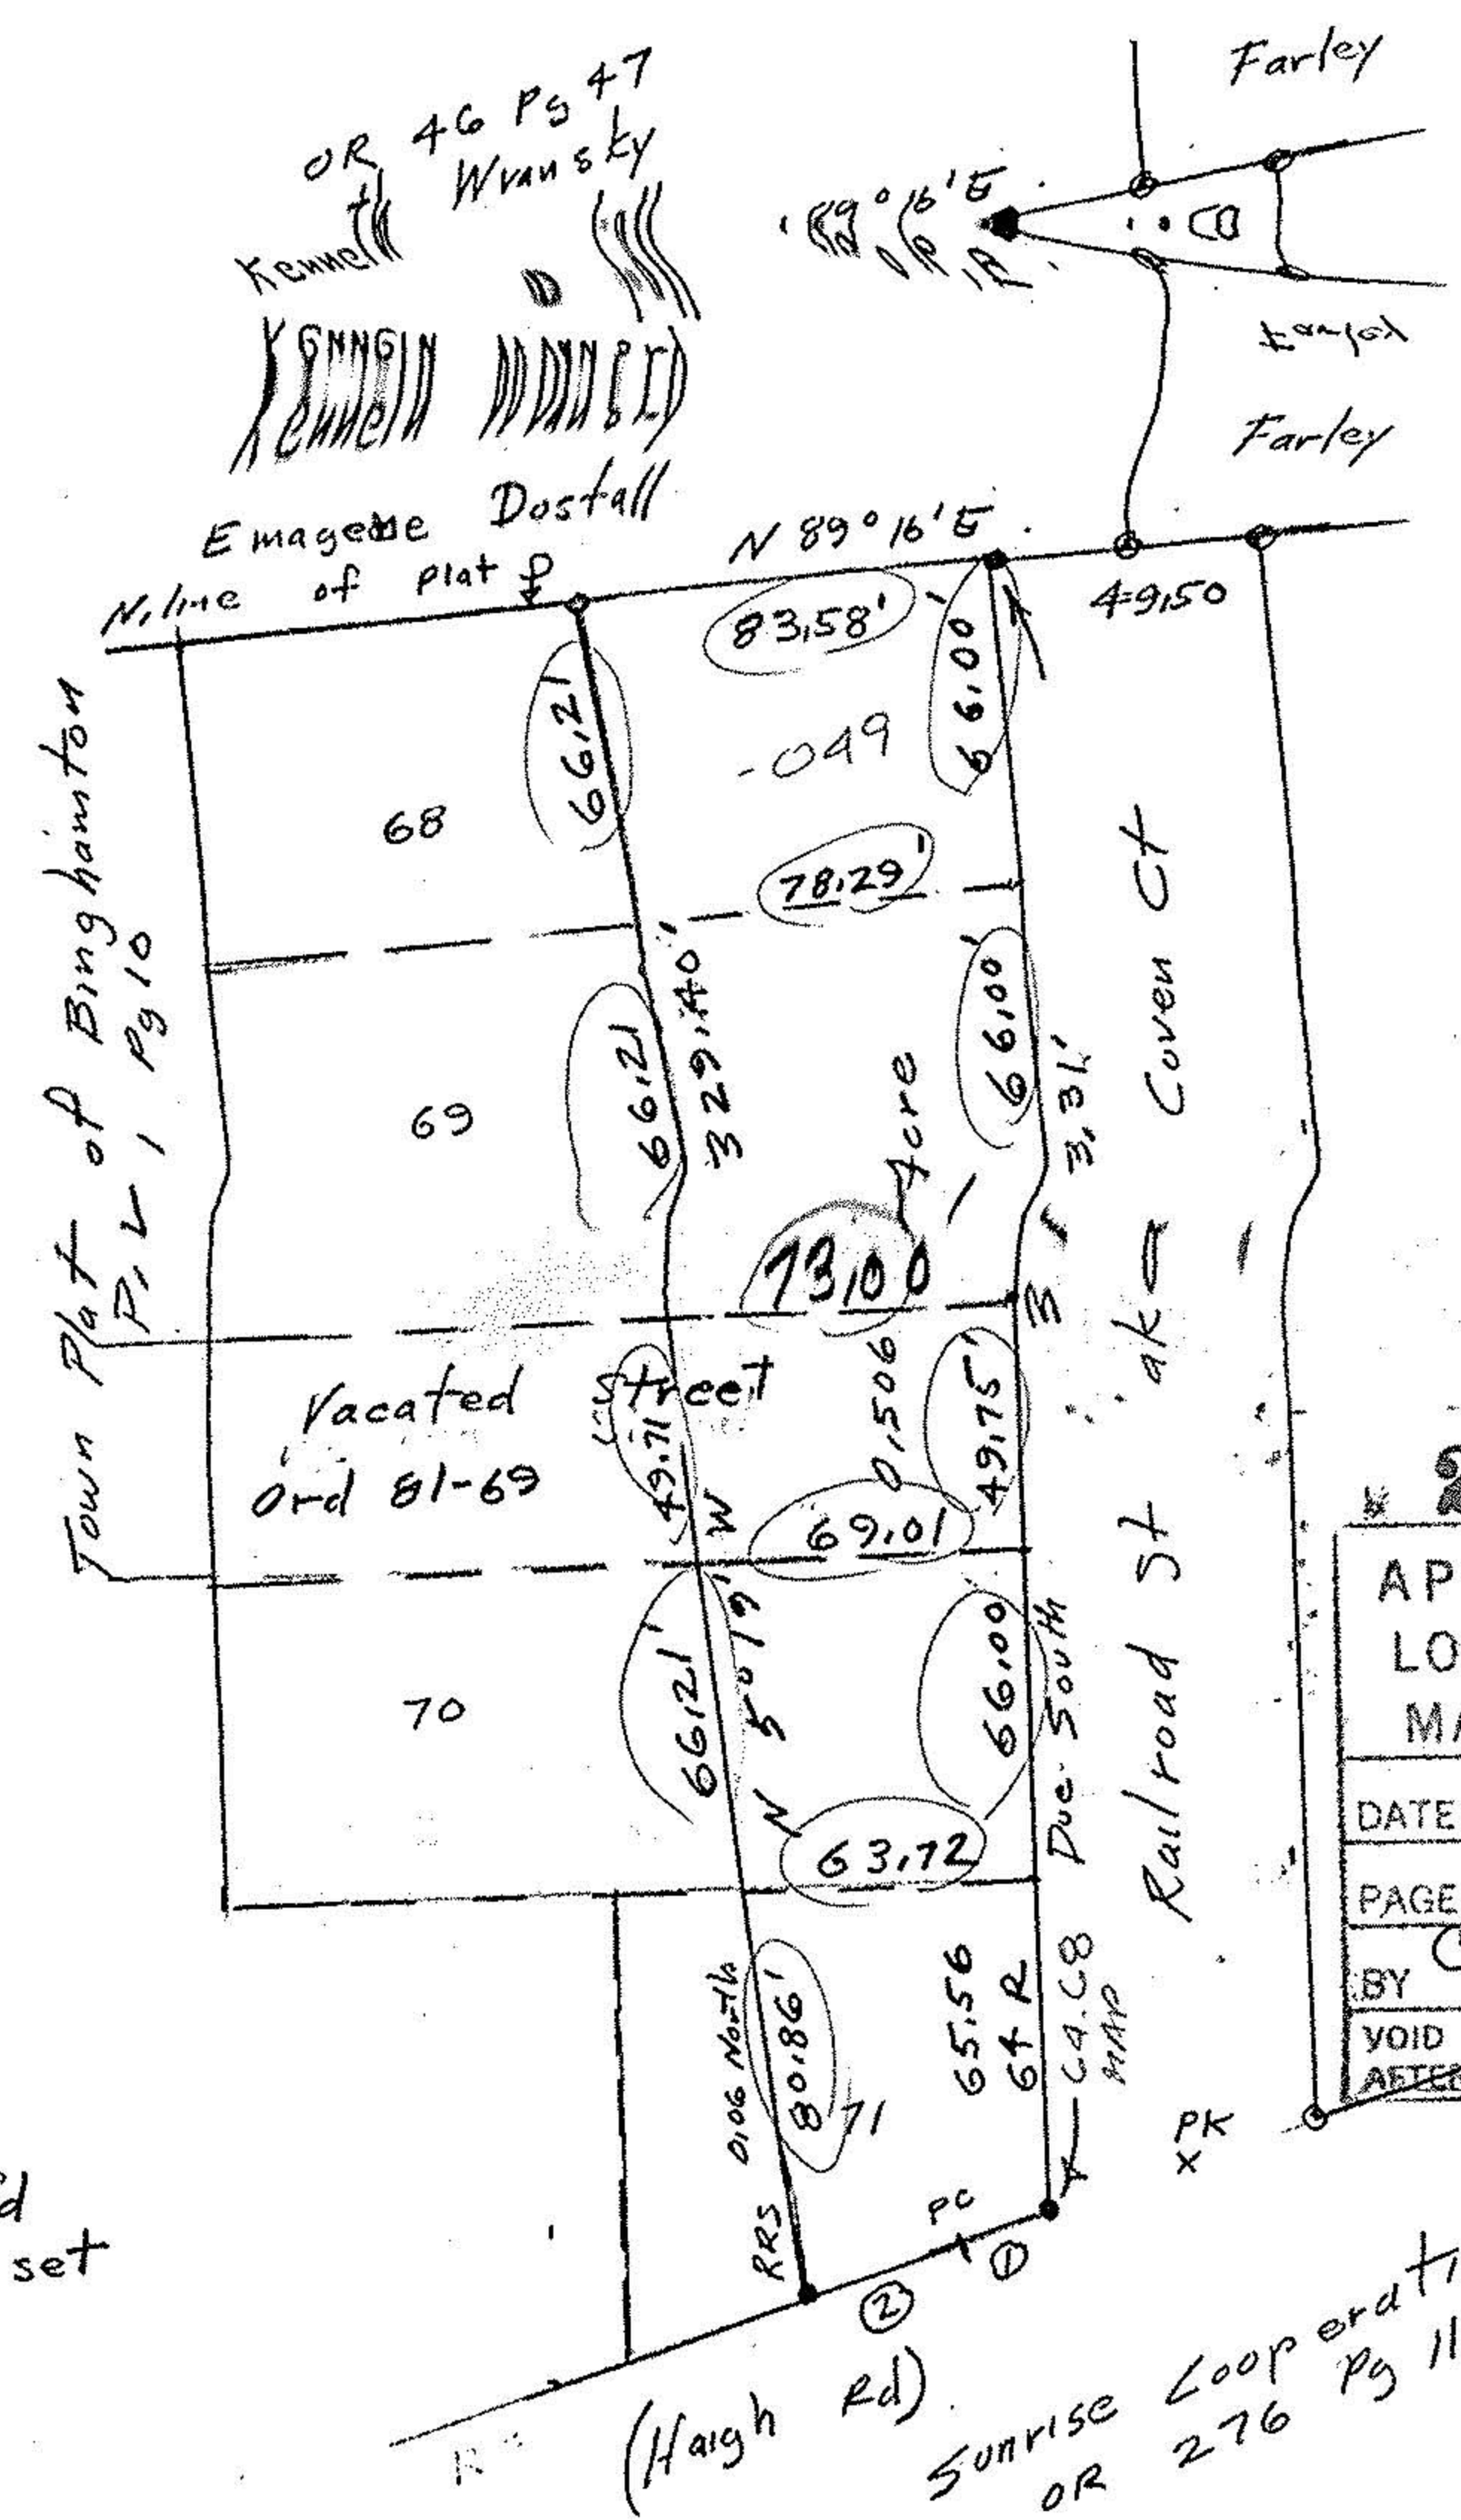


- o iron pipes fd
- iron pipes set
- x PK nail

- ① $S 73^{\circ} 32' W$ 18.00'
- ② $S 73^{\circ} 26' 34'' W$ CB
Arc 37.24'
Ch 37.24
 $R = 11,784.35'$

Sunrise Cooperative Inc
OR 276 Pg 117

Survey of
Parts of sublots 68, 69, 70, 71
Town Plat Binghamton
P. Vol 1 Pg 10

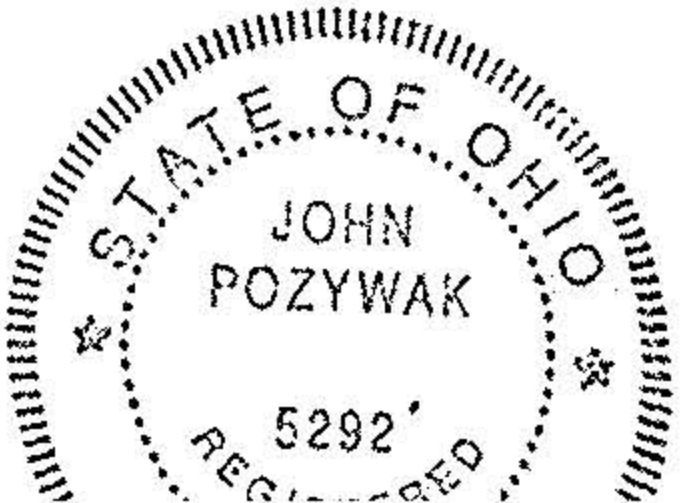

20287

APPROVED
LORAIN CO.
MAP DEPT.
DATE 3-16-93
PAGE 13-11-016
BY CAROLYN FRANCIS
VOID AFTER # 20287