



TOM ?
 • Combination
 DEED
 ONLY

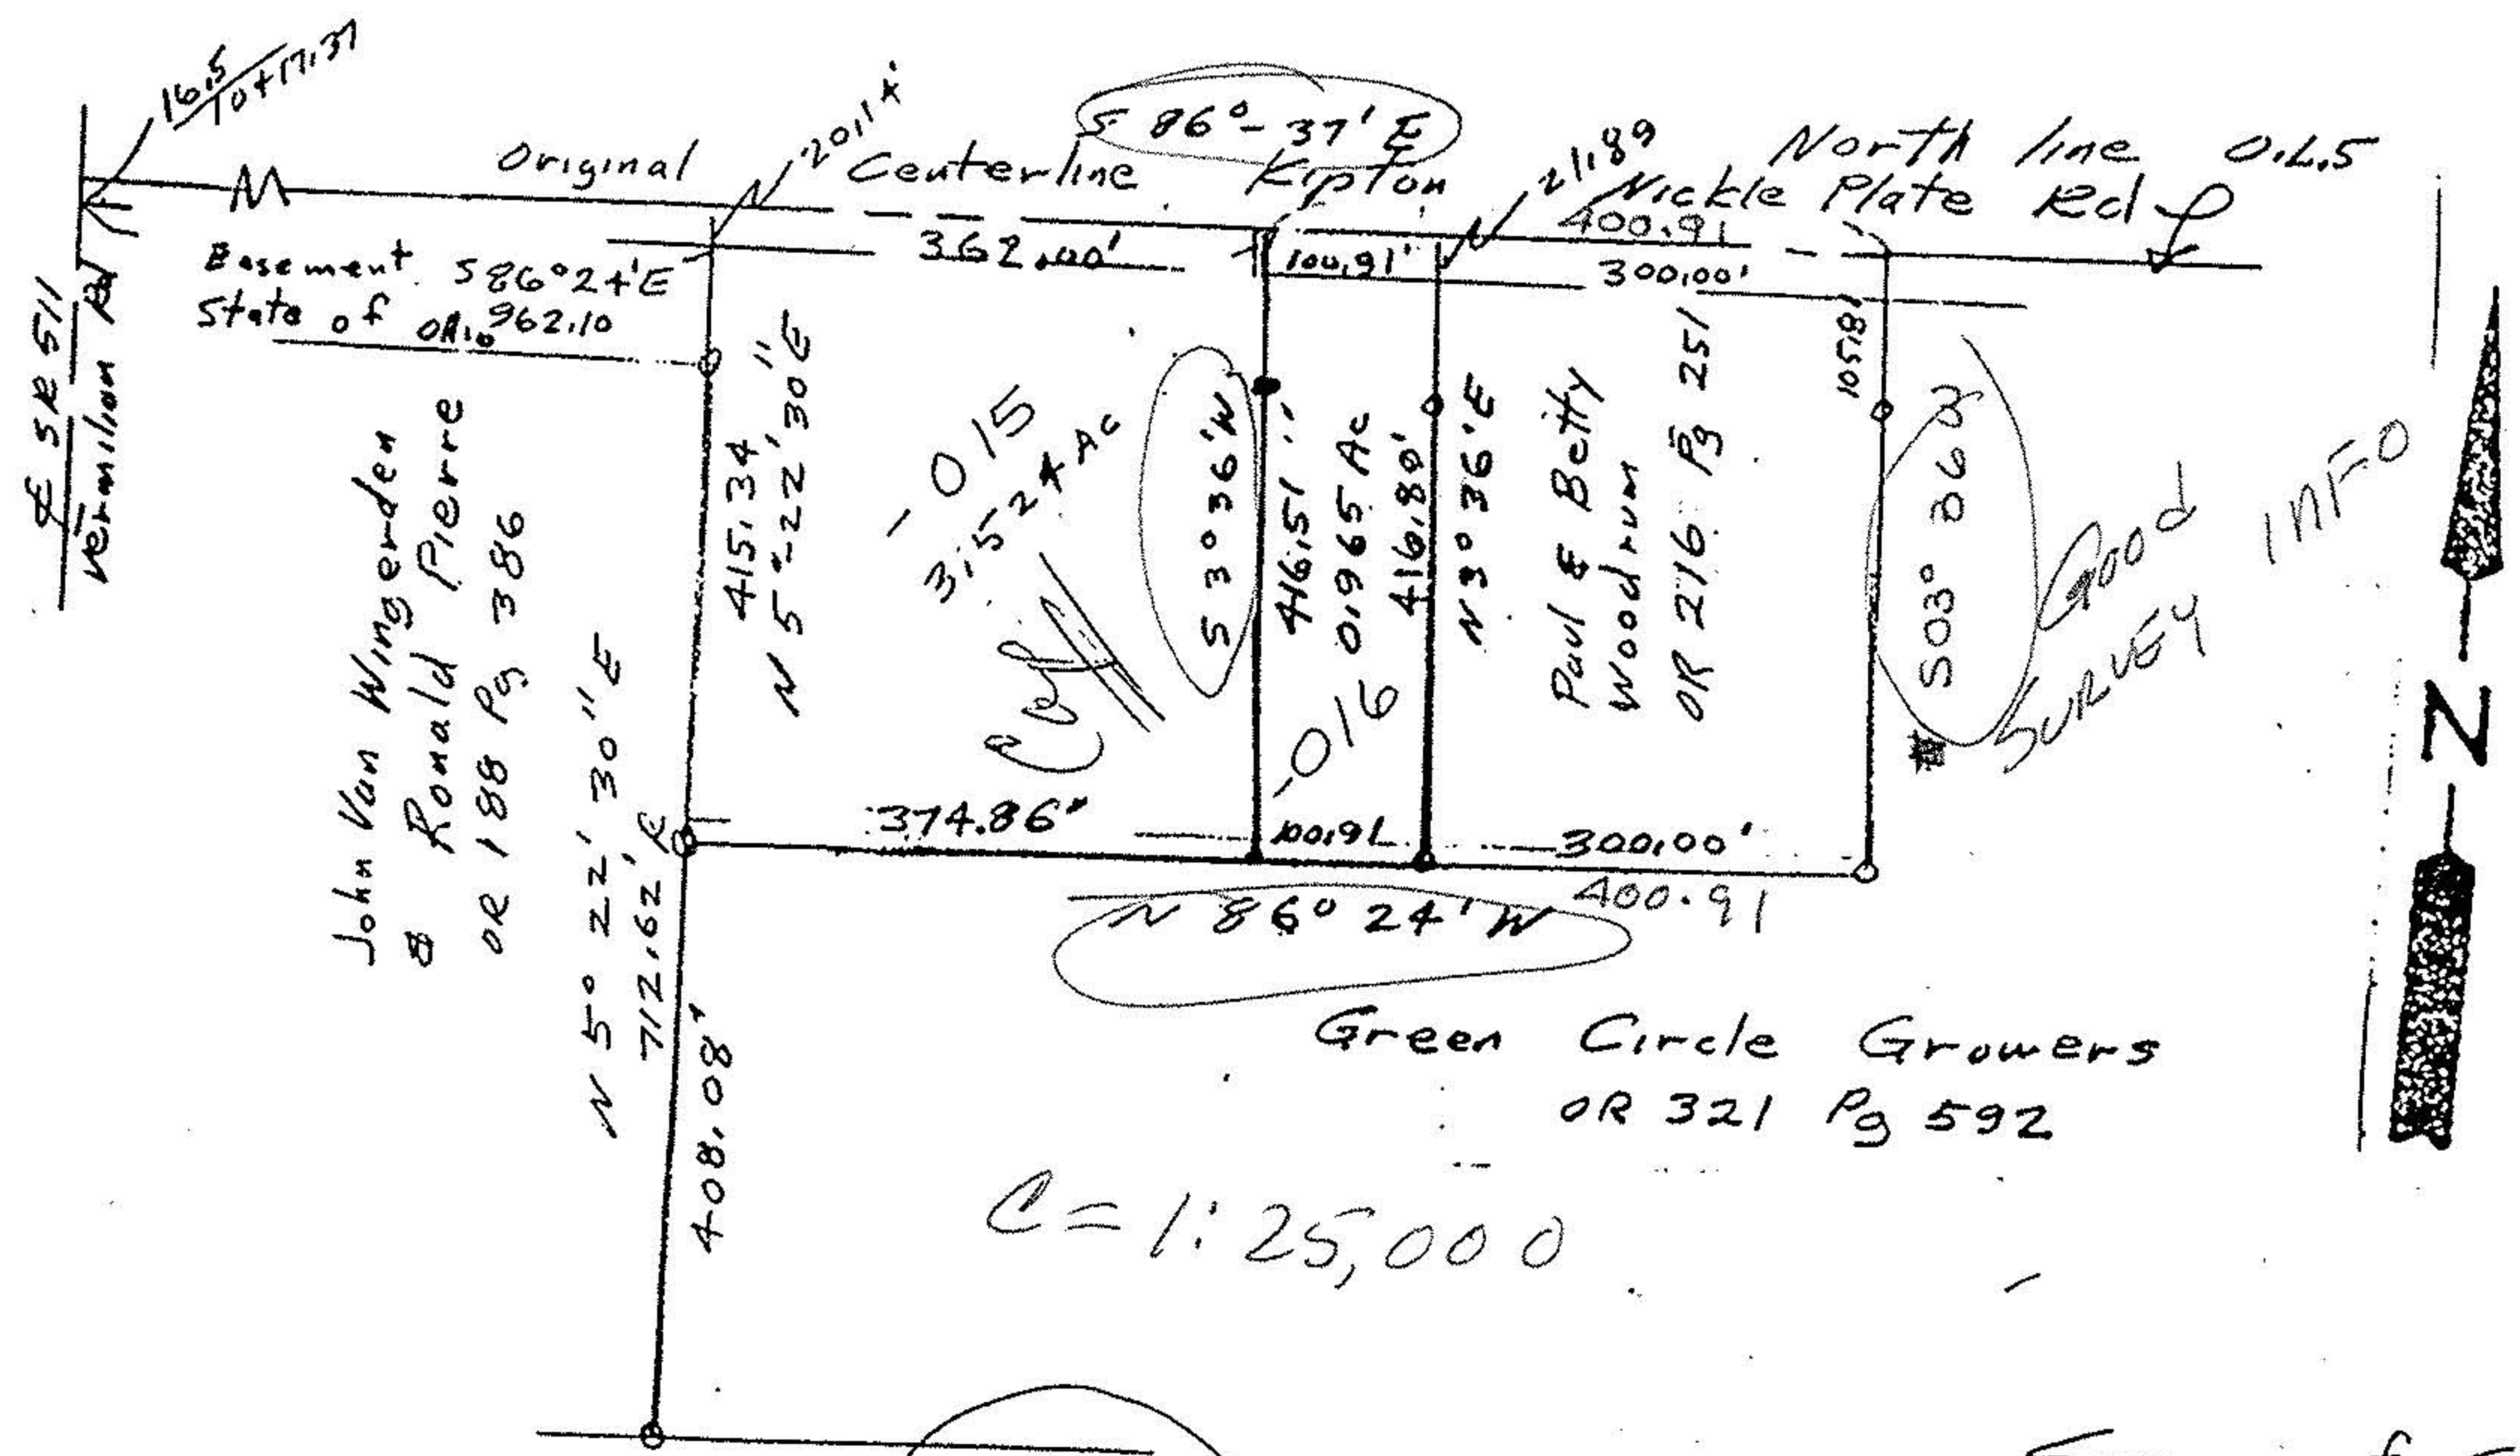

Div 296 Pg 612
 State of Ohio Easement
 2126 Acres
 Remainder

o iron pipes set
 • iron pins set
 John Pozywak
 Reg Surveyor

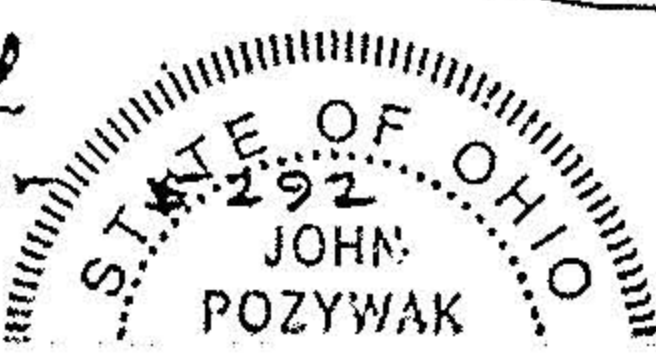

21670

APPROVED
 LORAIN CO.
 MAP DEPT

DATE

Survey of Survey Splits
 for Paul Woodrum
 Original Lot 5 Tract 10
 Camden Township
 Lorain County Ohio
 Scale 1" = 200' Dec 1995