
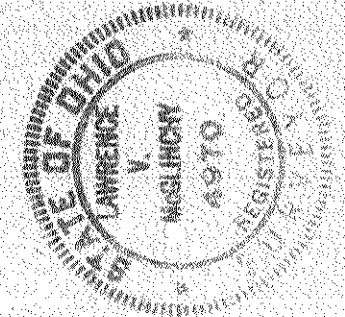


ANDREW J. CLARK  
VOL. 515,

ANDREW J. CLARK  
VOL. 515,

13-10-003-000-002  
005,006  
Z 015

13-B  
13-10-003

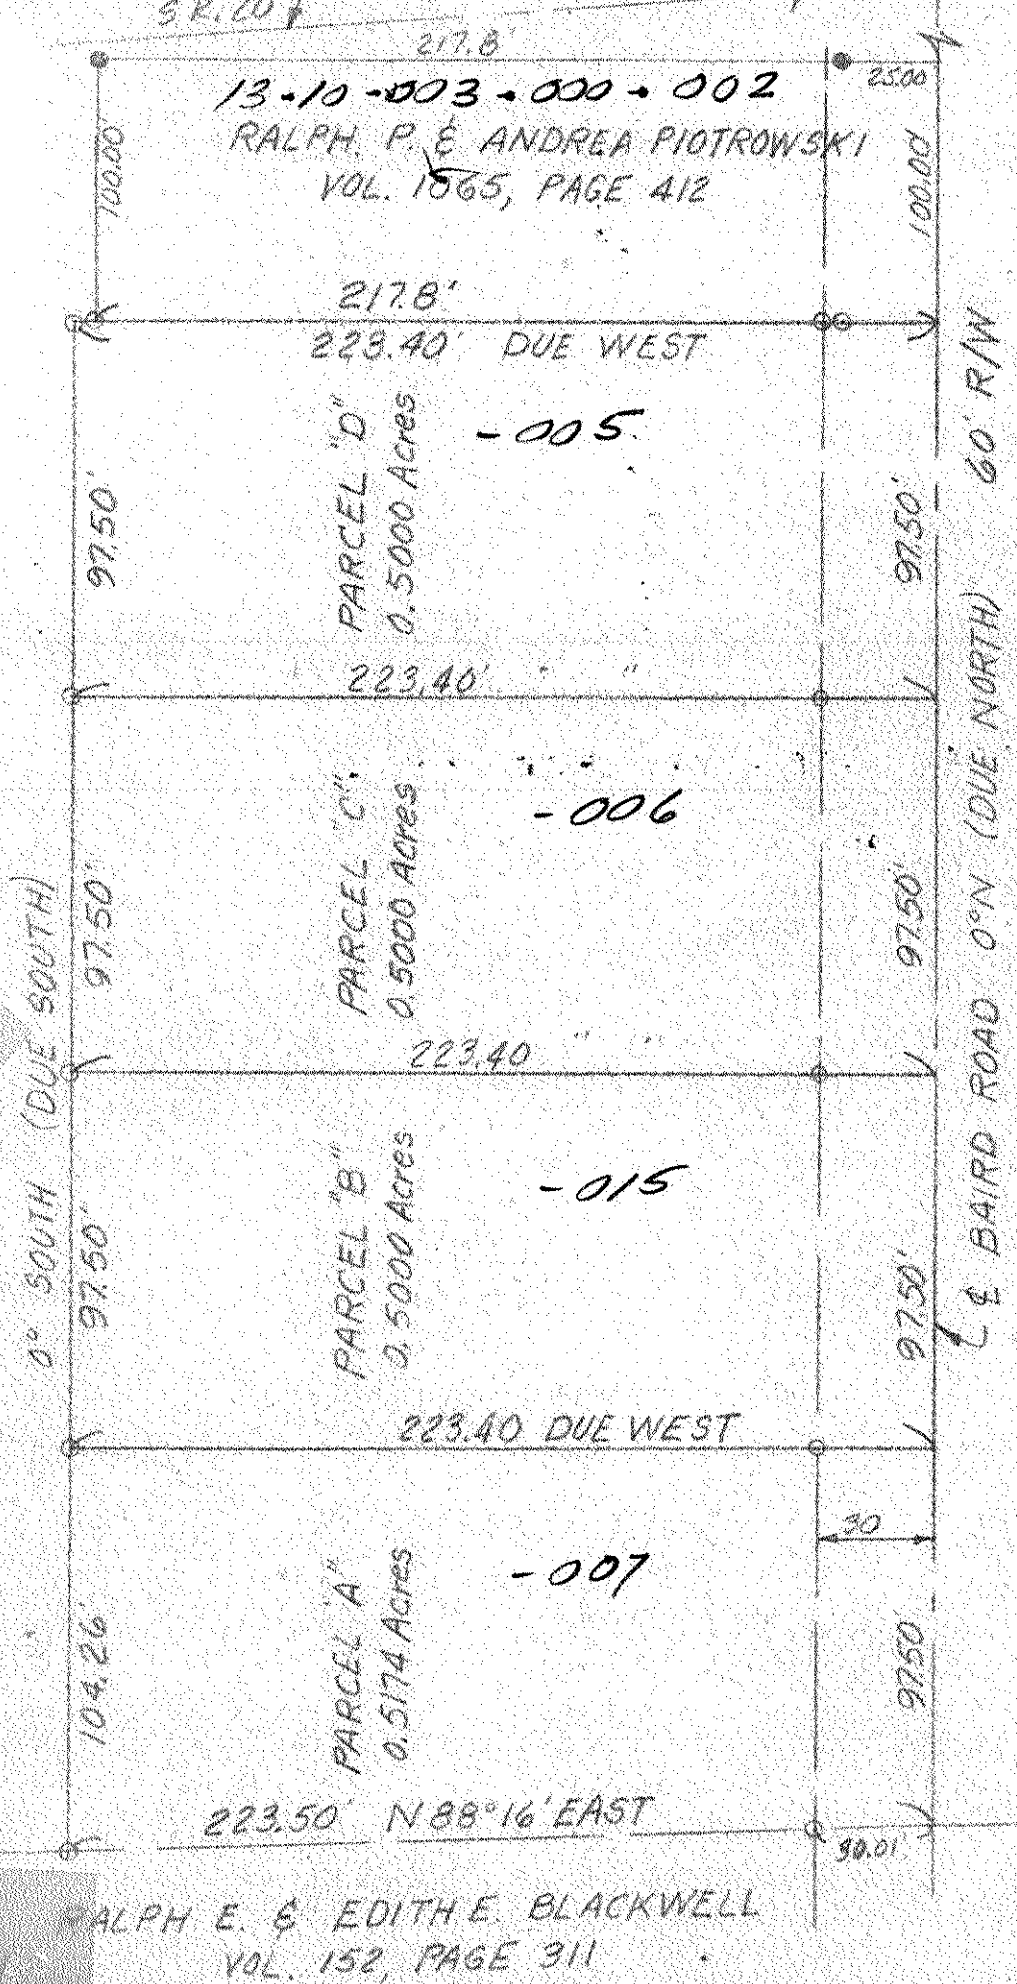

○ Iron Pipe Set  
● Iron Pipe Found

PLAT OF SURVEY FOR  
ANDREW J. CLARK  
O.L.S. TRACT 10, CAMDEN TWP  
LORAIN COUNTY, OHIO

MCGILINCHY & ASSOC.  
ELYRIA OHIO 44275  
11-50  
Job No. 75227