




Earl H. Hunter
July 21, 1994

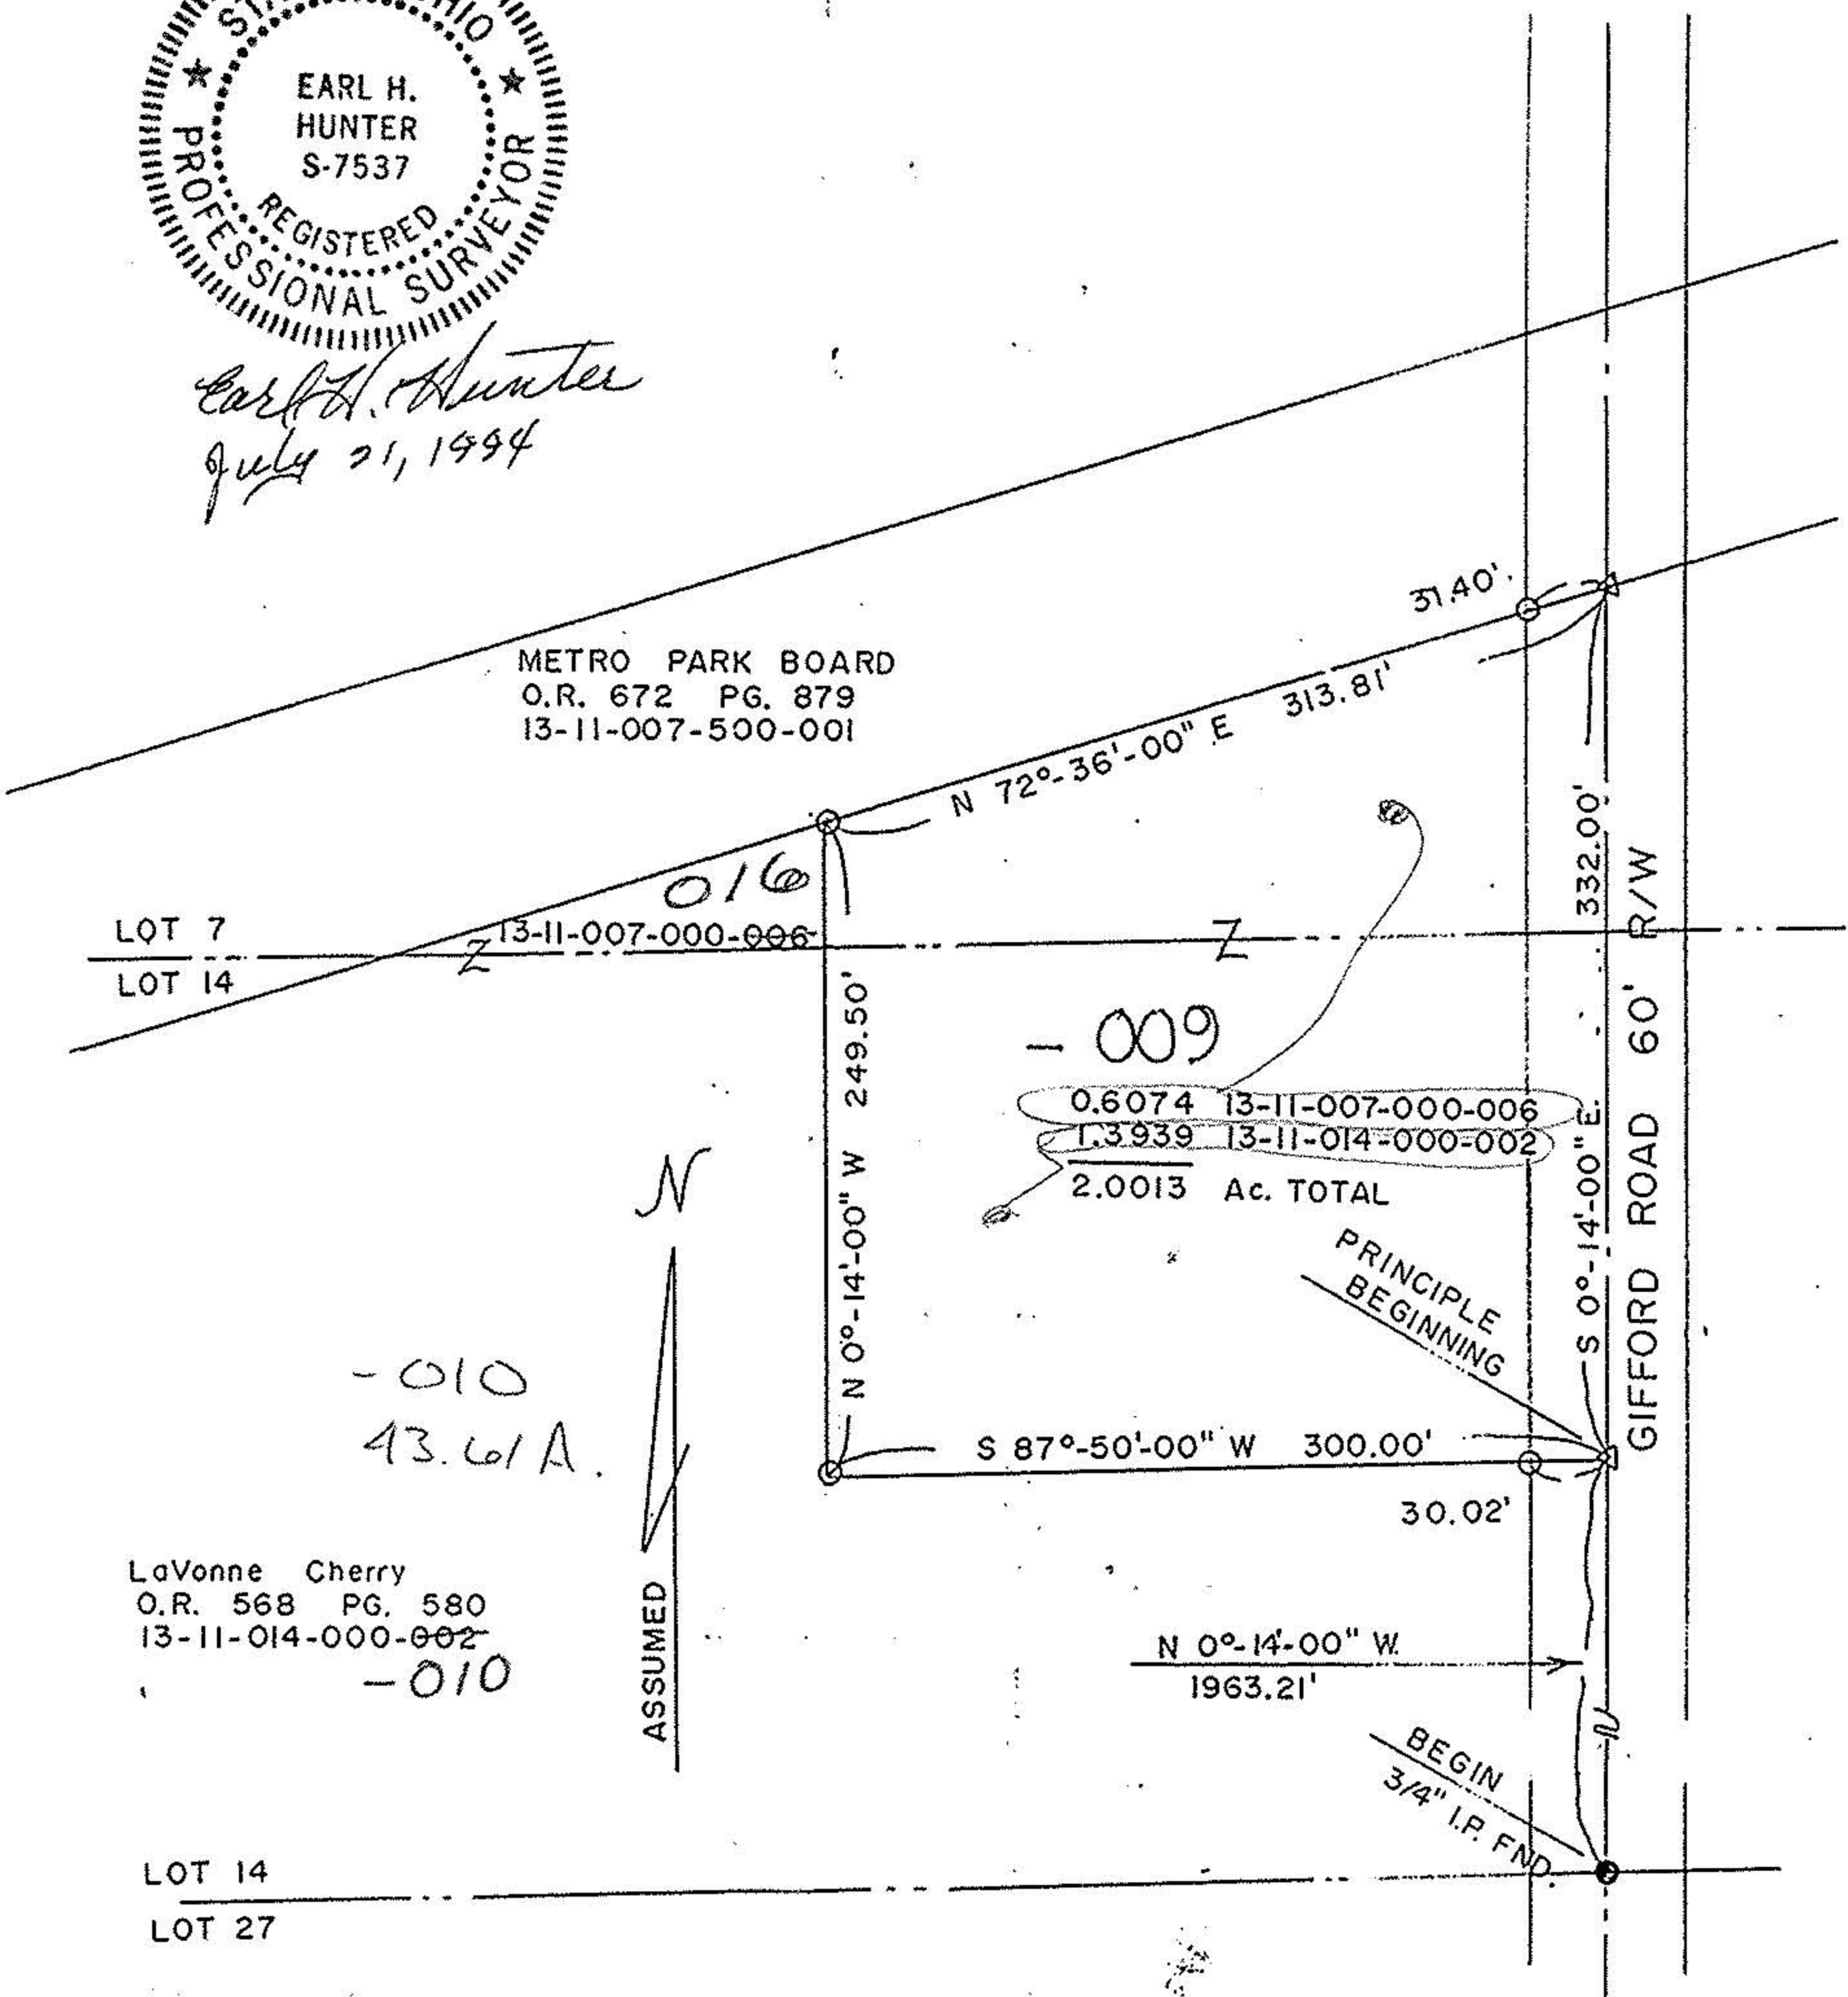

PLAT OF SURVEY FOR
MR. DAVID WALKER
OF PART OF LANDS OWNED BY
MRS. LaVONNE CHERRY

BEING PART OF
ORIGINAL LOTS 7 & 14,
TRACT 11
CAMDEN TOWNSHIP,
LORAIN COUNTY,
OHIO.



GRAPHIC SCALE E.C. 1 IN 10,000+

SCALE 1" = 100'

APRIL 25, 1994

20955

APPROVED LORAIN CO. MAP DEPT
DATE 7-21-94
PAGE 13-0
BY CAROLYN FRANCIS
#20955

ALL BEARINGS ARE TO AN ASSUMED
MERIDEAN FOR DESCRIPTION.

LEGEND:

- IRON PIN FOUND
- 3/4" DIA. IRON BAR SET
- ▲ SPIKE FOUND
- △ P.K. NAIL SET

EARL H. HUNTER, P.S.
1503 SANFORD STREET
VERMILION, OHIO 44089
(216) 967-2037