


PLAT OF SURVEYS FOR  
MARY T. TELENKO

ORIGINAL LOT 31 - TRACT NO. 9  
CAMDEN TWP. - LORAIN COUNTY - OHIO  
SCALE: 1" = 100' OCTOBER 27-1976  
Gary E. Penfound - Reg. Surveyor No. 4457

Stone Mon. Fd.  
**BRONSON ROAD**

NOTES: ○ indicates iron pin set  
set Nov. - 1966.  
● indicates iron pin set  
1975 or Oct. 27-1976.

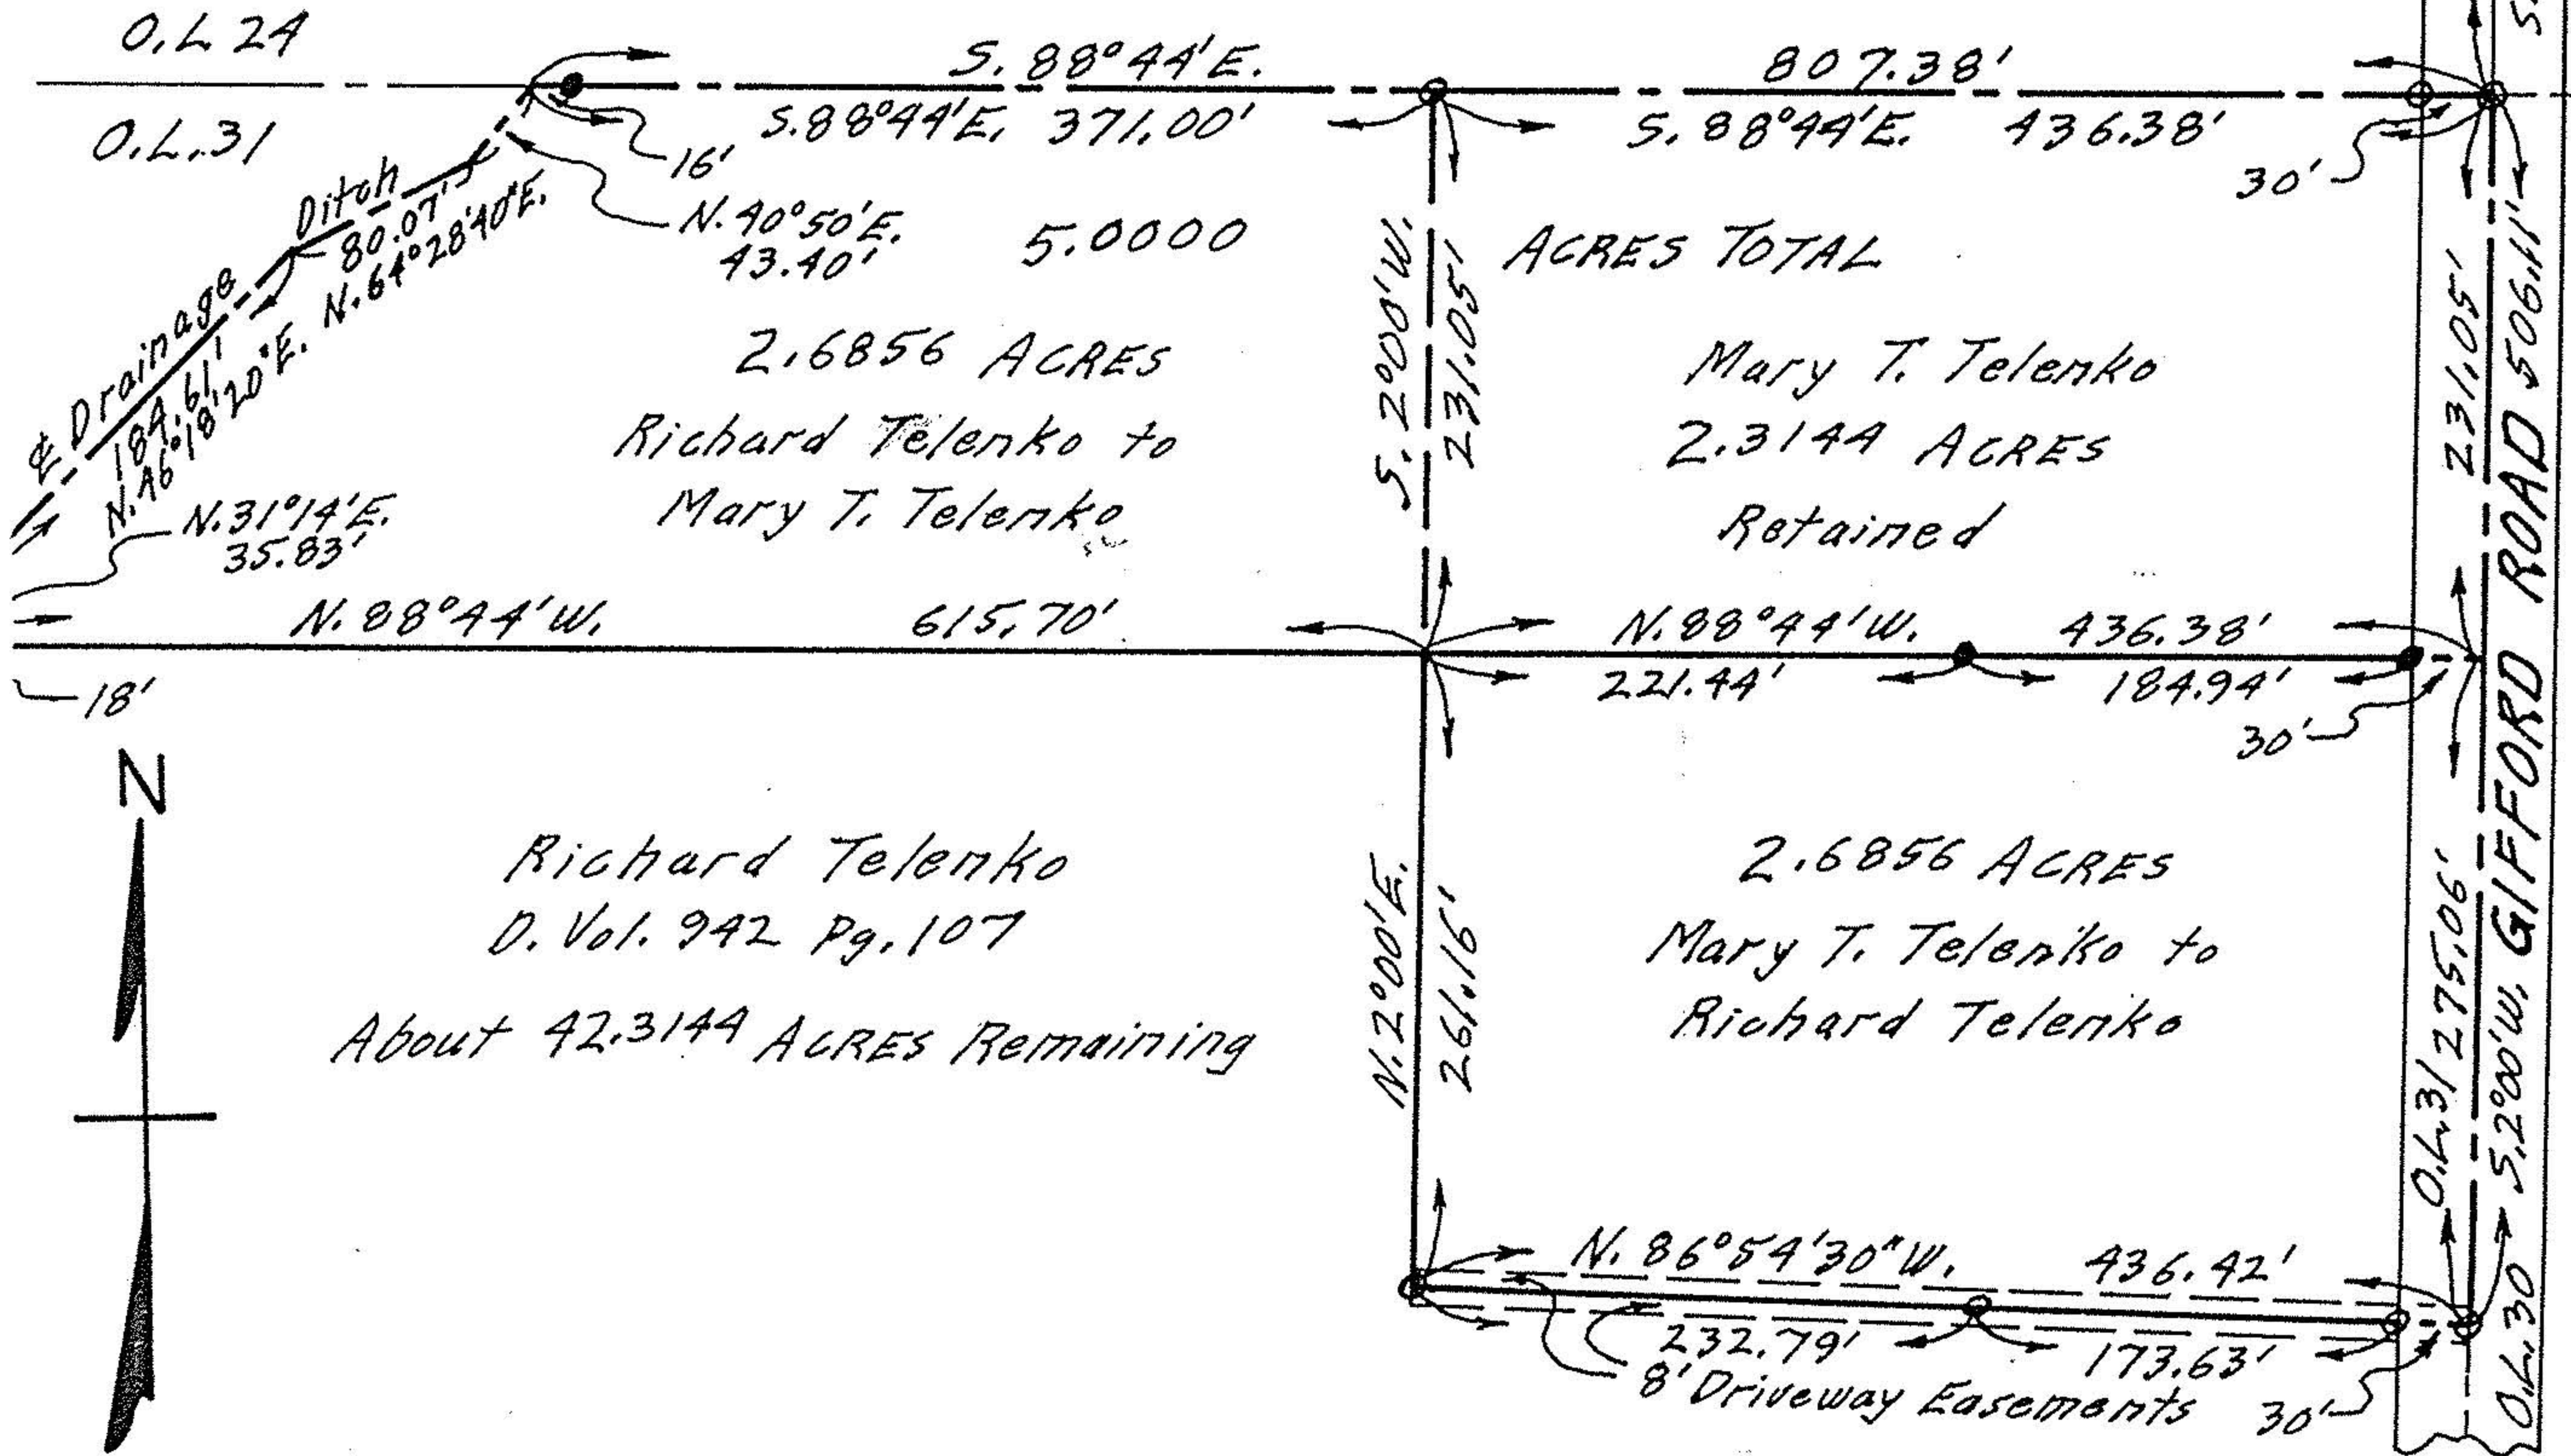

ACRES TOTAL  
Mary T. Telenko  
2.3144 ACRES  
Retained

Richard Telenko  
D. Vol. 942 Pg. 107  
About 42.3144 ACRES Remaining

2.6856 ACRES  
Mary T. Telenko to  
Richard Telenko