


GOKE-ORPHANAGE RD.

BATES RD. 60'

BAIRO RD.

M.B./I.P. Used

M.B./I.P. Used

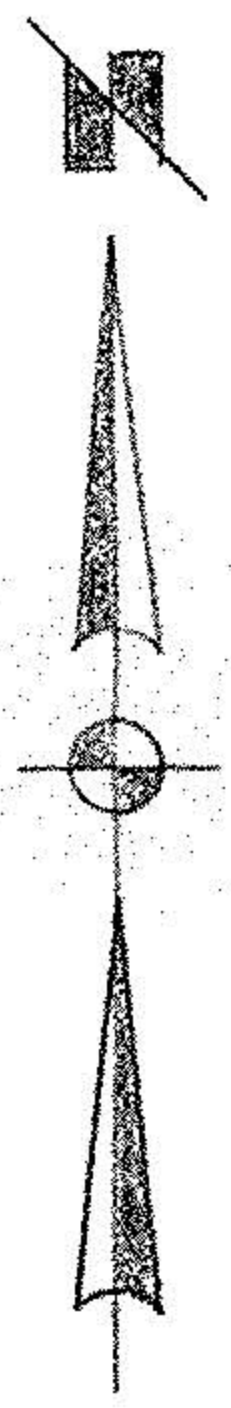

741.92 Rec. & Used

5.89° 50' 15" E. 2497.32 Meas.

I.P. Set 300.01' E

I.P. Set 300.01' E

5.1° 28' 13" E. 436.23 Meas. 435.62 Rec.

CLARENCE C. JR. & HELEN BELCORE
D.V. 1025 P. 581

436.23 Meas.

N. 1° 28' 13" W. 644.47 Meas. 643.81 Rec.

6.89° 50' 15" E. 200.00

I.P. Fd. - Used

JOSEPH C. CARVER
D.V. 1252 P. 618

827.10' E

- 024

① 2.3038 Ac.

I.P. Fd. 643.51' E Rec.

1326.25' E

ANGELINA E. SCAKACS
O.R.V. 307 P. 321

20819 R.E.M.

194.16

I.P. Fd.

I.P. Set

225.59
7.87° 25' 55" W.

I.P. Set

I.P. Fd.

497.15

- 023

② 4.9995 Ac.

RUSSELL R. & SANORA A. BROWN
D.V. 1192 P. 529

210 Rec.

697.02'

N. 1° 29' 37" W. 891.18

N. 87° 27' 55" W.

I.P. Fd.

308.15 Meas. 304.27 Rec.

I.P. Fd.

0.18 S. of Cor

LESLIE D. & TRUETTA W. EALY
O.R.V. 35 P. 477

6.1° 29' 00" E.
200.00 R.E.M.

I.P. Fd.

530.96 Meas. 531.16 Rec.

Re-bar Fd. Bent Used

GEORGE J. SPRINGER D.V. 1246 P. 311


SURVEY FOR

CLARENCE C. JR. & HELEN BELCORE

PART OF O.L. 2 TRACT No. 11
COUNTY OF LORAIN
SCALE 1"=100'

TOWNSHIP OF CAMDEN
STATE OF OHIO
OCT. 1995

LAUNDON • SIMON • CAHL & ASSOC.
PROFESSIONAL LAND SURVEYORS
JOB No. 95-2784

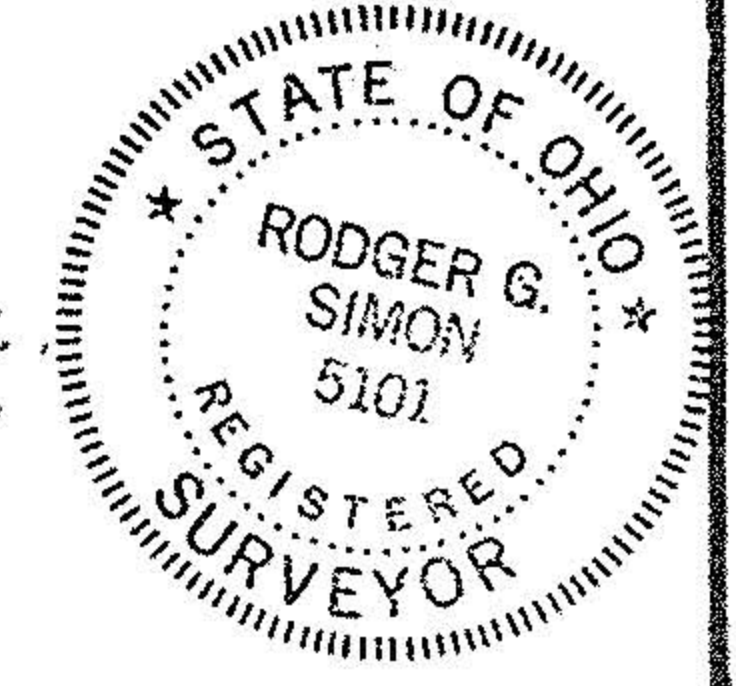

13-11-002-000-