


13-G

13-G

PLAT OF SURVEY  
O.L.S., TRACT 8, CAMDEN TWP.  
LORAIN CO., OHIO SCALE: 1"=200'  
NOV. 1977 JOB NO. 77-159

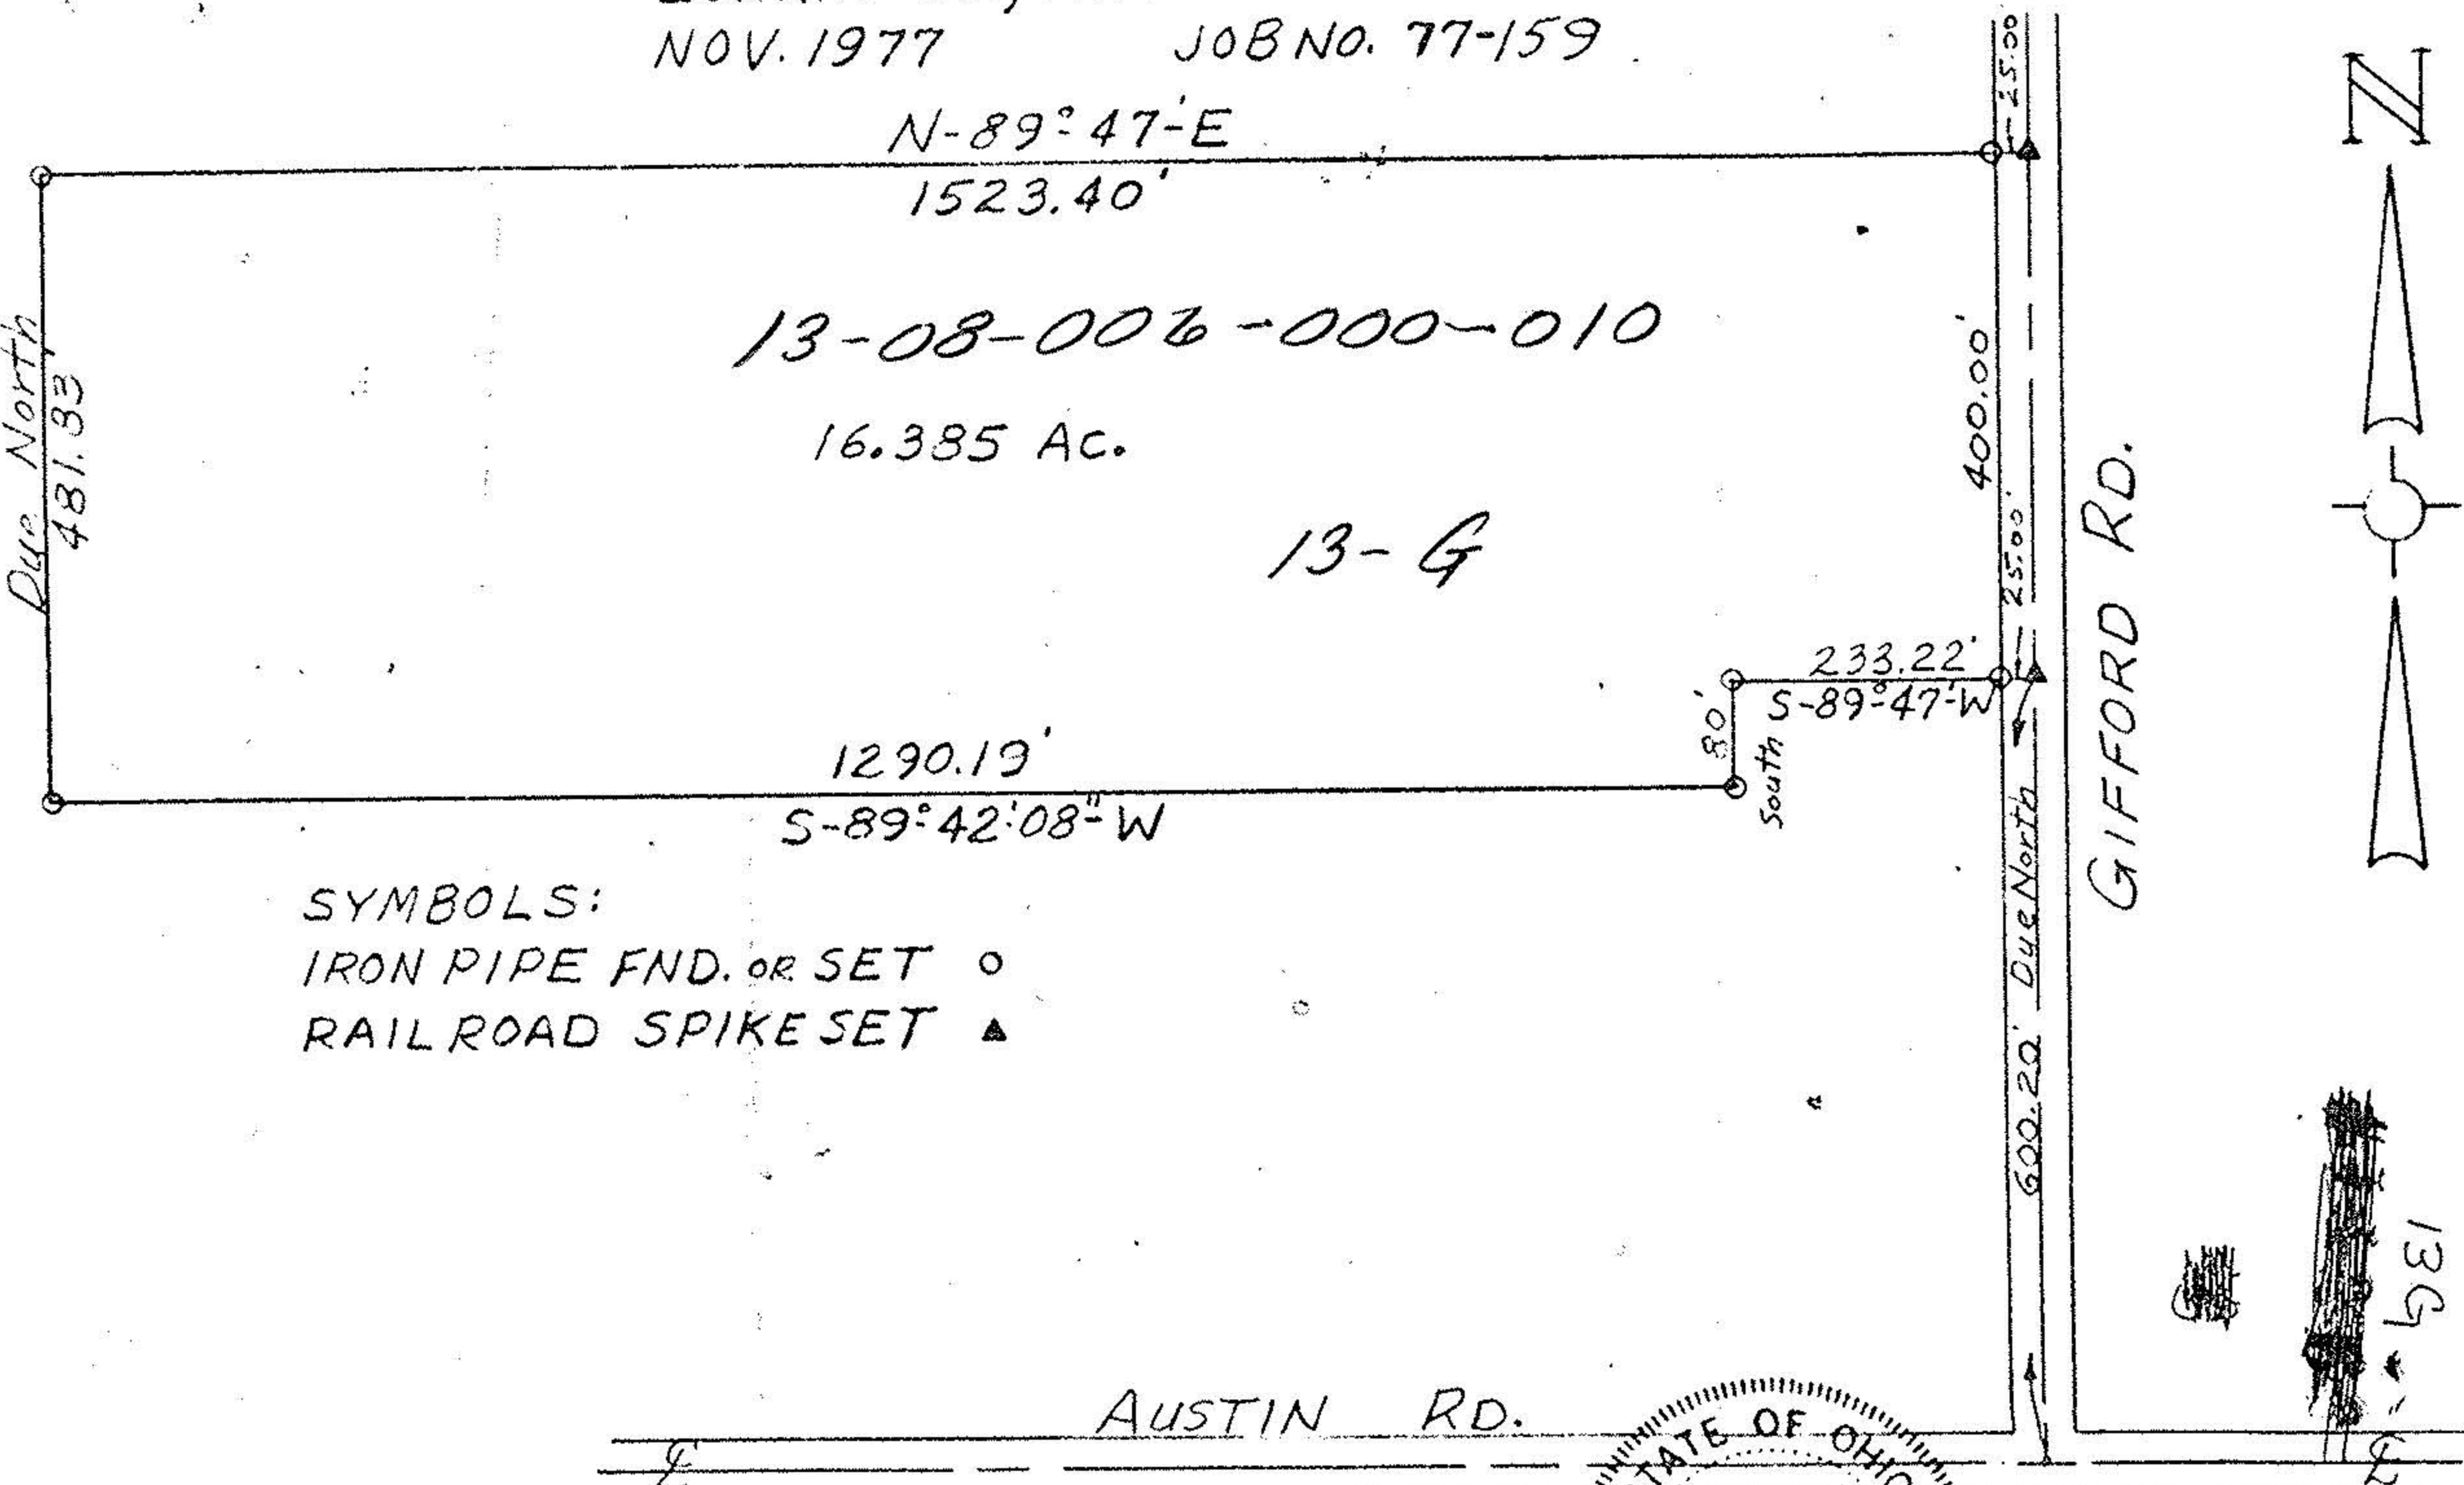

13-08-006-000-010


16.385 Ac.

13-G

SYMBOLS:  
IRON PIPE FND. OR SET ○  
RAILROAD SPIKE SET ▲


GIFFORD RD.

AUSTIN RD.

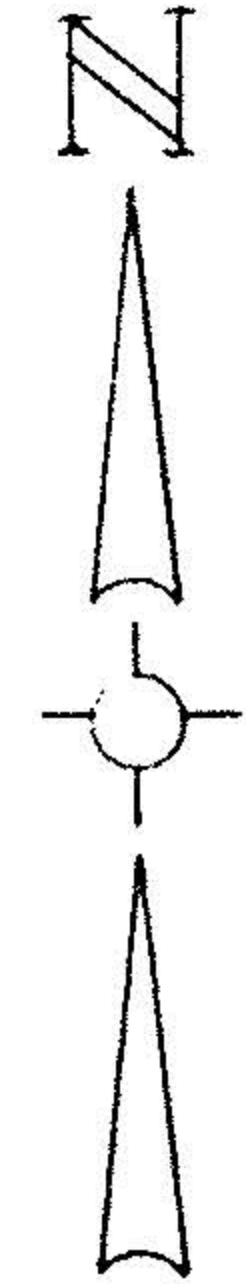

#11266

13G

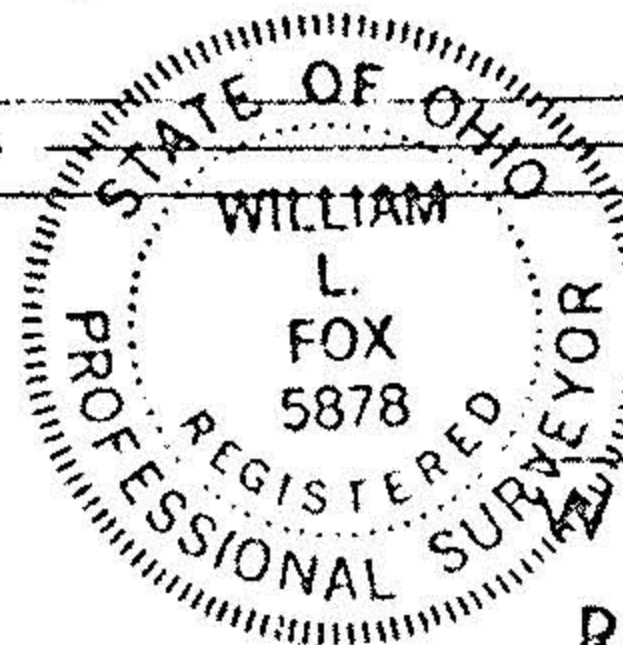

William L. Fox  
WILLIAM L. FOX, SURVEYOR  
REGISTRATION NO. 5878

OWNER: JOHN OGLE