


WILLIAM B. BARTON
 Reg. Land Surveyor No. 4438
 188 PARKWOOD AVENUE
 AVON LAKE, OHIO 44012
 TELEPHONE (216) 933-6662
 James L. & Marian E. Woodrum
 D.V. 1183 Pg. 747 -012

Tract No. 9 - O.L. 13

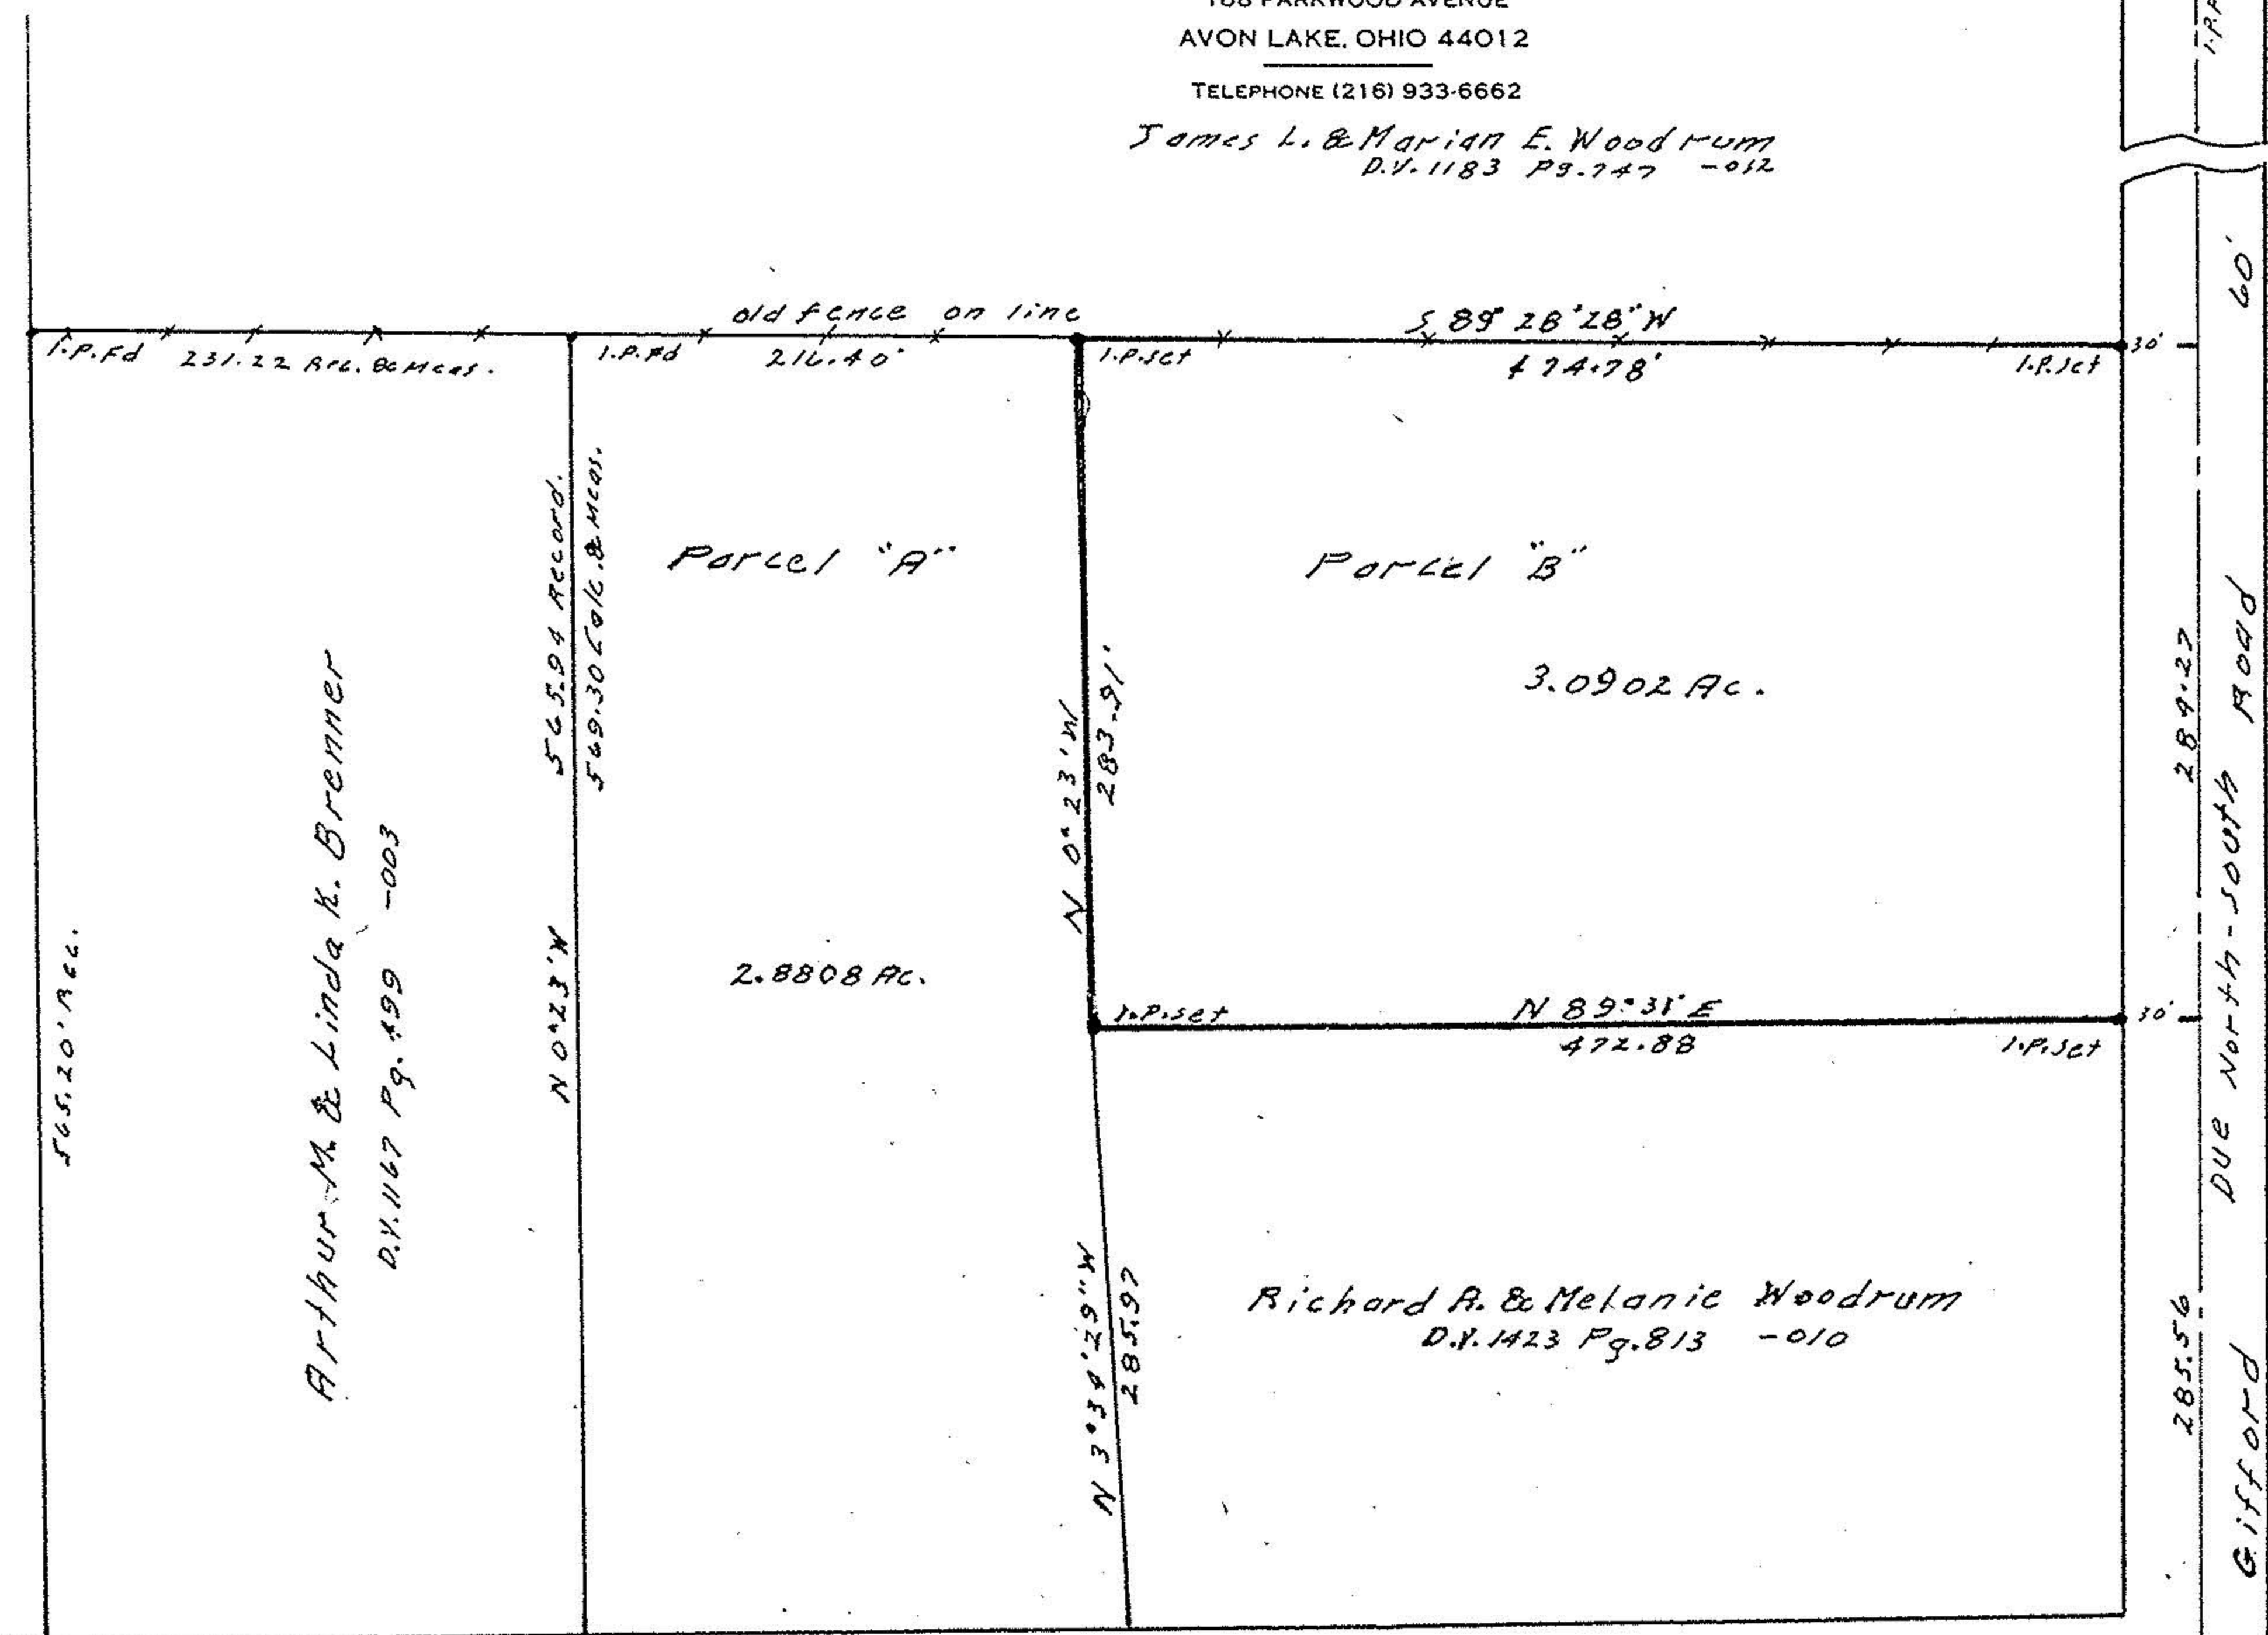

Survey made for Benjamin E. & Joyce Marie Bradner.
 D.V. 1069 Pg. 575 13-009-013-000-011

17801

APPROVED	
LORAIN CO.	
MAP DEPT.	
DATE	12-16-87
PAGE	13-G
BY	Carol
VOID AFTER	17801



SURVEY
 of
 Part of Original Lot No. 13 Tract No. 9 of
 Camden Township, Lorain County Ohio.
 Scale 1" = 100'
 NOV. 1987

