

JANICE MERRILL AND SANDRA KRUPP  
DN. 1411 P. 760

-002

300.00'

IP Fd. 285' N

IP Fd. 240' N

IP SET N-90°00'00"-W

15000'R.

13-09-035-000-013  
RICHARD E. AND SHARON L. SEES  
DN. 1427 P. 835

± 8.19 AC. - REL.  
± 4.06 AC. - REM.

-021

4.1268 AC.

599.28'

S-0°53'15"-W

N-0°53'15"-E  
599.28' R.F.U.

1006  
HOWARD & KATHLEEN WADE  
DN. 922 P. 110

90°53'15" E

BAIRD ROAD

CHARLES MILLARD & SUSAN MARIE SEES  
DN. 1403 P. 287

599.28'R.

IP Fd. 38'

IP Fd. 38'

N-90°00'00"-W

300.00'



IP Fd. 278.5' M.

15000' R.F.U.

IP Fd. 27.40' M.

1301.47' M.  
1301.70' R.

BETTS ROAD

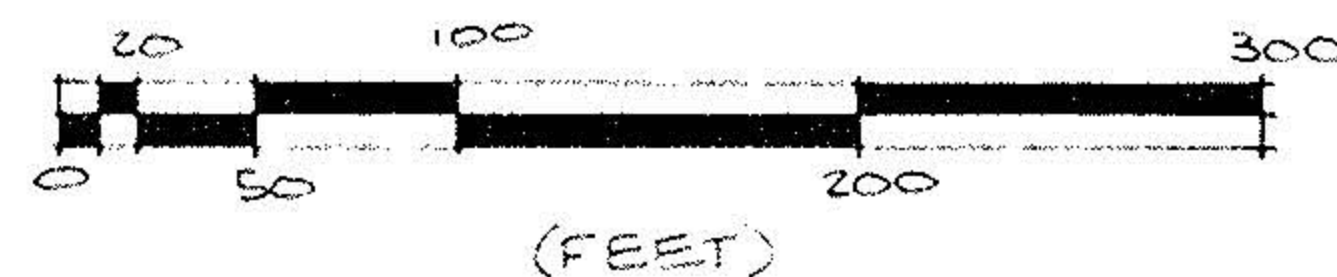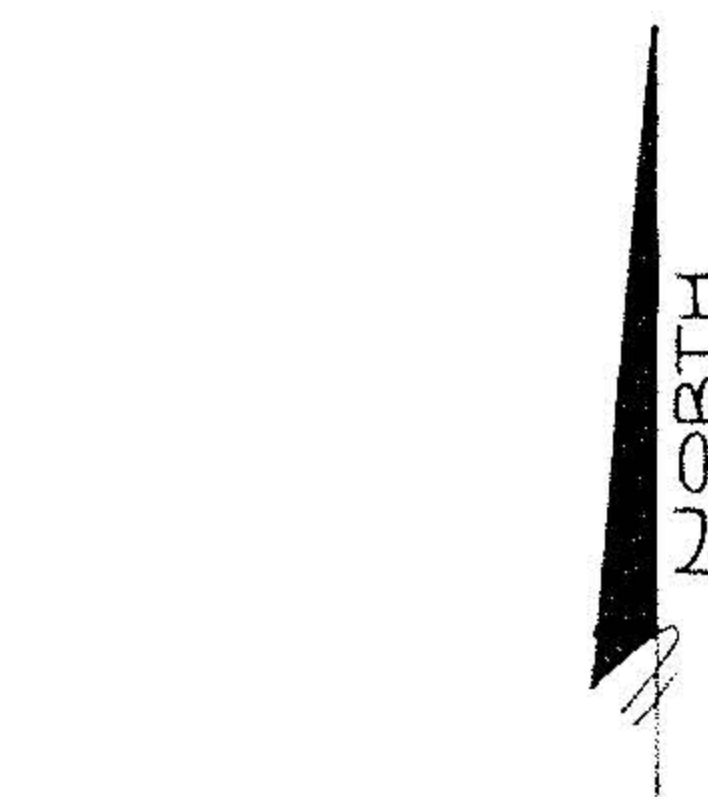

**SURVEY MAP**  
PART OF CAMDEN TOWNSHIP LOT NO. 35  
TRACT NO. 7  
TOWNSHIP OF CAMDEN  
COUNTY OF LORAIN  
STATE OF OHIO  
JULY 29, 1993  
SCALE: 1"=100'  
Rev. 9-23-93

**20513** 13-09-035-000-

APPROVED  
LORAIN CO.  
MAP DEPT.  
DATE 9-27-93  
PAGE 13-E  
BY CAROLYN FRANCIS  
VOID AFTER # 20513

PRINTED  
SEP 22 1993  
KS ASSOCIATES, INC.



PHILA. ROSEBECK  
REG. SURVEYOR NO. 6696