


BRONSON ROAD 60'

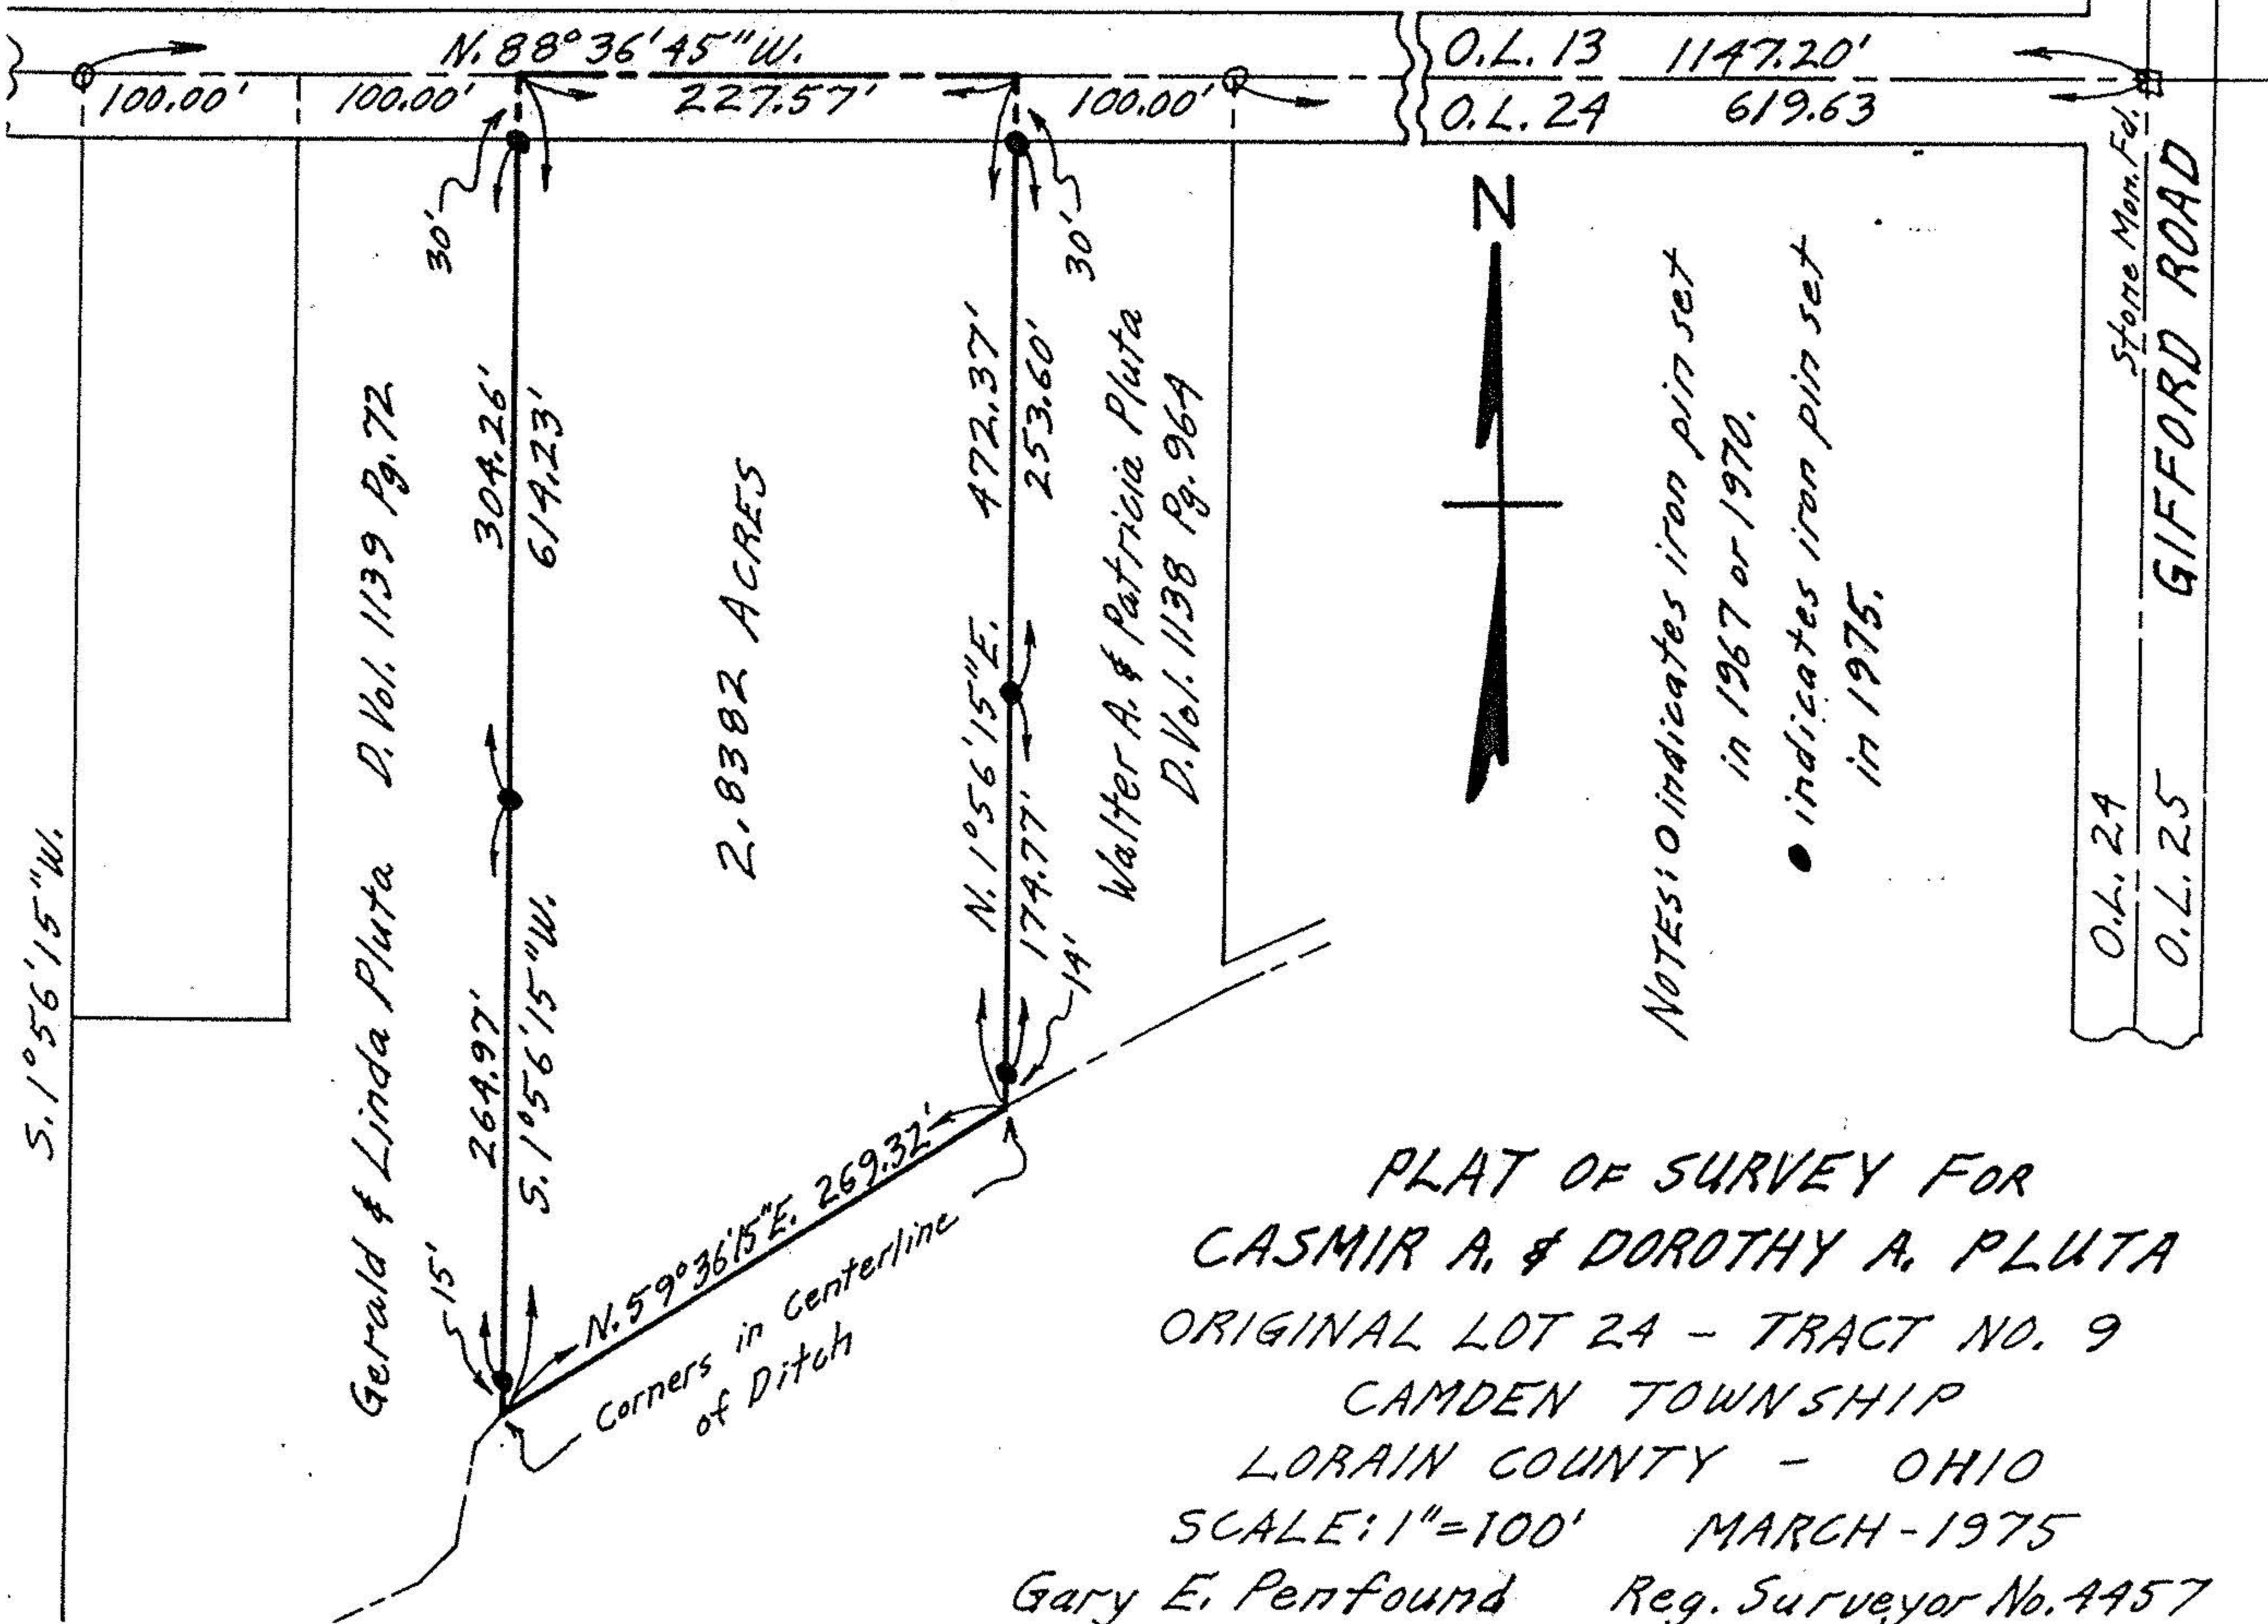

PLAT OF SURVEY FOR  
 CASMIR A. & DOROTHY A. PLUTA  
 ORIGINAL LOT 24 - TRACT NO. 9  
 CAMDEN TOWNSHIP  
 LORAIN COUNTY - OHIO  
 SCALE: 1" = 100' MARCH - 1975  
 Gary E. Penfound Reg. Surveyor No. 4457