




LAUNDON • SIMON • CAHL & ASSOC., INC.
 CONSULTING ENGINEERS & SURVEYORS
 110 MIDDLE AVE., ELYRIA, O. 44035

SURVEY FOR:

DORIS M. FRENCH

Orig. Lot 66	City of	Date MAY 2, 196 Scale 1"=60'
Orig. Sec	Village of	Dwn. by R.G.S. Chkd. by R.C.
Tract	County of LORAIN	Job No 96-2867 F.B.
Township of LAGRANGE	State of OHIO	Printed

Set iron pin monumentation 10/09/96

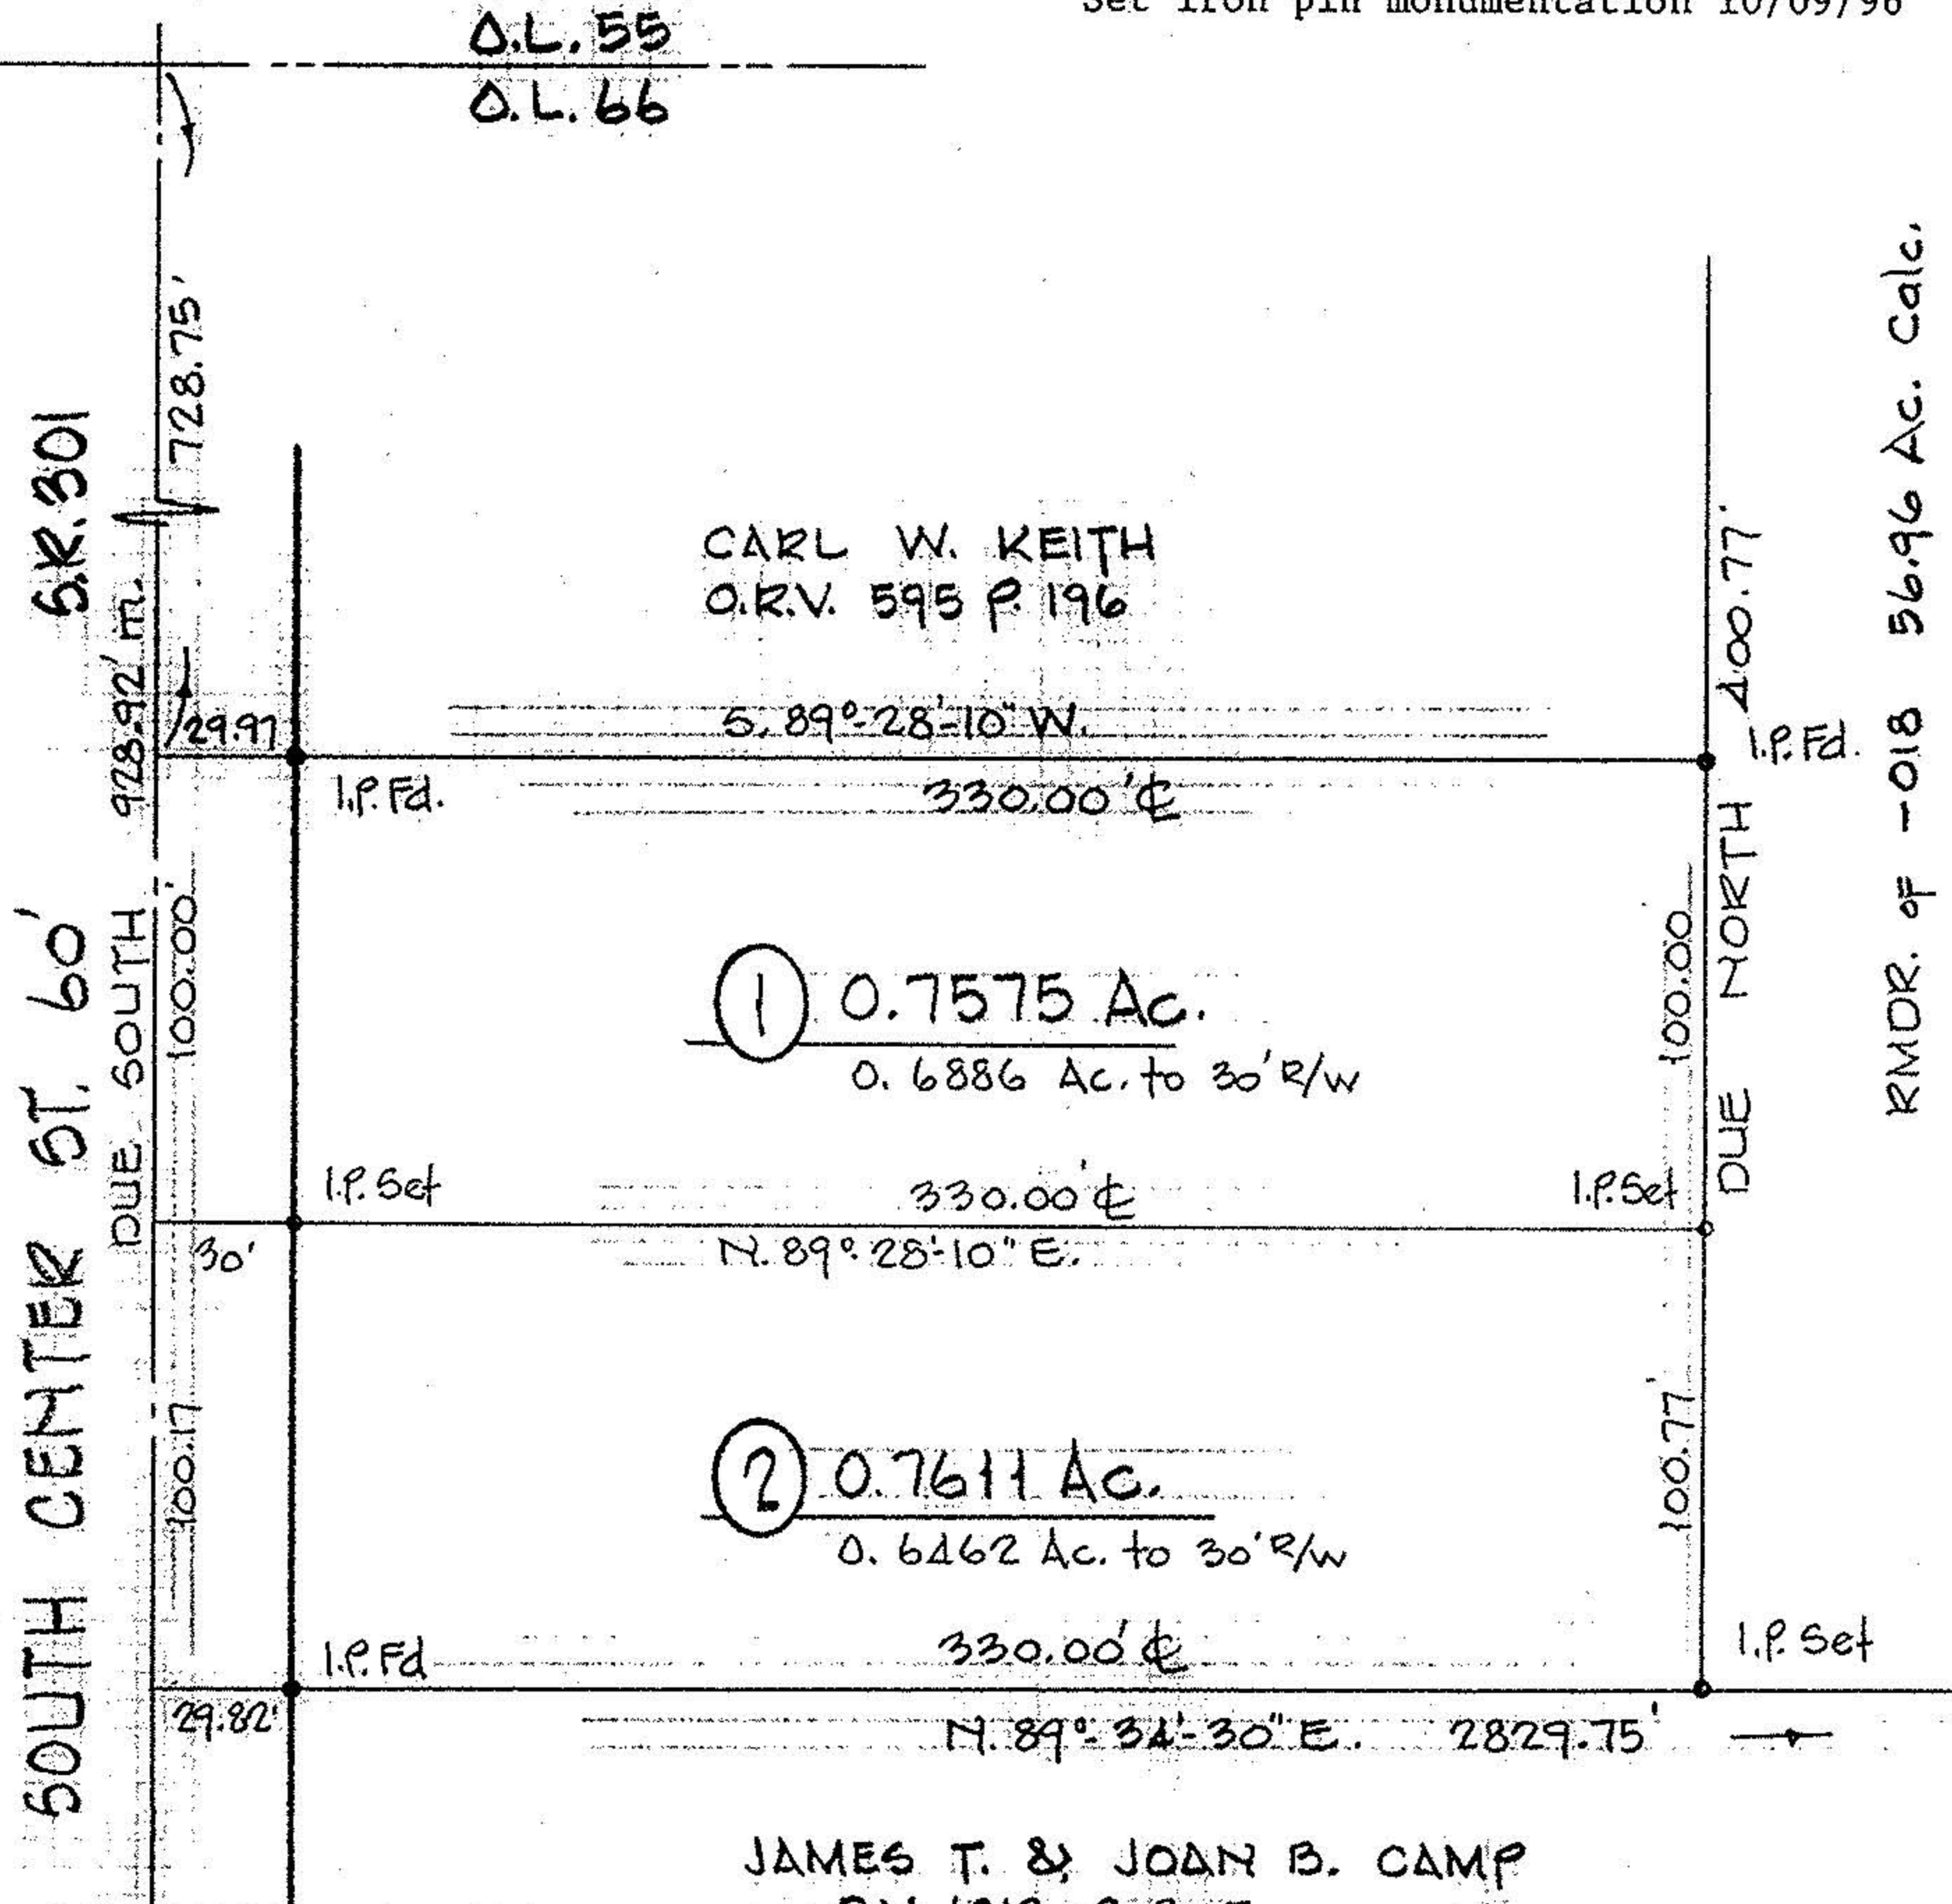

RMOR. of -018 56.96 Ac. Calc.

