


15-00-050-000

15160

Split # 15160

* NOTE: THE DIMENSION CIRCLED IN RED WAS CHANGED ON THE DEED WHICH WAS USED TO SPLIT PROPERTY WITHOUT JOHN POZYWAK BEING INFORMED OF SAID CHANGE IN HIS SURVEY. SEE H.J. MITOCK (OHIO BAR TITLE) ABOUT THE SOURCE 110.02 OF THE CHANGED DIMENSION.

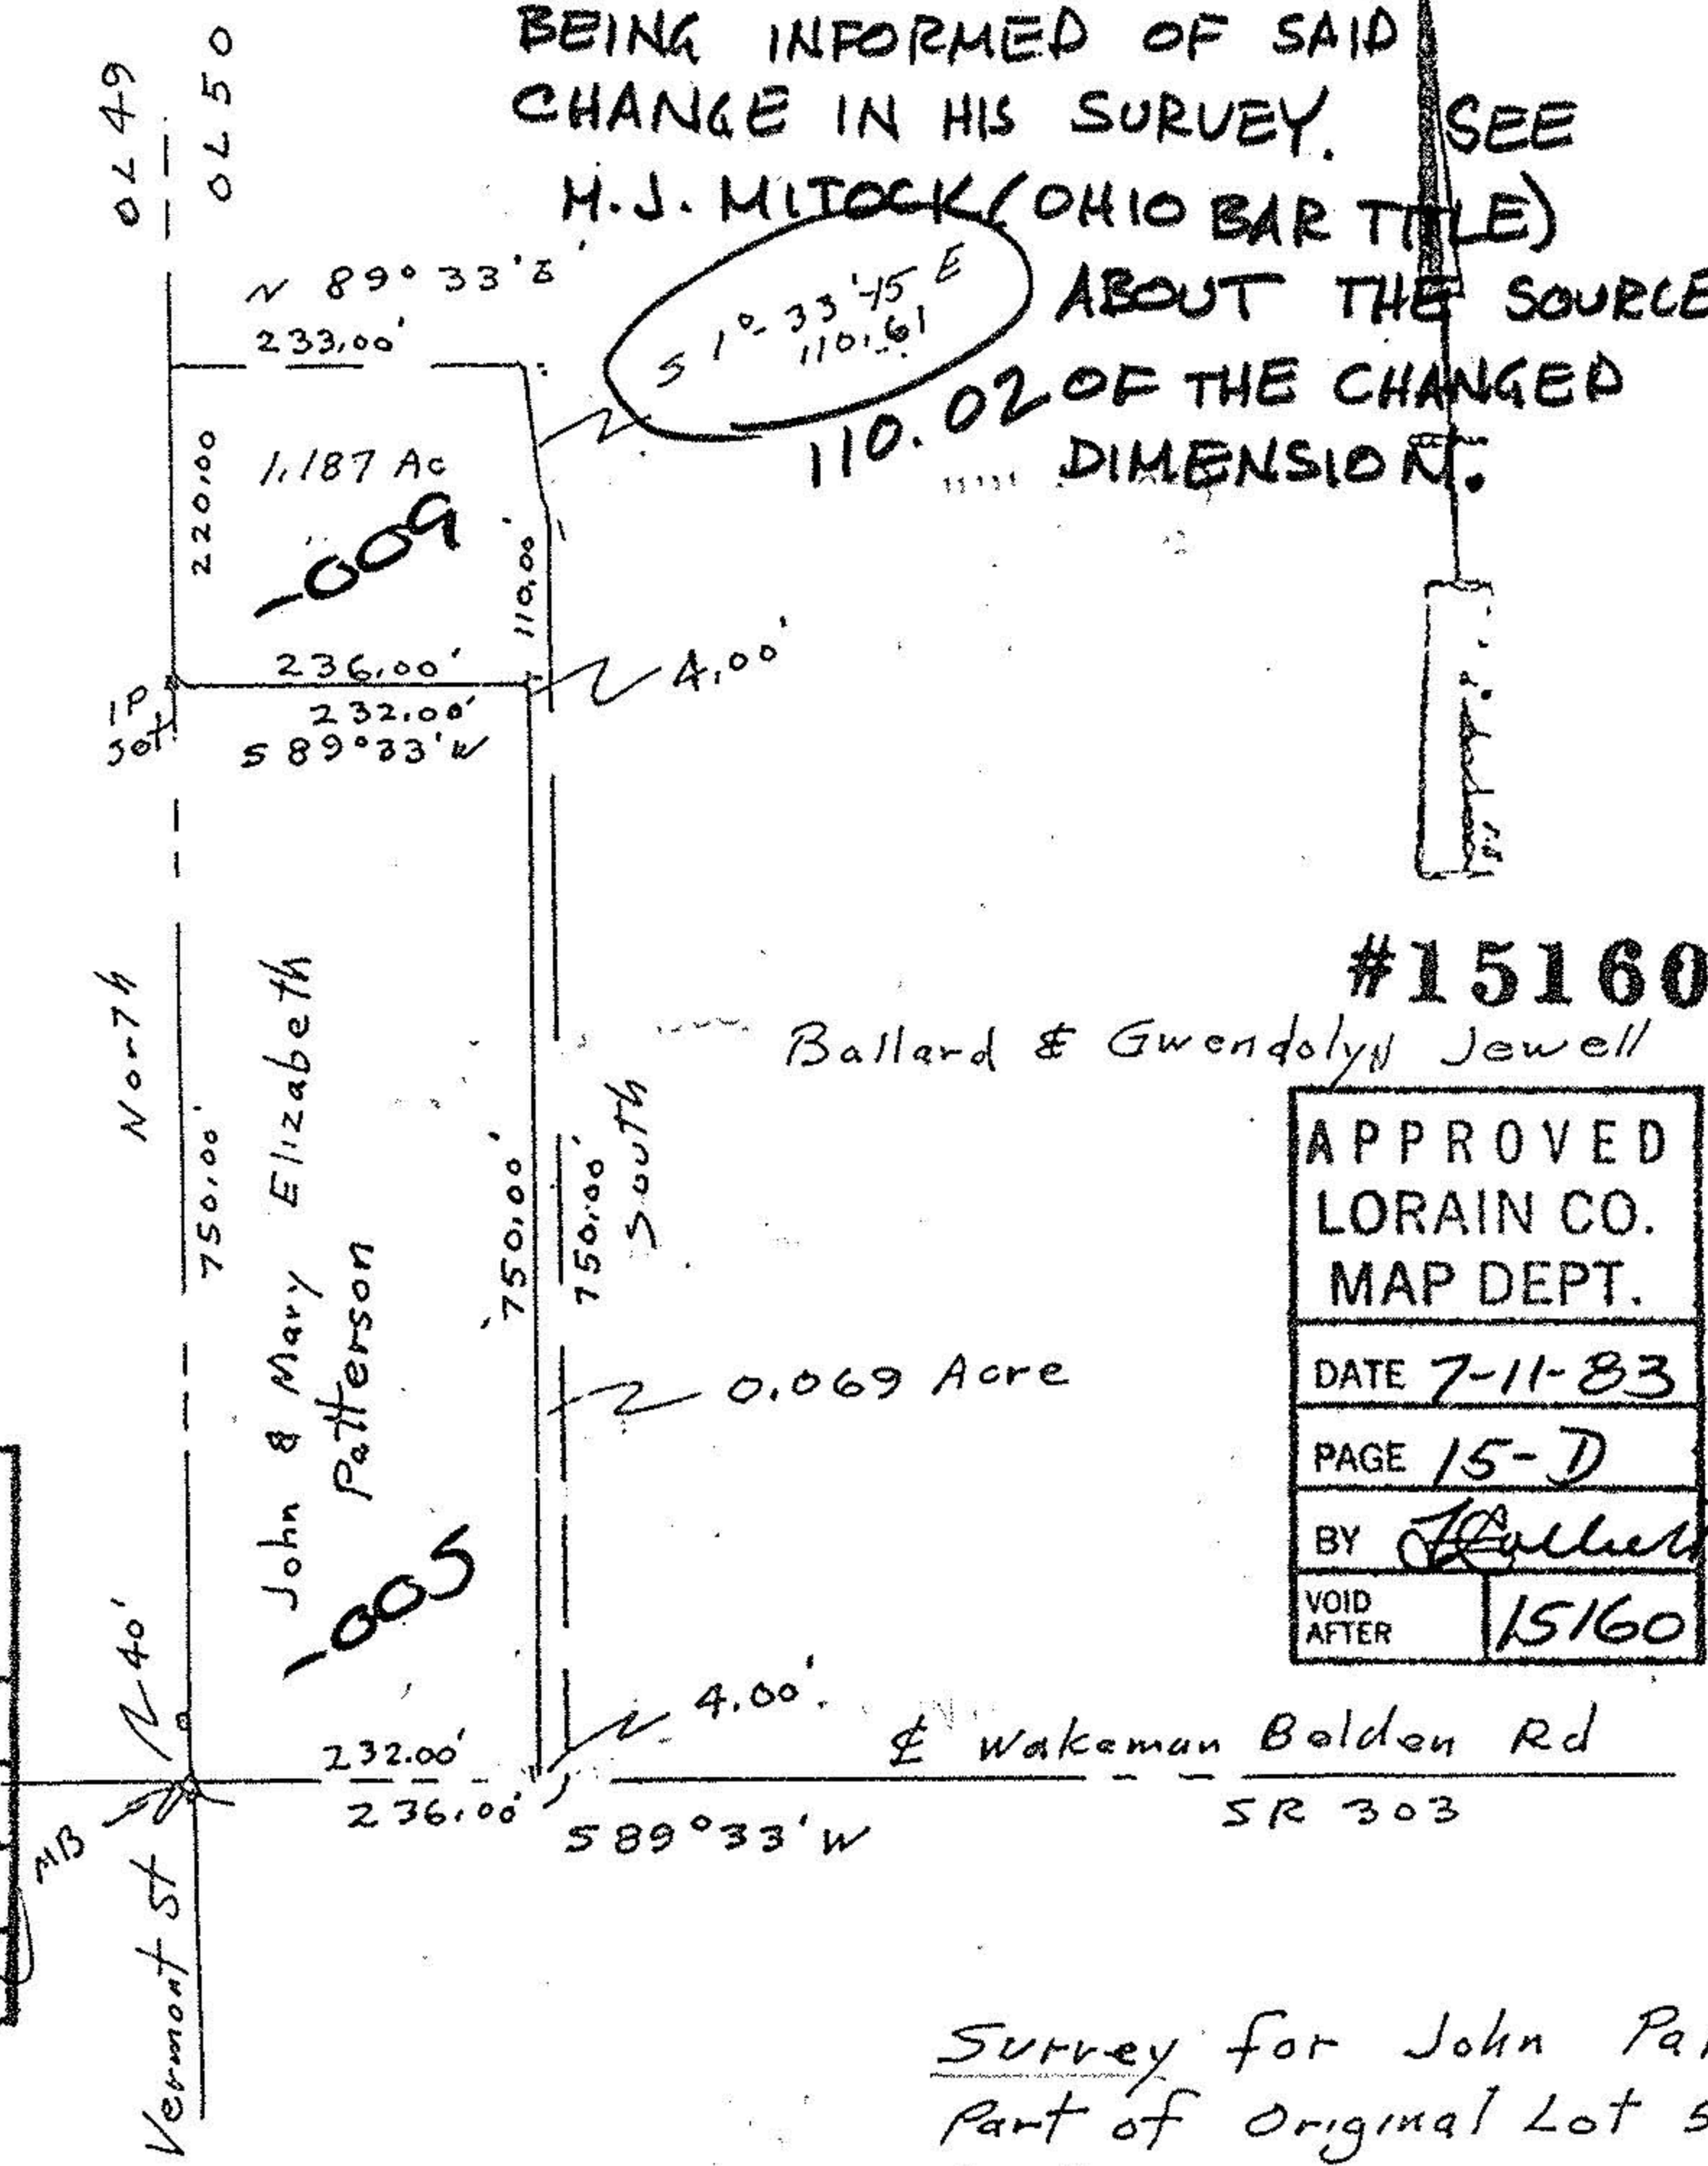

APPROVED LORAIN CO. MAP DEPT.
DATE
PAGE
BY
VOID AFTER

#15160

Ballard & Gwendolyn Jewell

APPROVED LORAIN CO. MAP DEPT.
DATE 7-11-83
PAGE 15-D
BY <i>[Signature]</i>
VOID AFTER 15160

15-D

064
1-1987
1-256

John Pozywak
Reg Surveyor
5292

Survey for John Patter
Part of Original Lot 50
La Grange Twp
Lorain County Ohio
Scale 1"=200' May 28, 1983