


206  
Muss

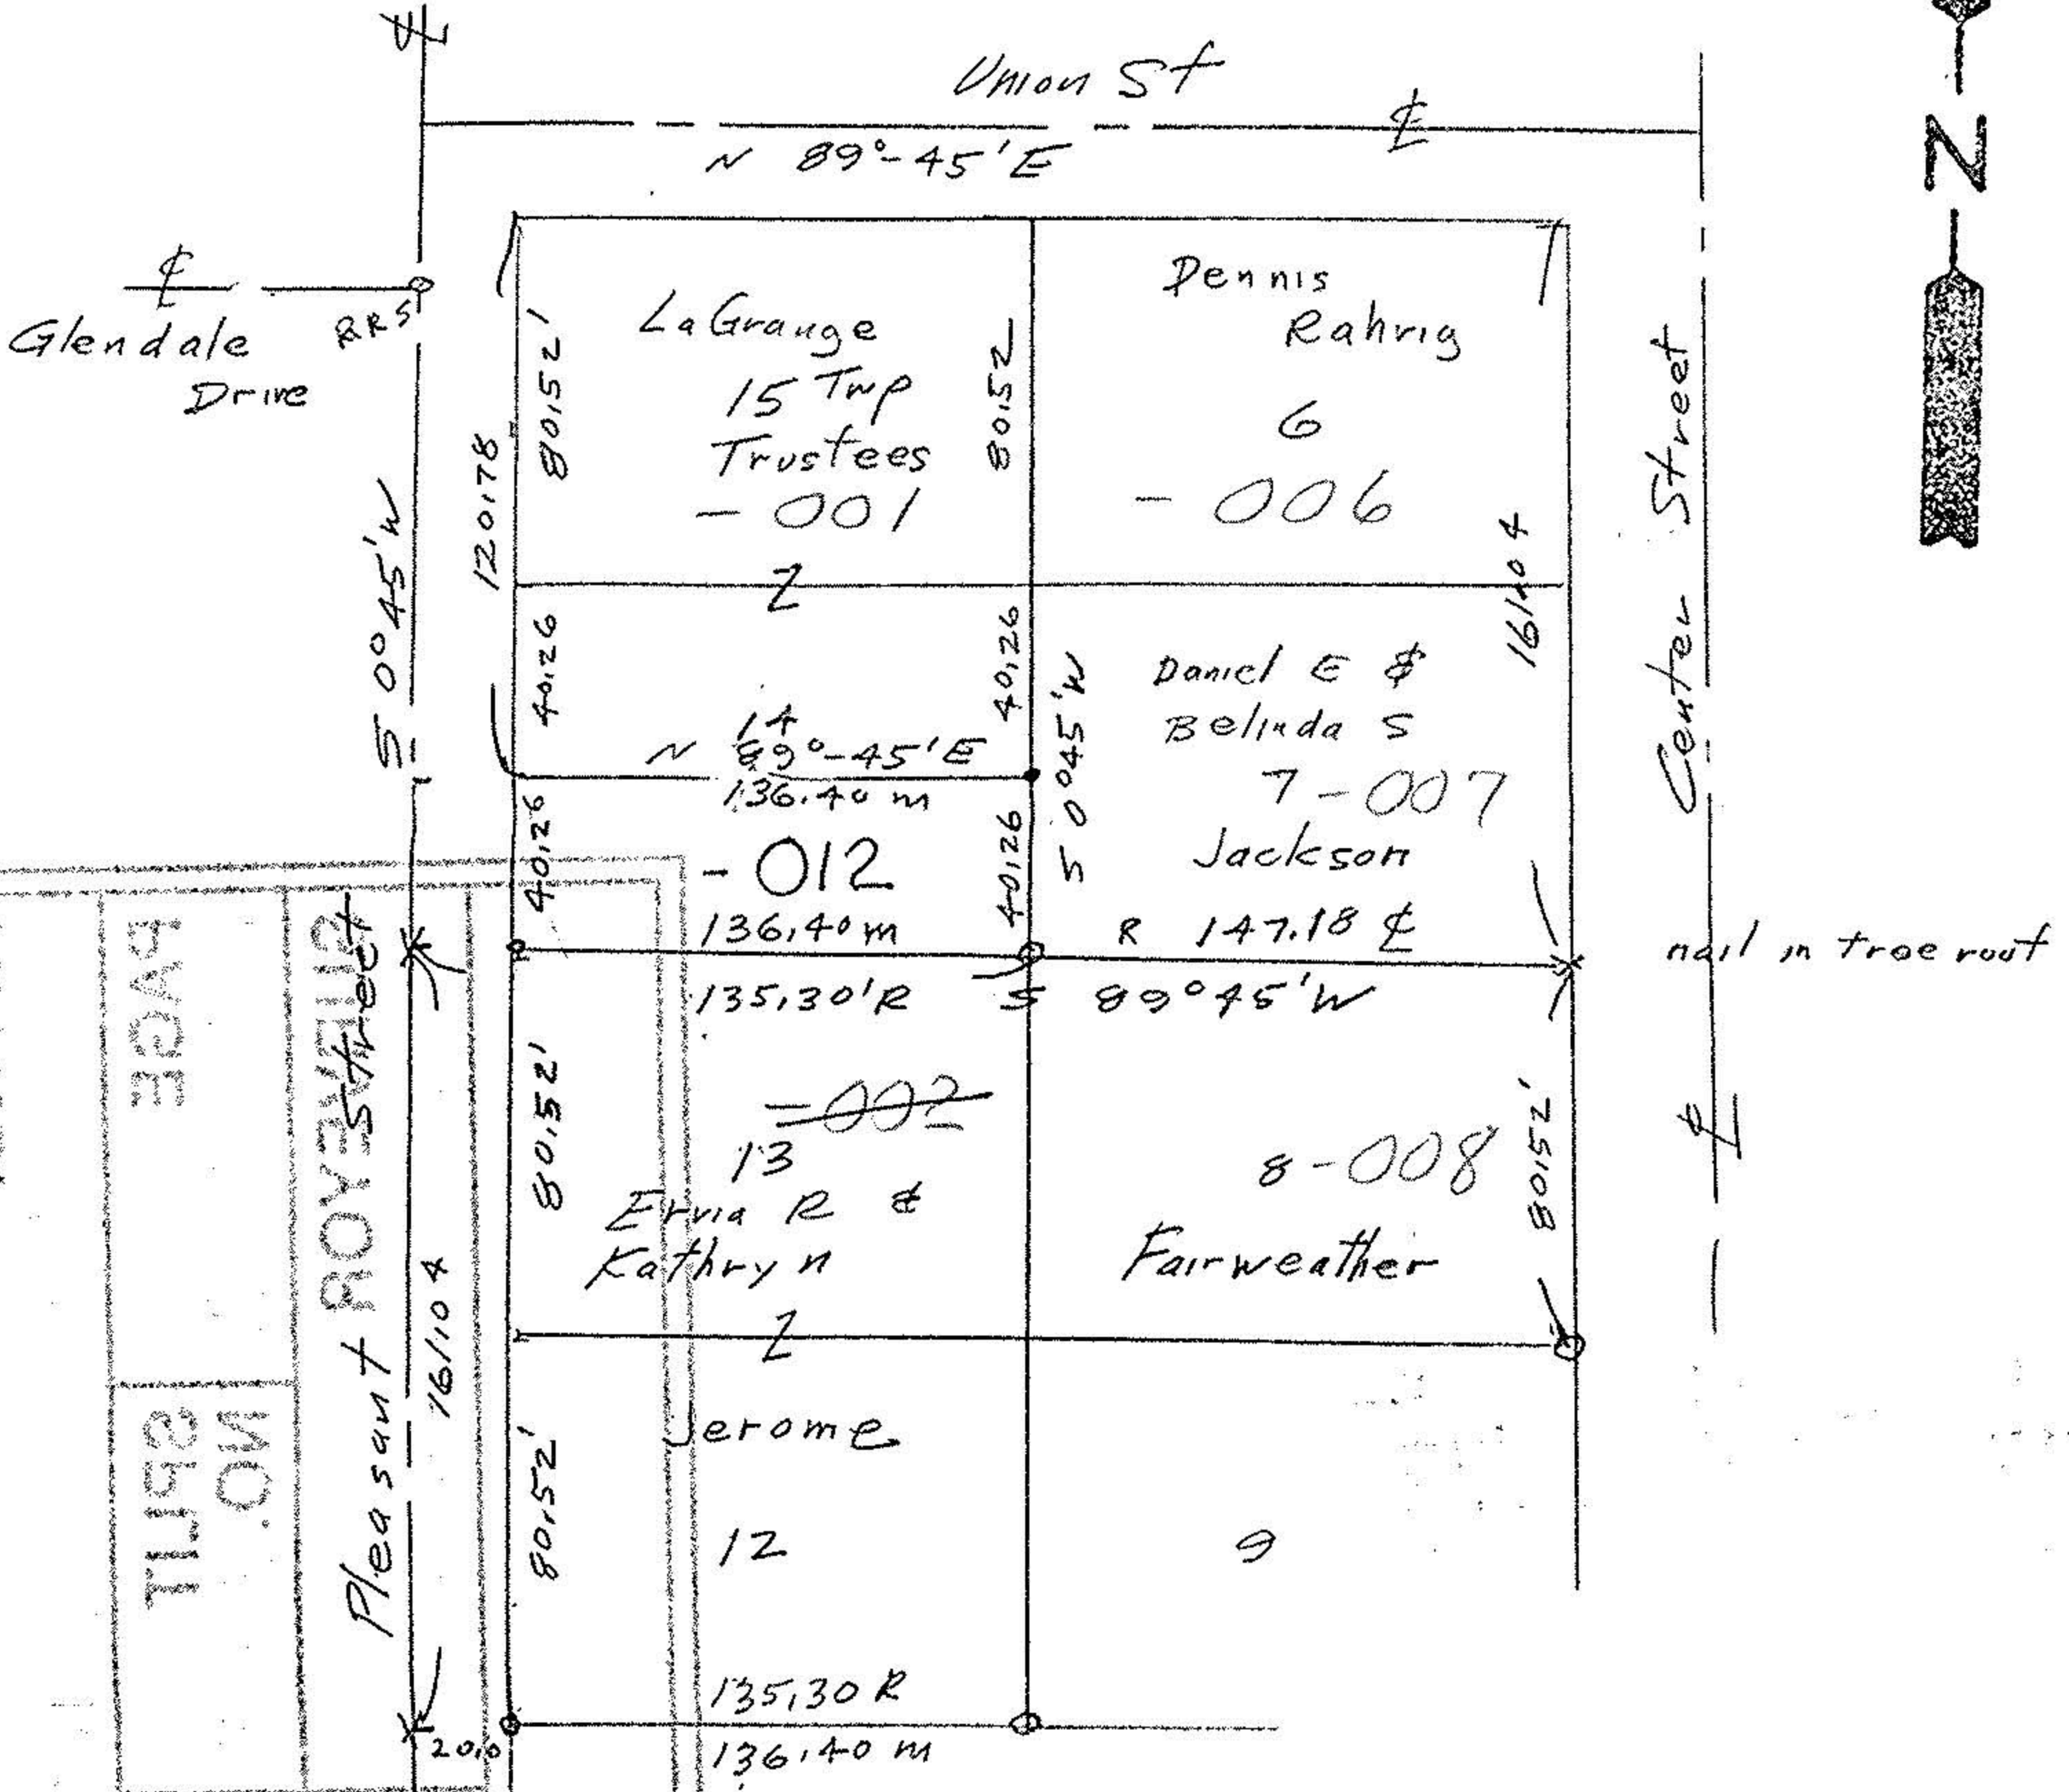


nail in tree root

- o iron pipes or pins fd
- iron pins set
- x PK nails

John  
Pozywak  
Surveyor  
5292

Survey of south half subplot 14  
Grant's Addition  
Plat Vol 1 Pg 30  
Original LaGrange Twp Lot 56  
Lorain County, Ohio  
Scale 1" = 60' Jun 4, 1995

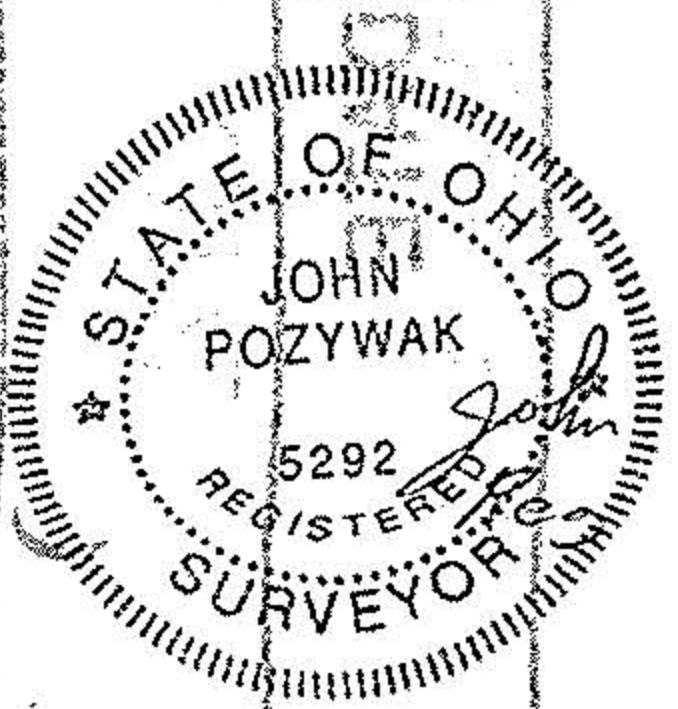

65' NO.  
PAGE  
NO. 25111  
Pleasant Roy Street