



CARDINAL SURVEYS  
 PLAT OF SURVEY  
 PREPARED FOR MR. RON SEABOLD

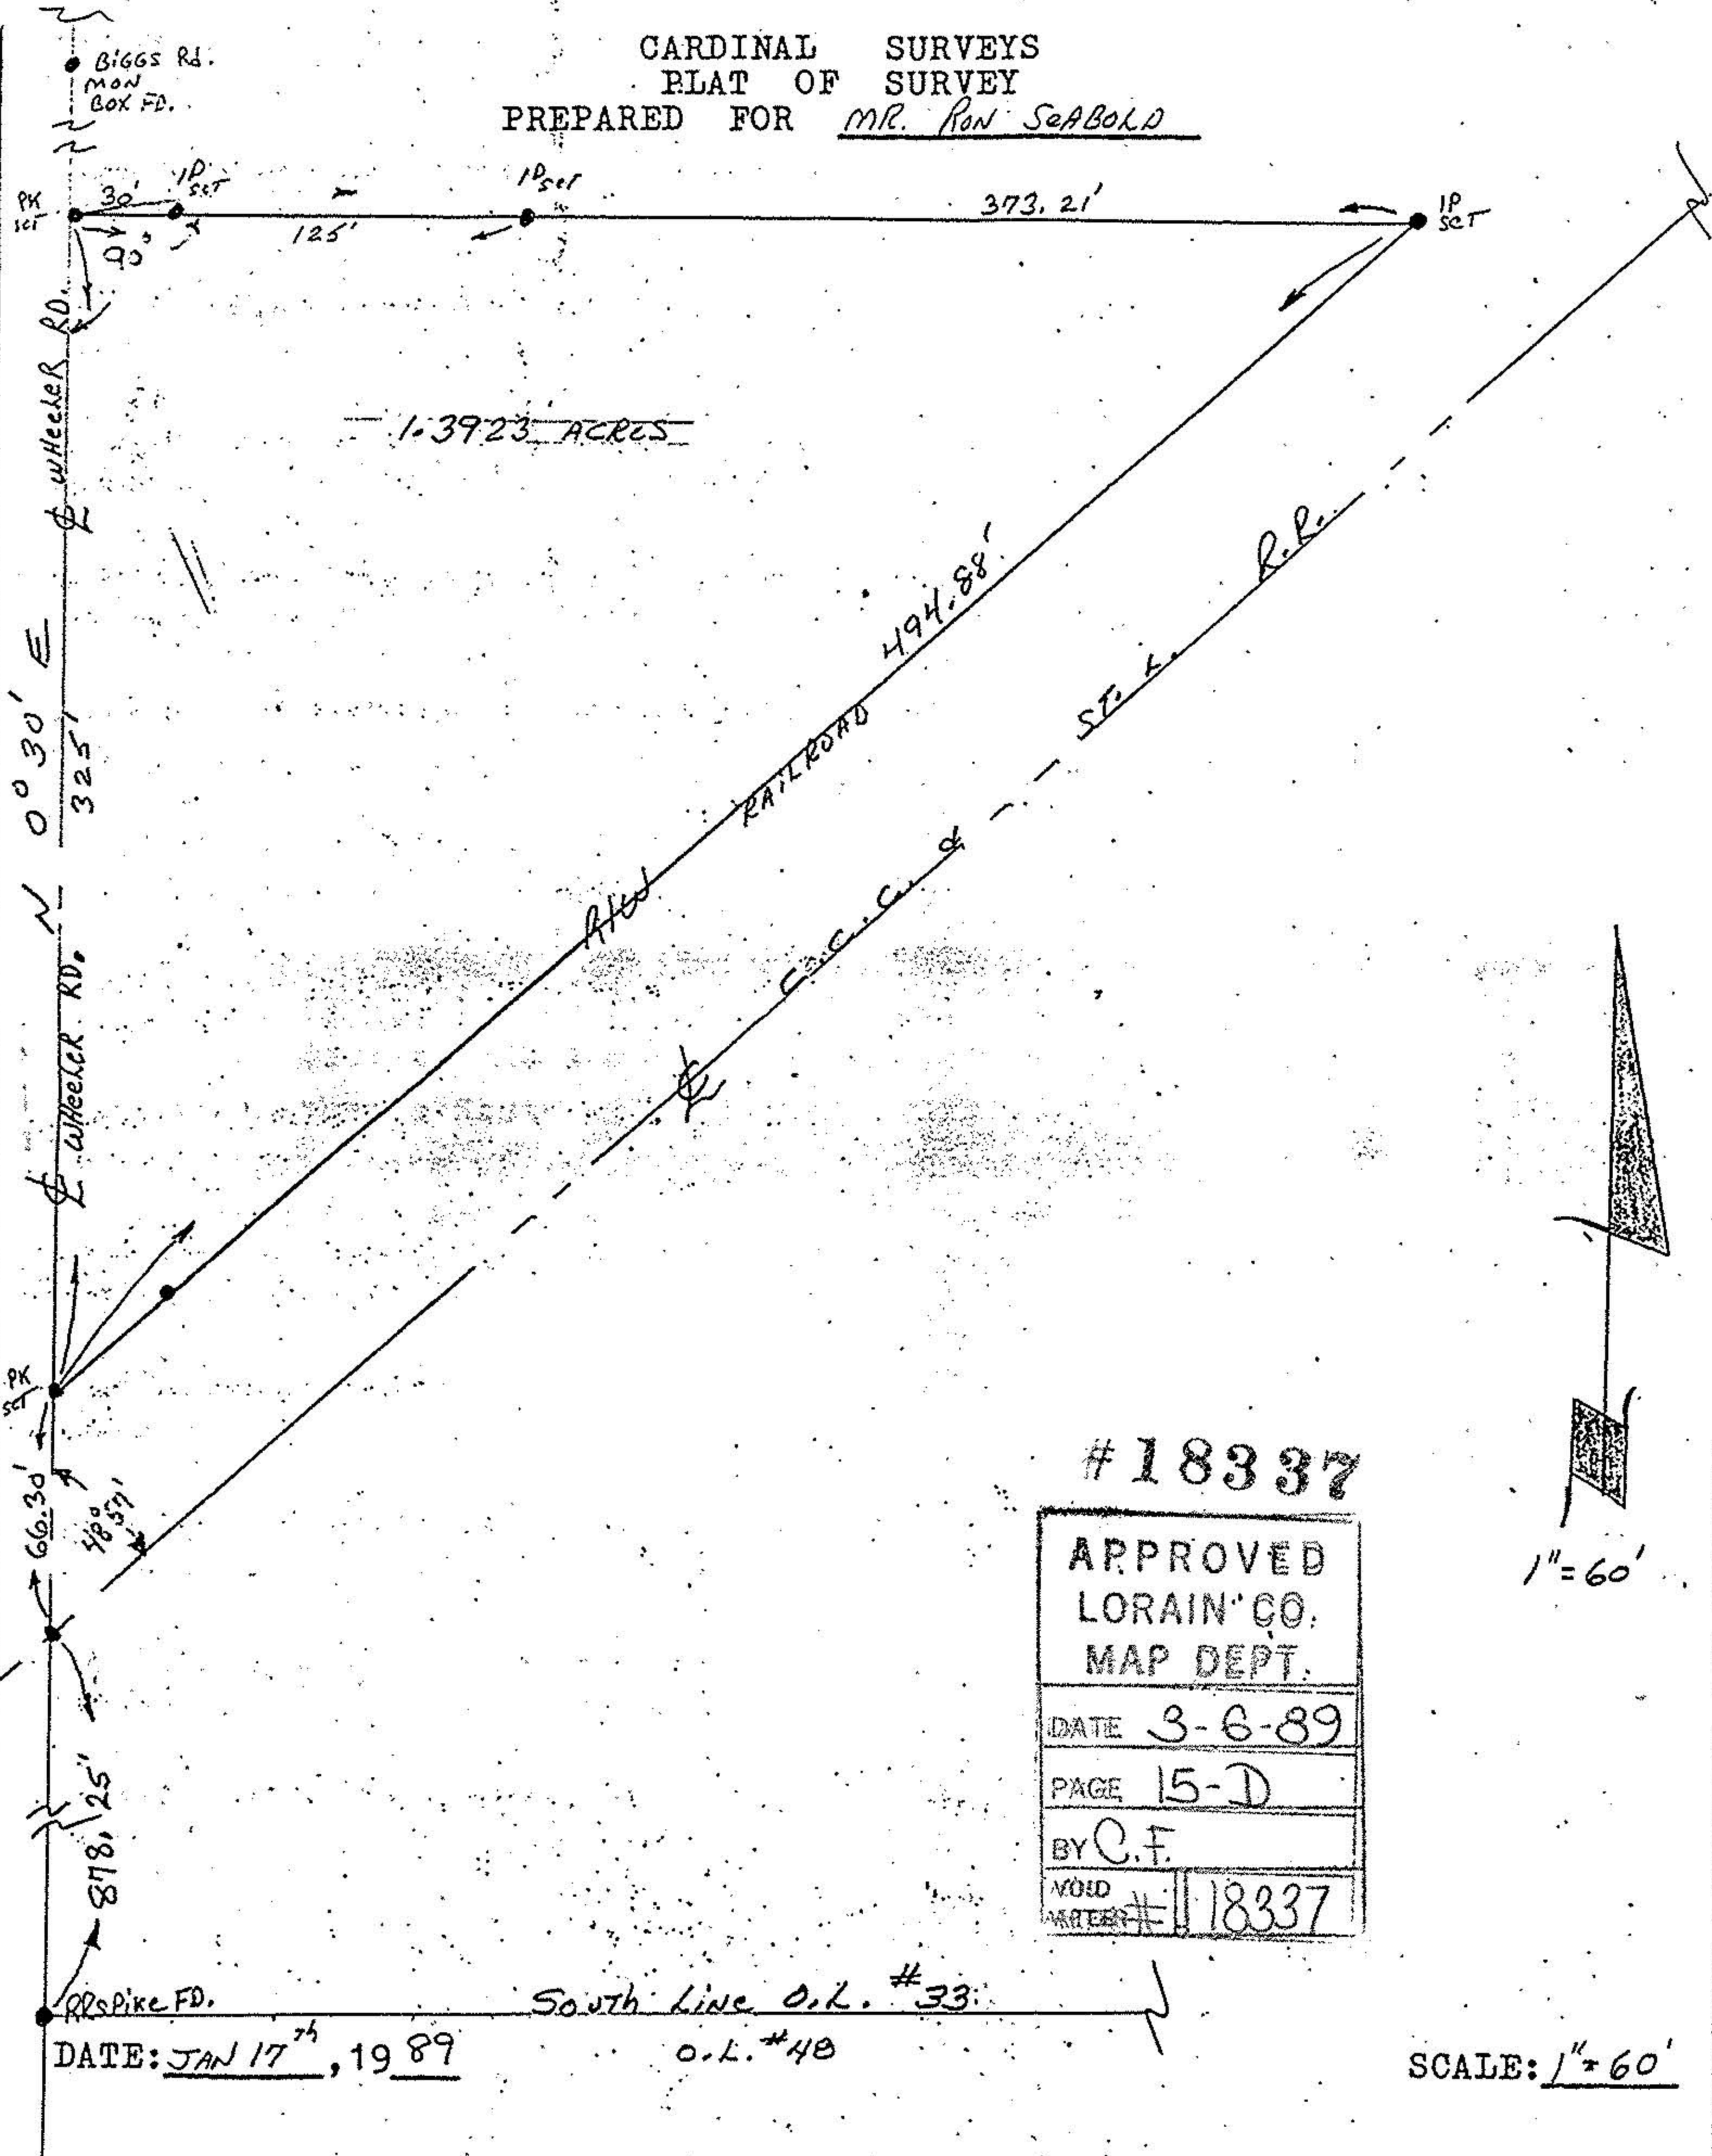

#18337

APPROVED	
LORAIN CO.	
MAP DEPT.	
DATE	3-6-89
PAGE	15-D
BY	C.F.
VOID WATER #	18337

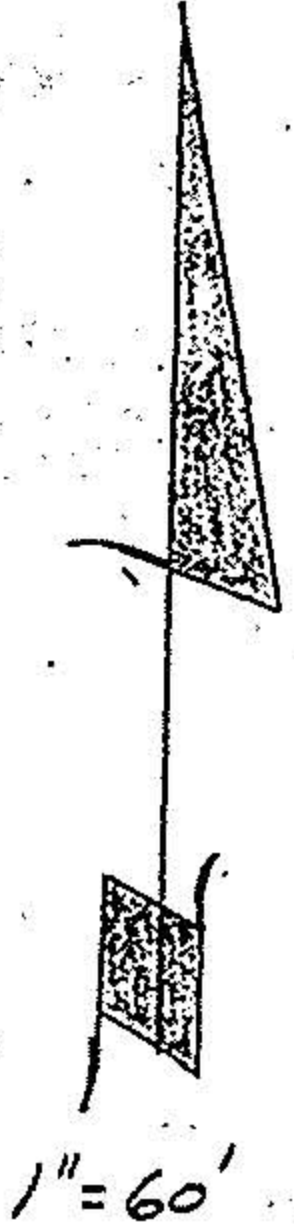

DATE: JAN 17<sup>th</sup>, 1989      South Line O.L. #33  
 O.L. #48

SCALE: 1" = 60'