


CARDINAL SURVEYS 323-183's  
 PLAT OF SURVEY

PREPARED FOR MR. SEABOLD  
 SURVEY OF ...  
 TOWN OF ...  
 ADDITIONAL ...

O.L. 27  
 O.L. 34  
 BIGGS ROAD

MOUL BOX FOUND

SEABOLD BROTHERS  
 VOL. 1395  
 PG. 768

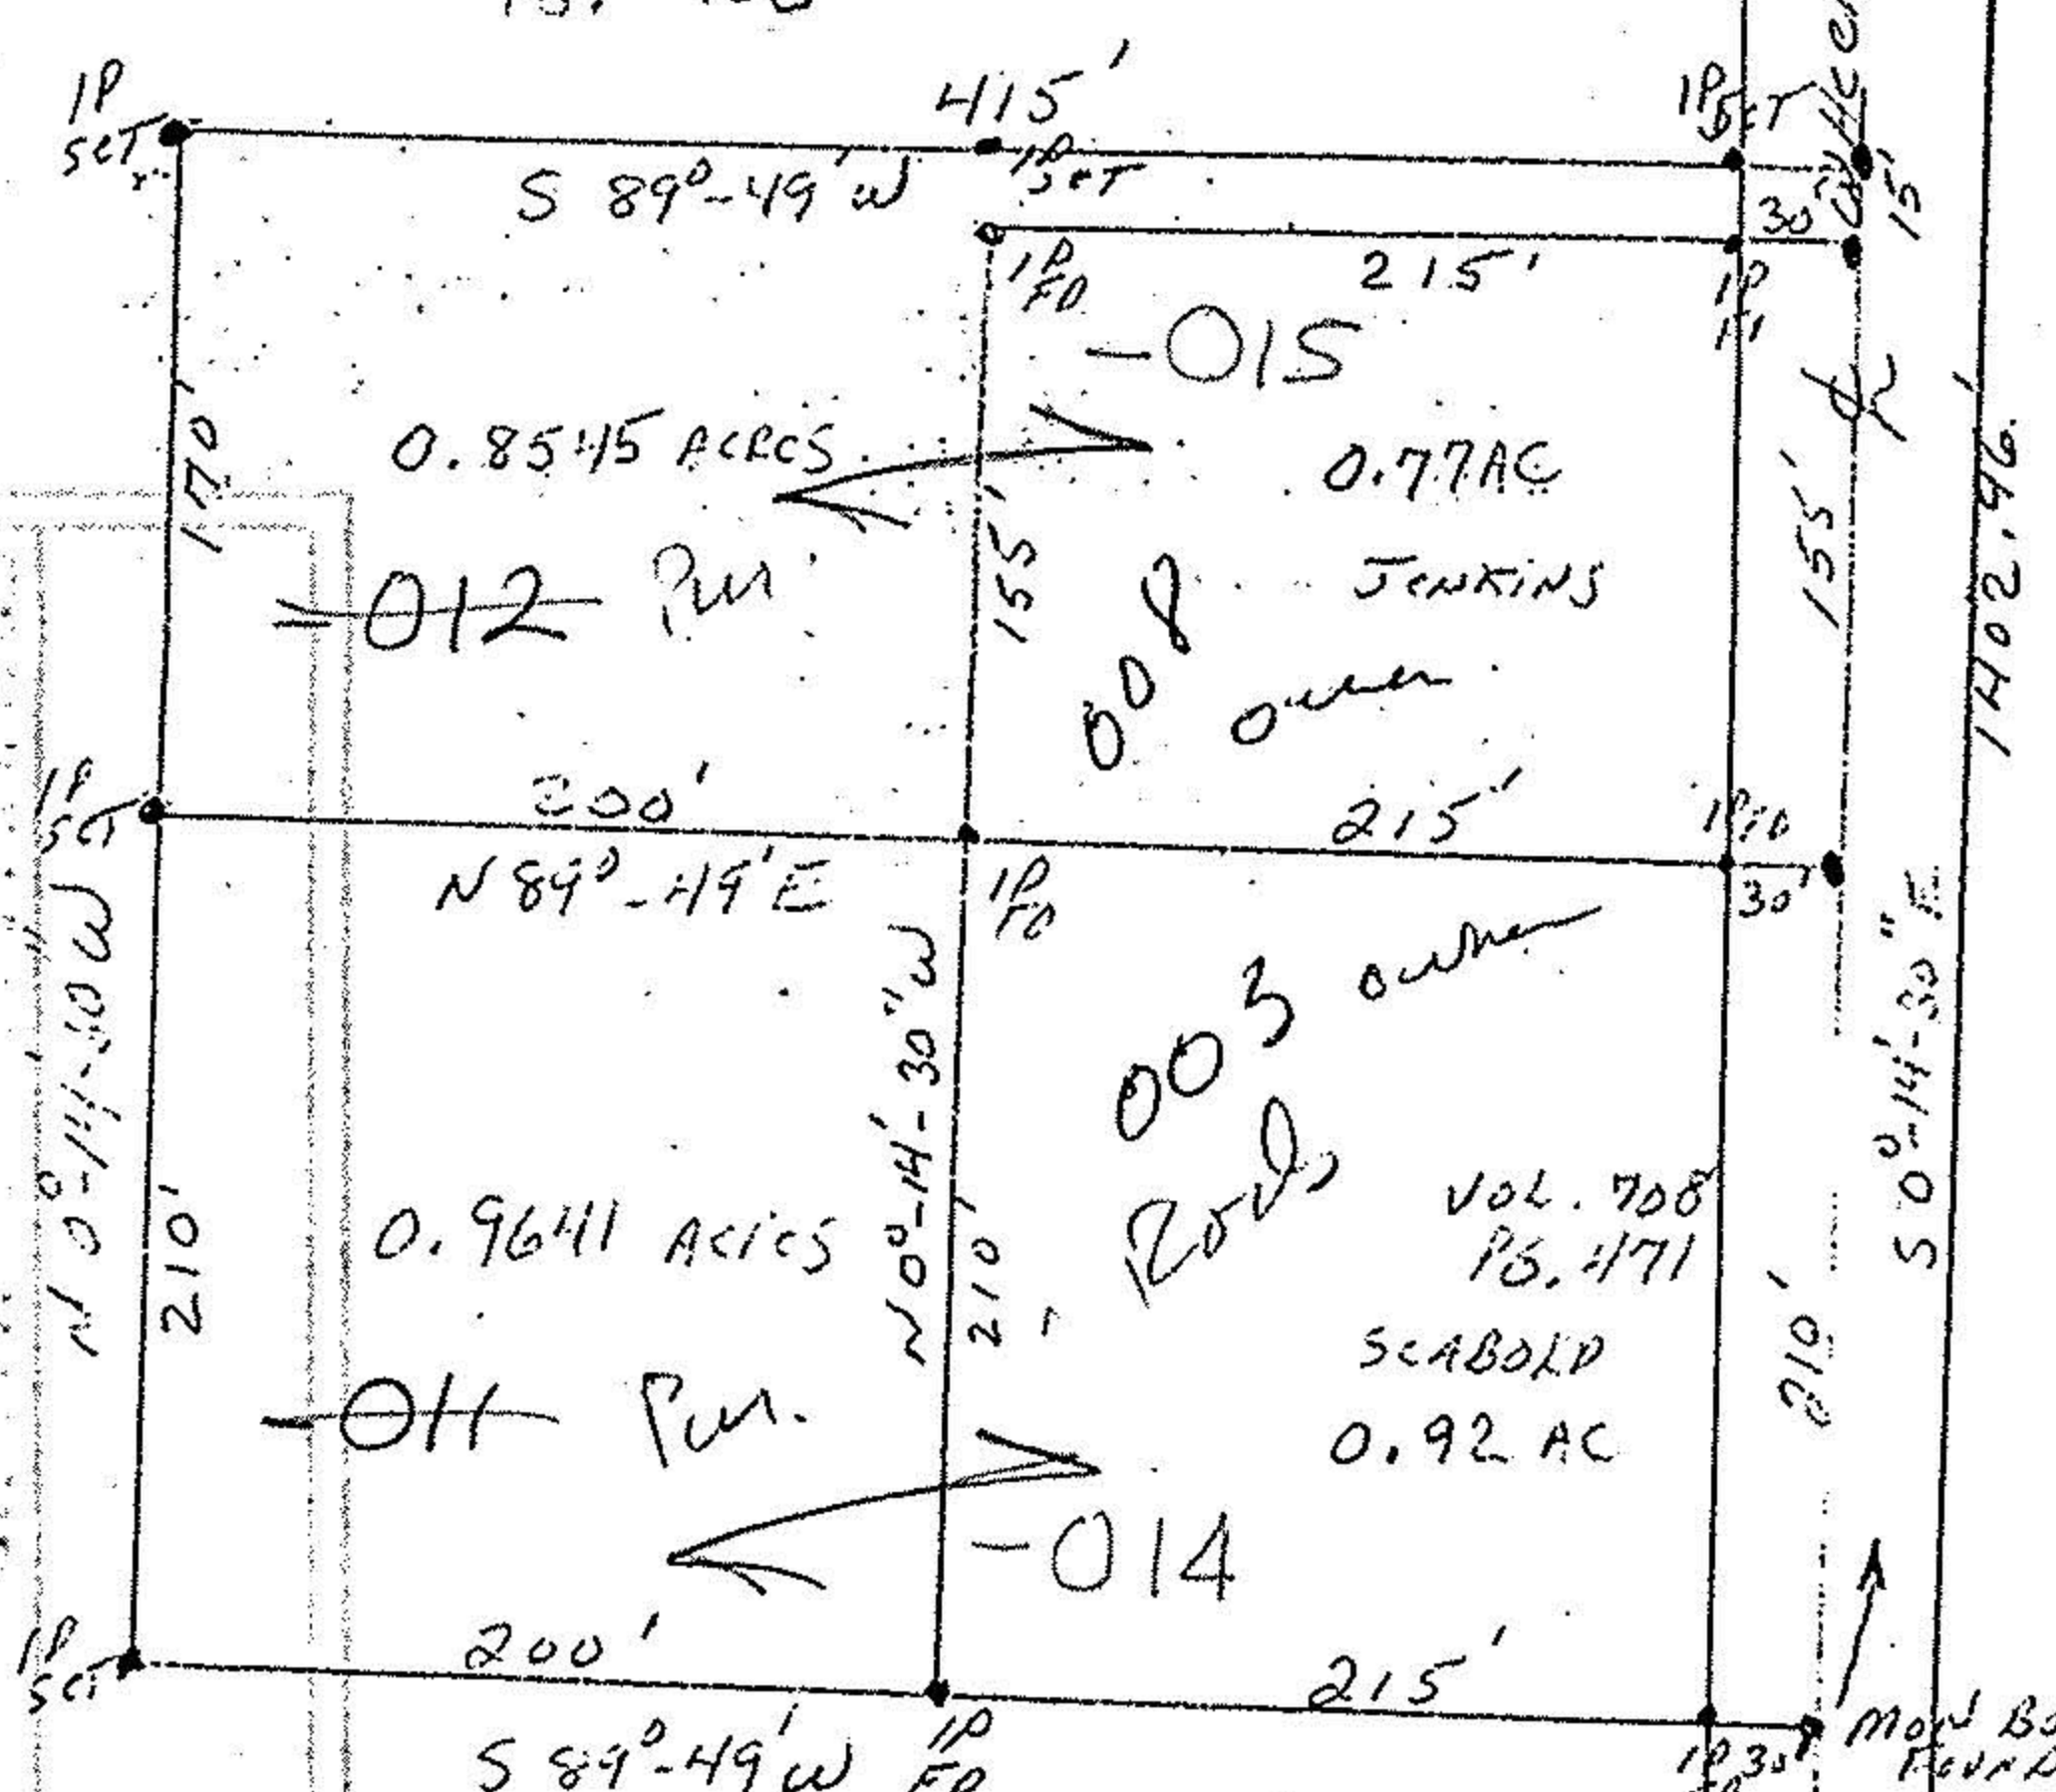

55' 140'  
 170'  
 210'  
 210'  
 200'

PAGE  
 21011

APPROVED LORAIN CO. MAP DEPT
DATE 8-19-94
PAGE 15-C
BY CAROLYN FRANCIS
2 L.M.

SCALE: 1" = 100'

DATE: MAY 23, 1994

O.L. 34  
 O.L. 47