

15-C


#17140

15-00-035

300

CARDINAL SURVEYS
PLAT OF
PREPARED FOR Iron Seaboard

L. A. LANGE

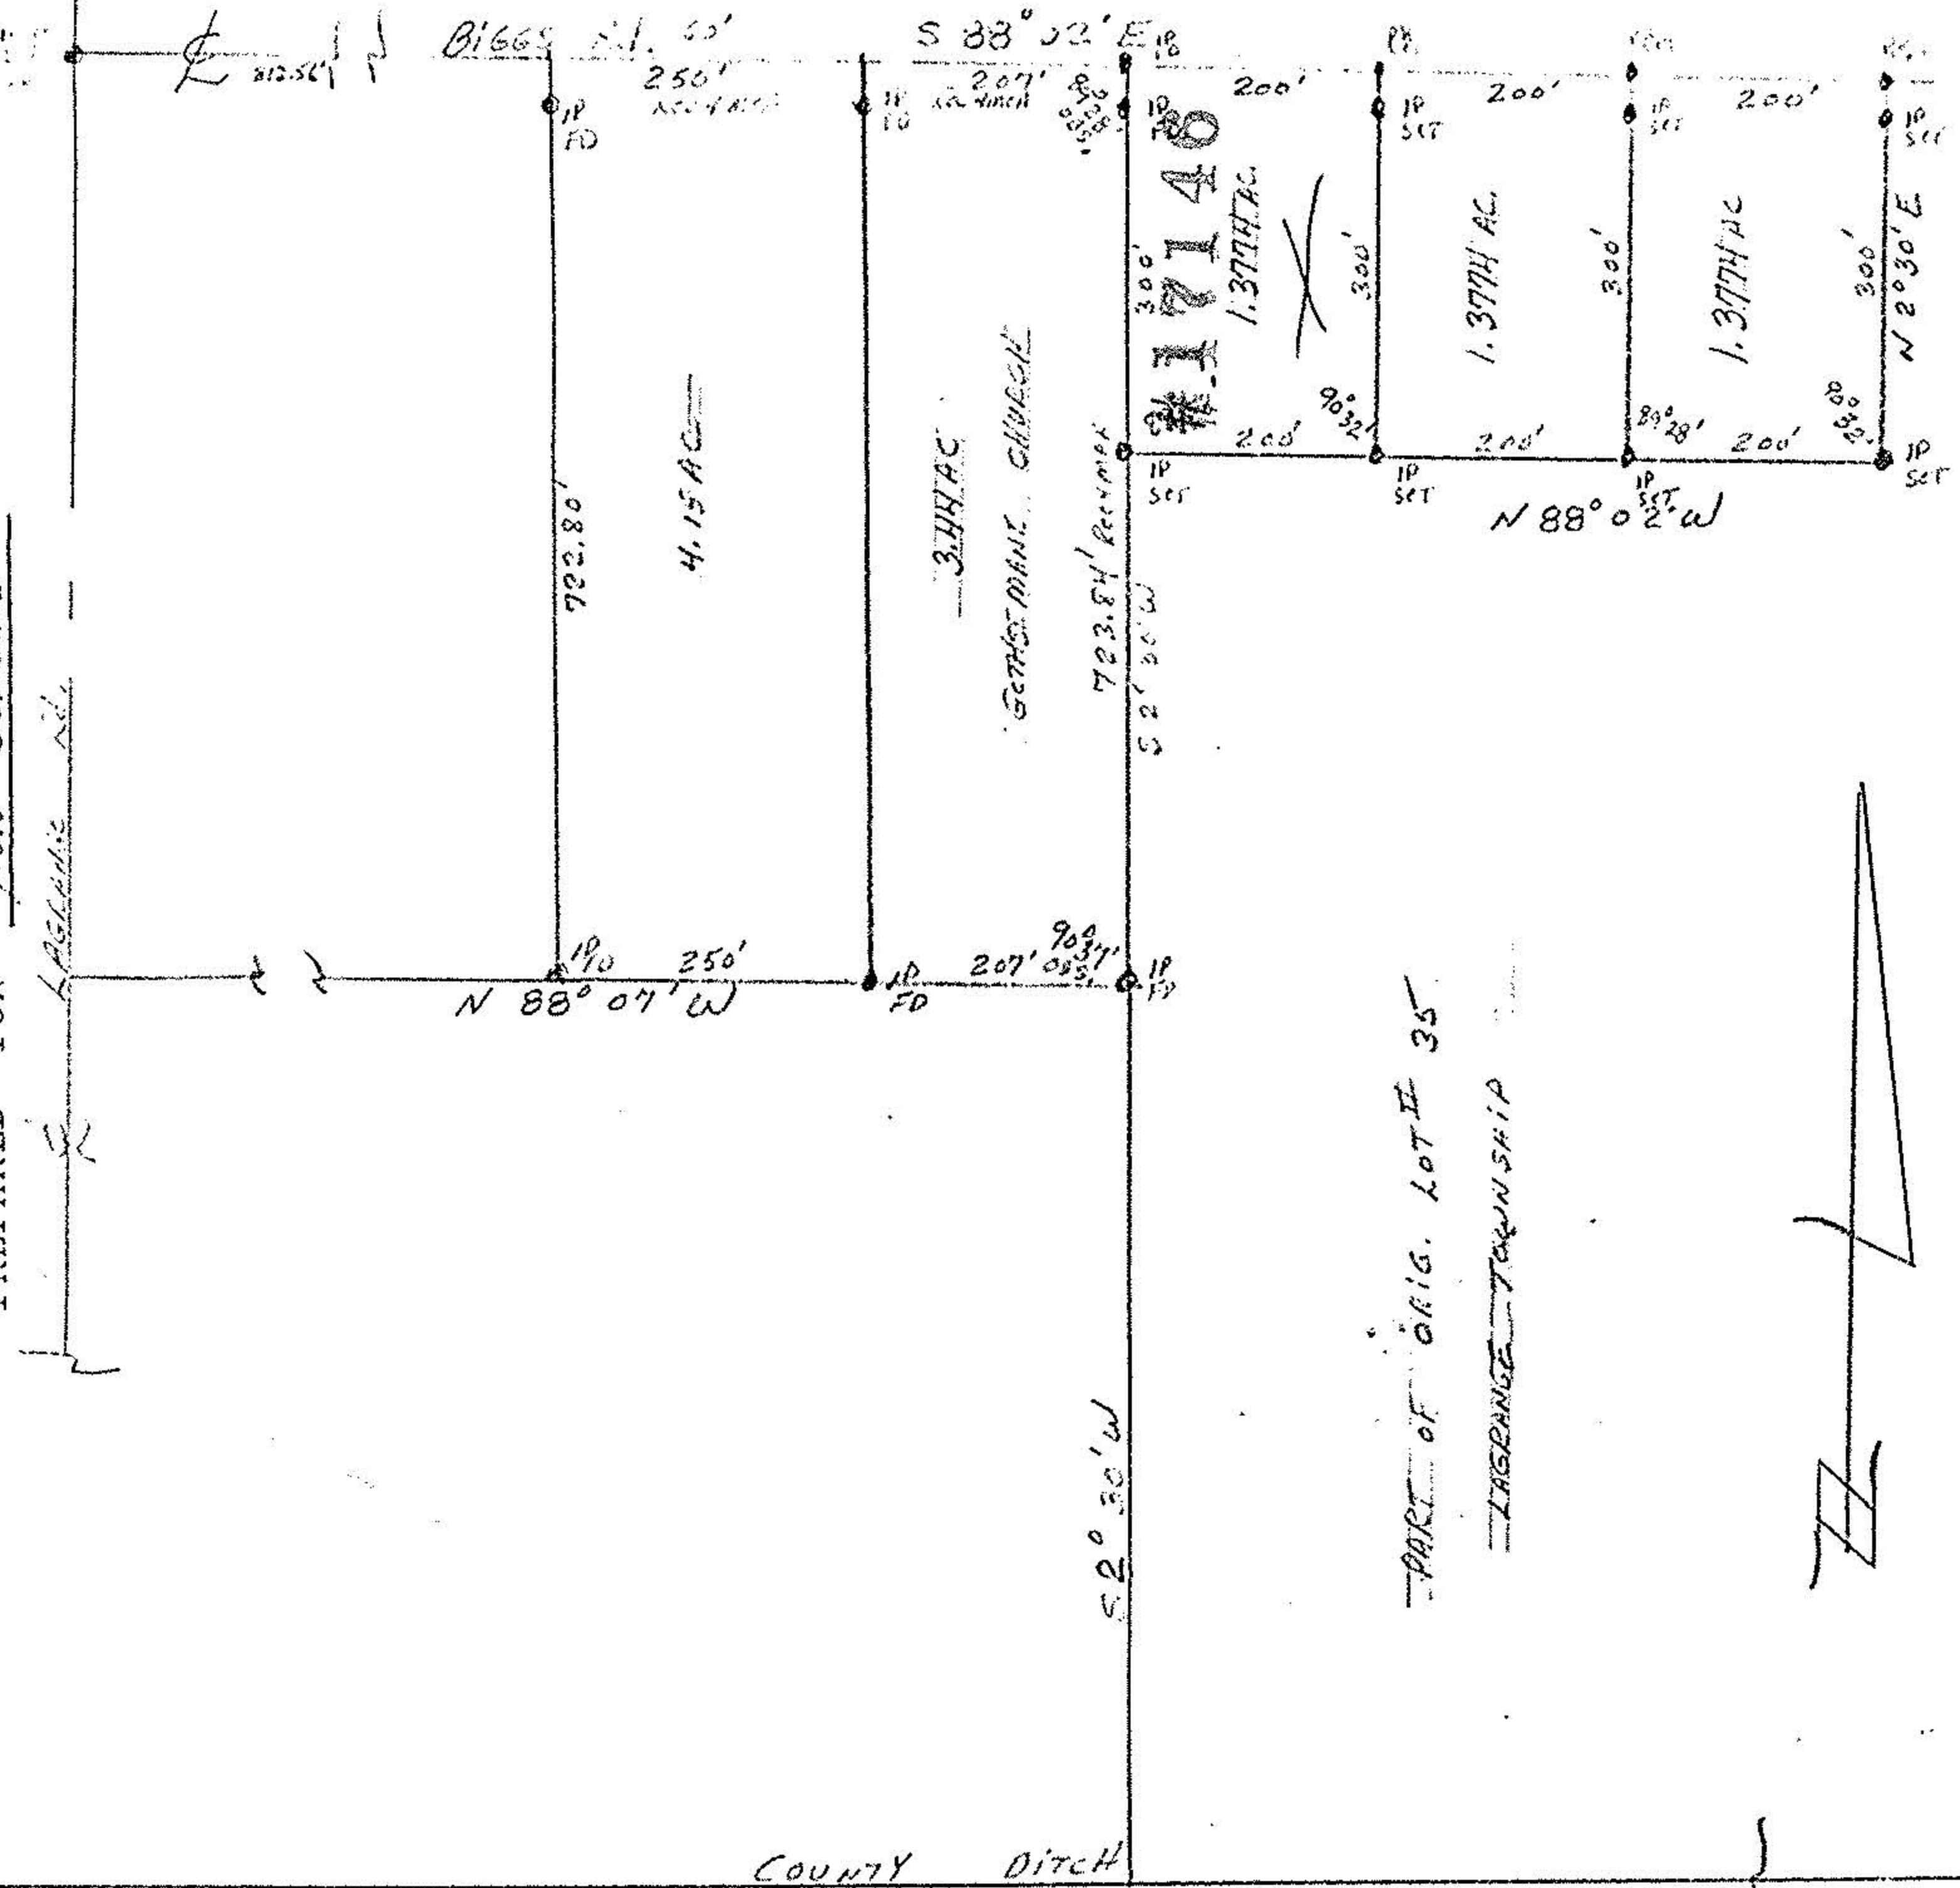

SCALE: 1"=200'

17146

| |
|-------------------------------------|
| APPROVED LORAIN CO. MAP DEPT. |
| DATE <u>12-24-86</u> |
| PAGE <u>15-C</u> |
| BY <u>C FRANKS</u> |
| VOID AFTER <u>17146</u> |

DATE: 10-29, 1986

