


15-00-049-000

H 12202

- 1/2's fd or set
- 1/2's set 30.00 from E

52.77 Acres

Joseph & Elizabeth French
Deed Volume 279 page 68

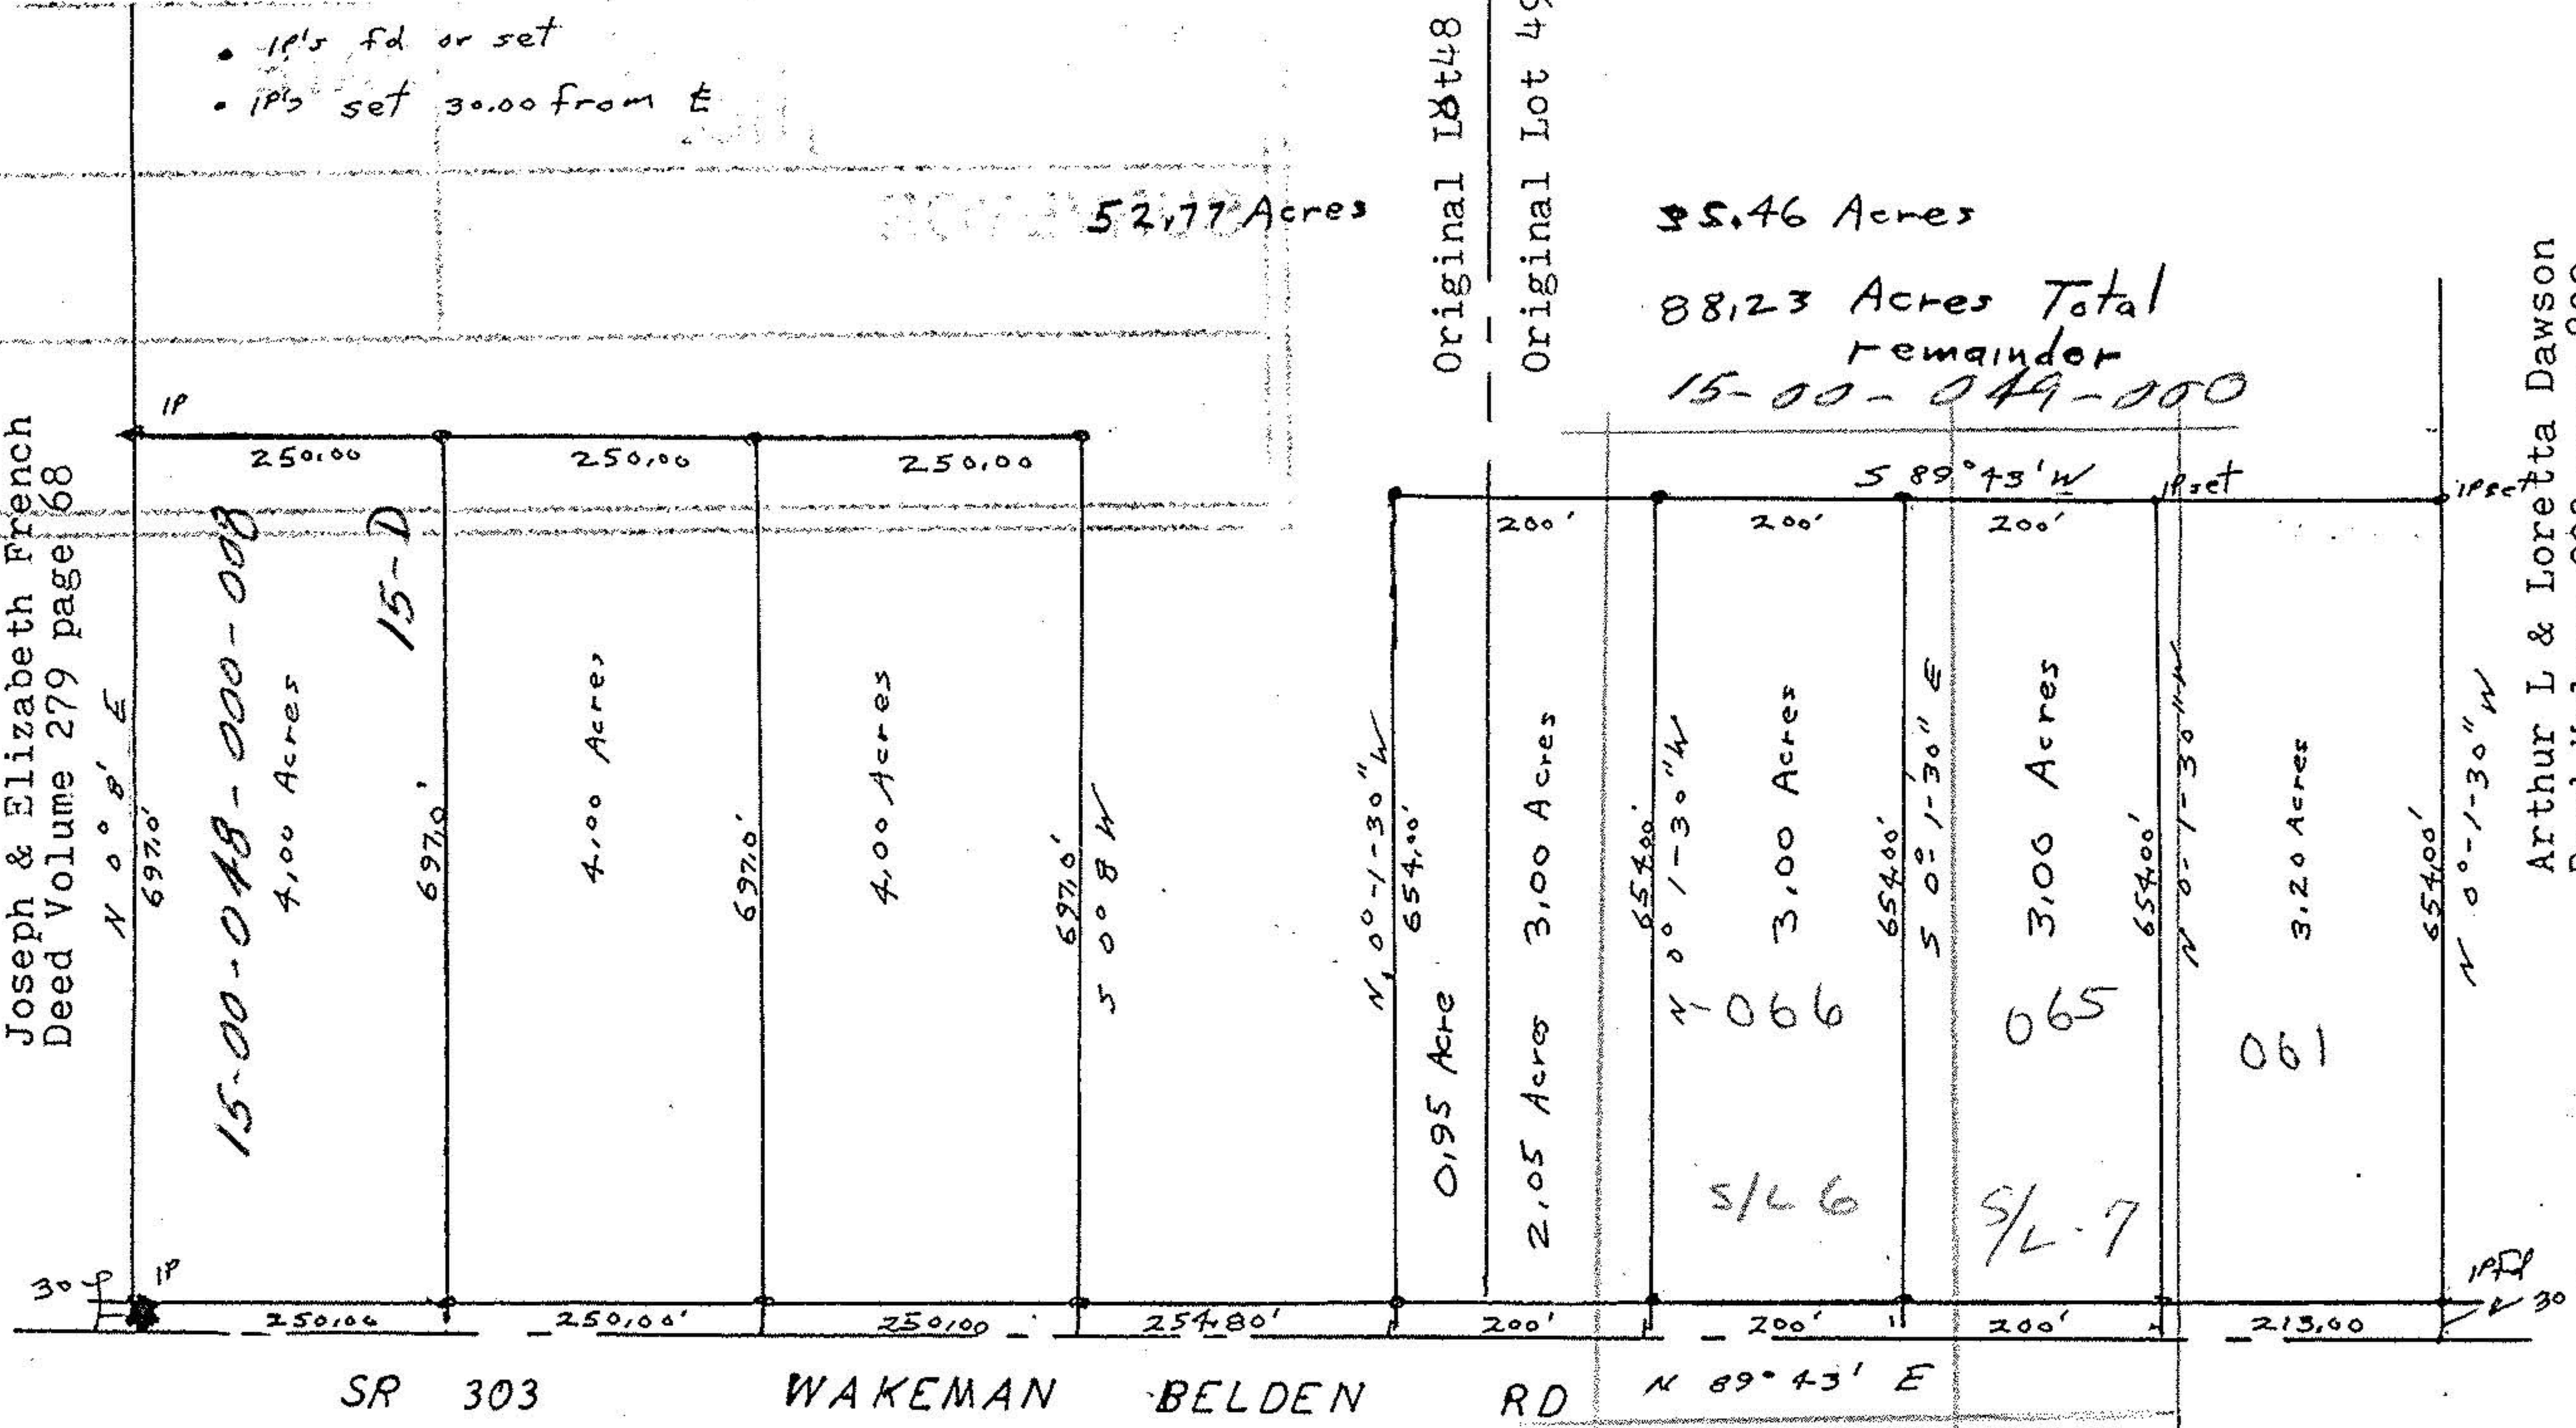

85.46 Acres
 88.23 Acres Total
 remainder
 15-00-049-000

Arthur L & Loretta Dawson
 Deed Volume 923 page 809

SR 303 WAKEMAN BELDEN RD N 89° 43' E

John Pozywak
 Reg Surveyor
 #5292

11-6-78
 15-00-049-A

Survey for Frank Mohr
 Part of Original Lot 48, 49
 LaGrange Township
 Lorain County, Ohio
 scale 1" = 200' April 1978

12202