


15-00-050-000

Split # 15160

\* NOTE: THE DIMENSION CIRCLED IN RED WAS CHANGED ON THE DEED WHICH WAS USED TO SPLIT PROPERTY WITHOUT JOHN POZYWAK BEING INFORMED OF SAID CHANGE IN HIS SURVEY. SEE H.J. MITOCK (OHIO BAR TITLE) ABOUT THE SOURCE 110.02 OF THE CHANGED DIMENSION.

# 15160

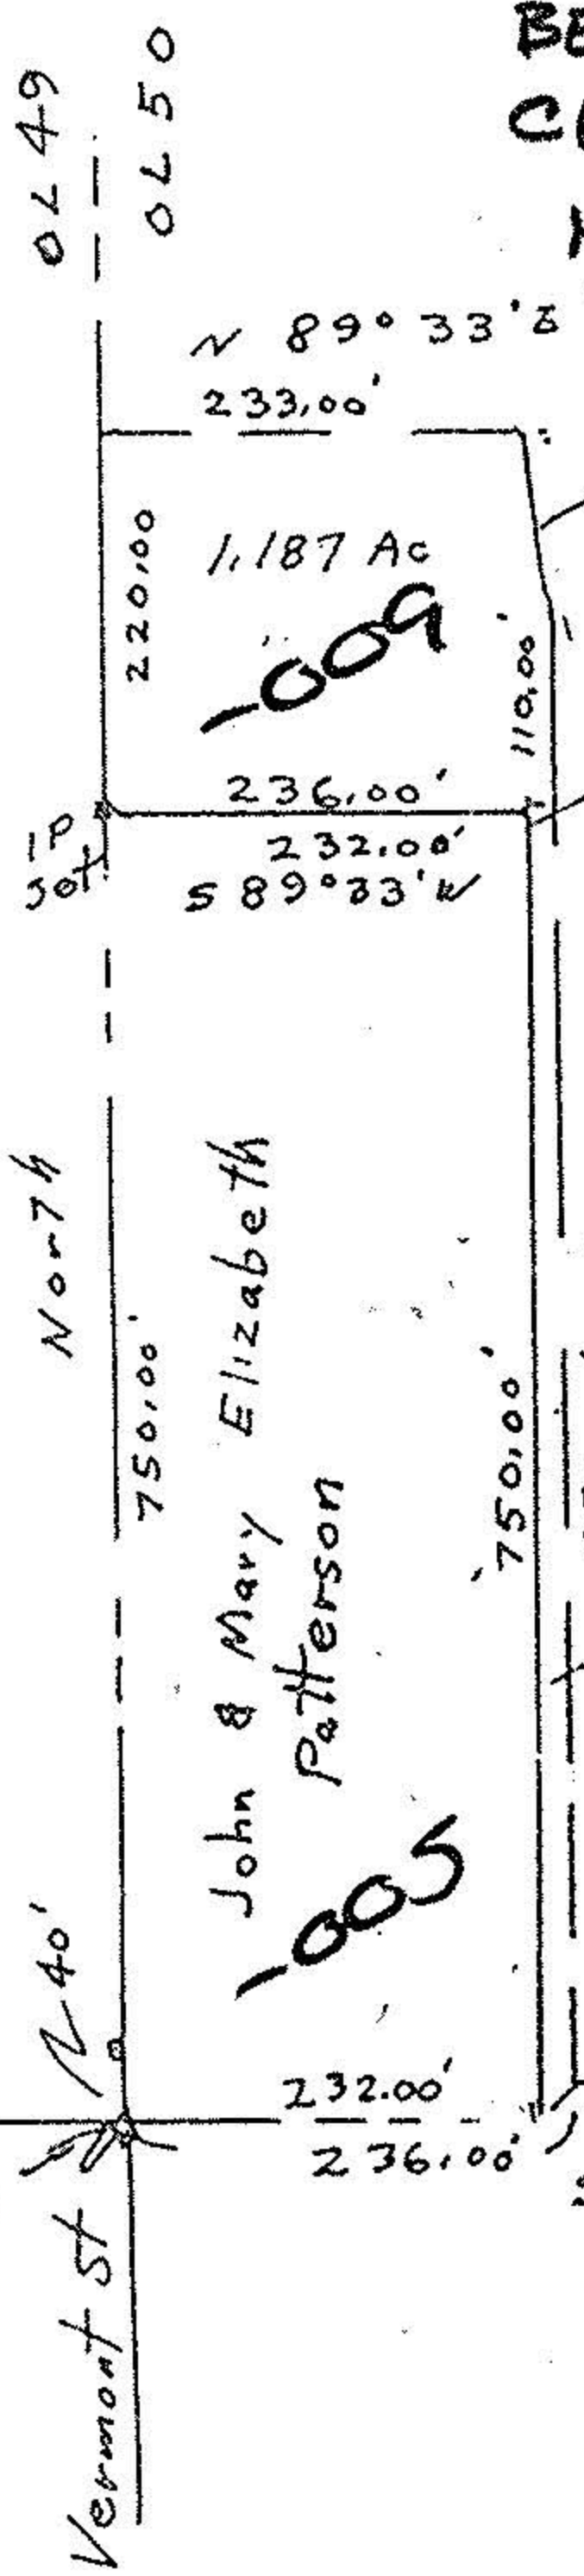

#15160

Ballard & Gwendolyn Jewell

APPROVED LORAIN CO. MAP DEPT.
DATE 7-11-83
PAGE 15-D
BY <i>[Signature]</i>
VOID AFTER 15160

APPROVED LORAIN CO. MAP DEPT.
DATE
PAGE
BY
VOID AFTER

John & Mary Elizabeth Patterson

0.069 Acre

Wakeman Bolden Rd  
SR 303

15-D

069  
1-1987  
1-256

John Pozyswak  
Reg Surveyor  
# 5292

Survey for John Patter  
Part of Original Lot 50  
La Grange Twp  
Lorain County Ohio  
Scale 1"=200' May 28, 1983