


206
Mura



- o iron pipes or pins fd
- iron pins set
- x PK nails

John
Pozywak
Surveyor
5292

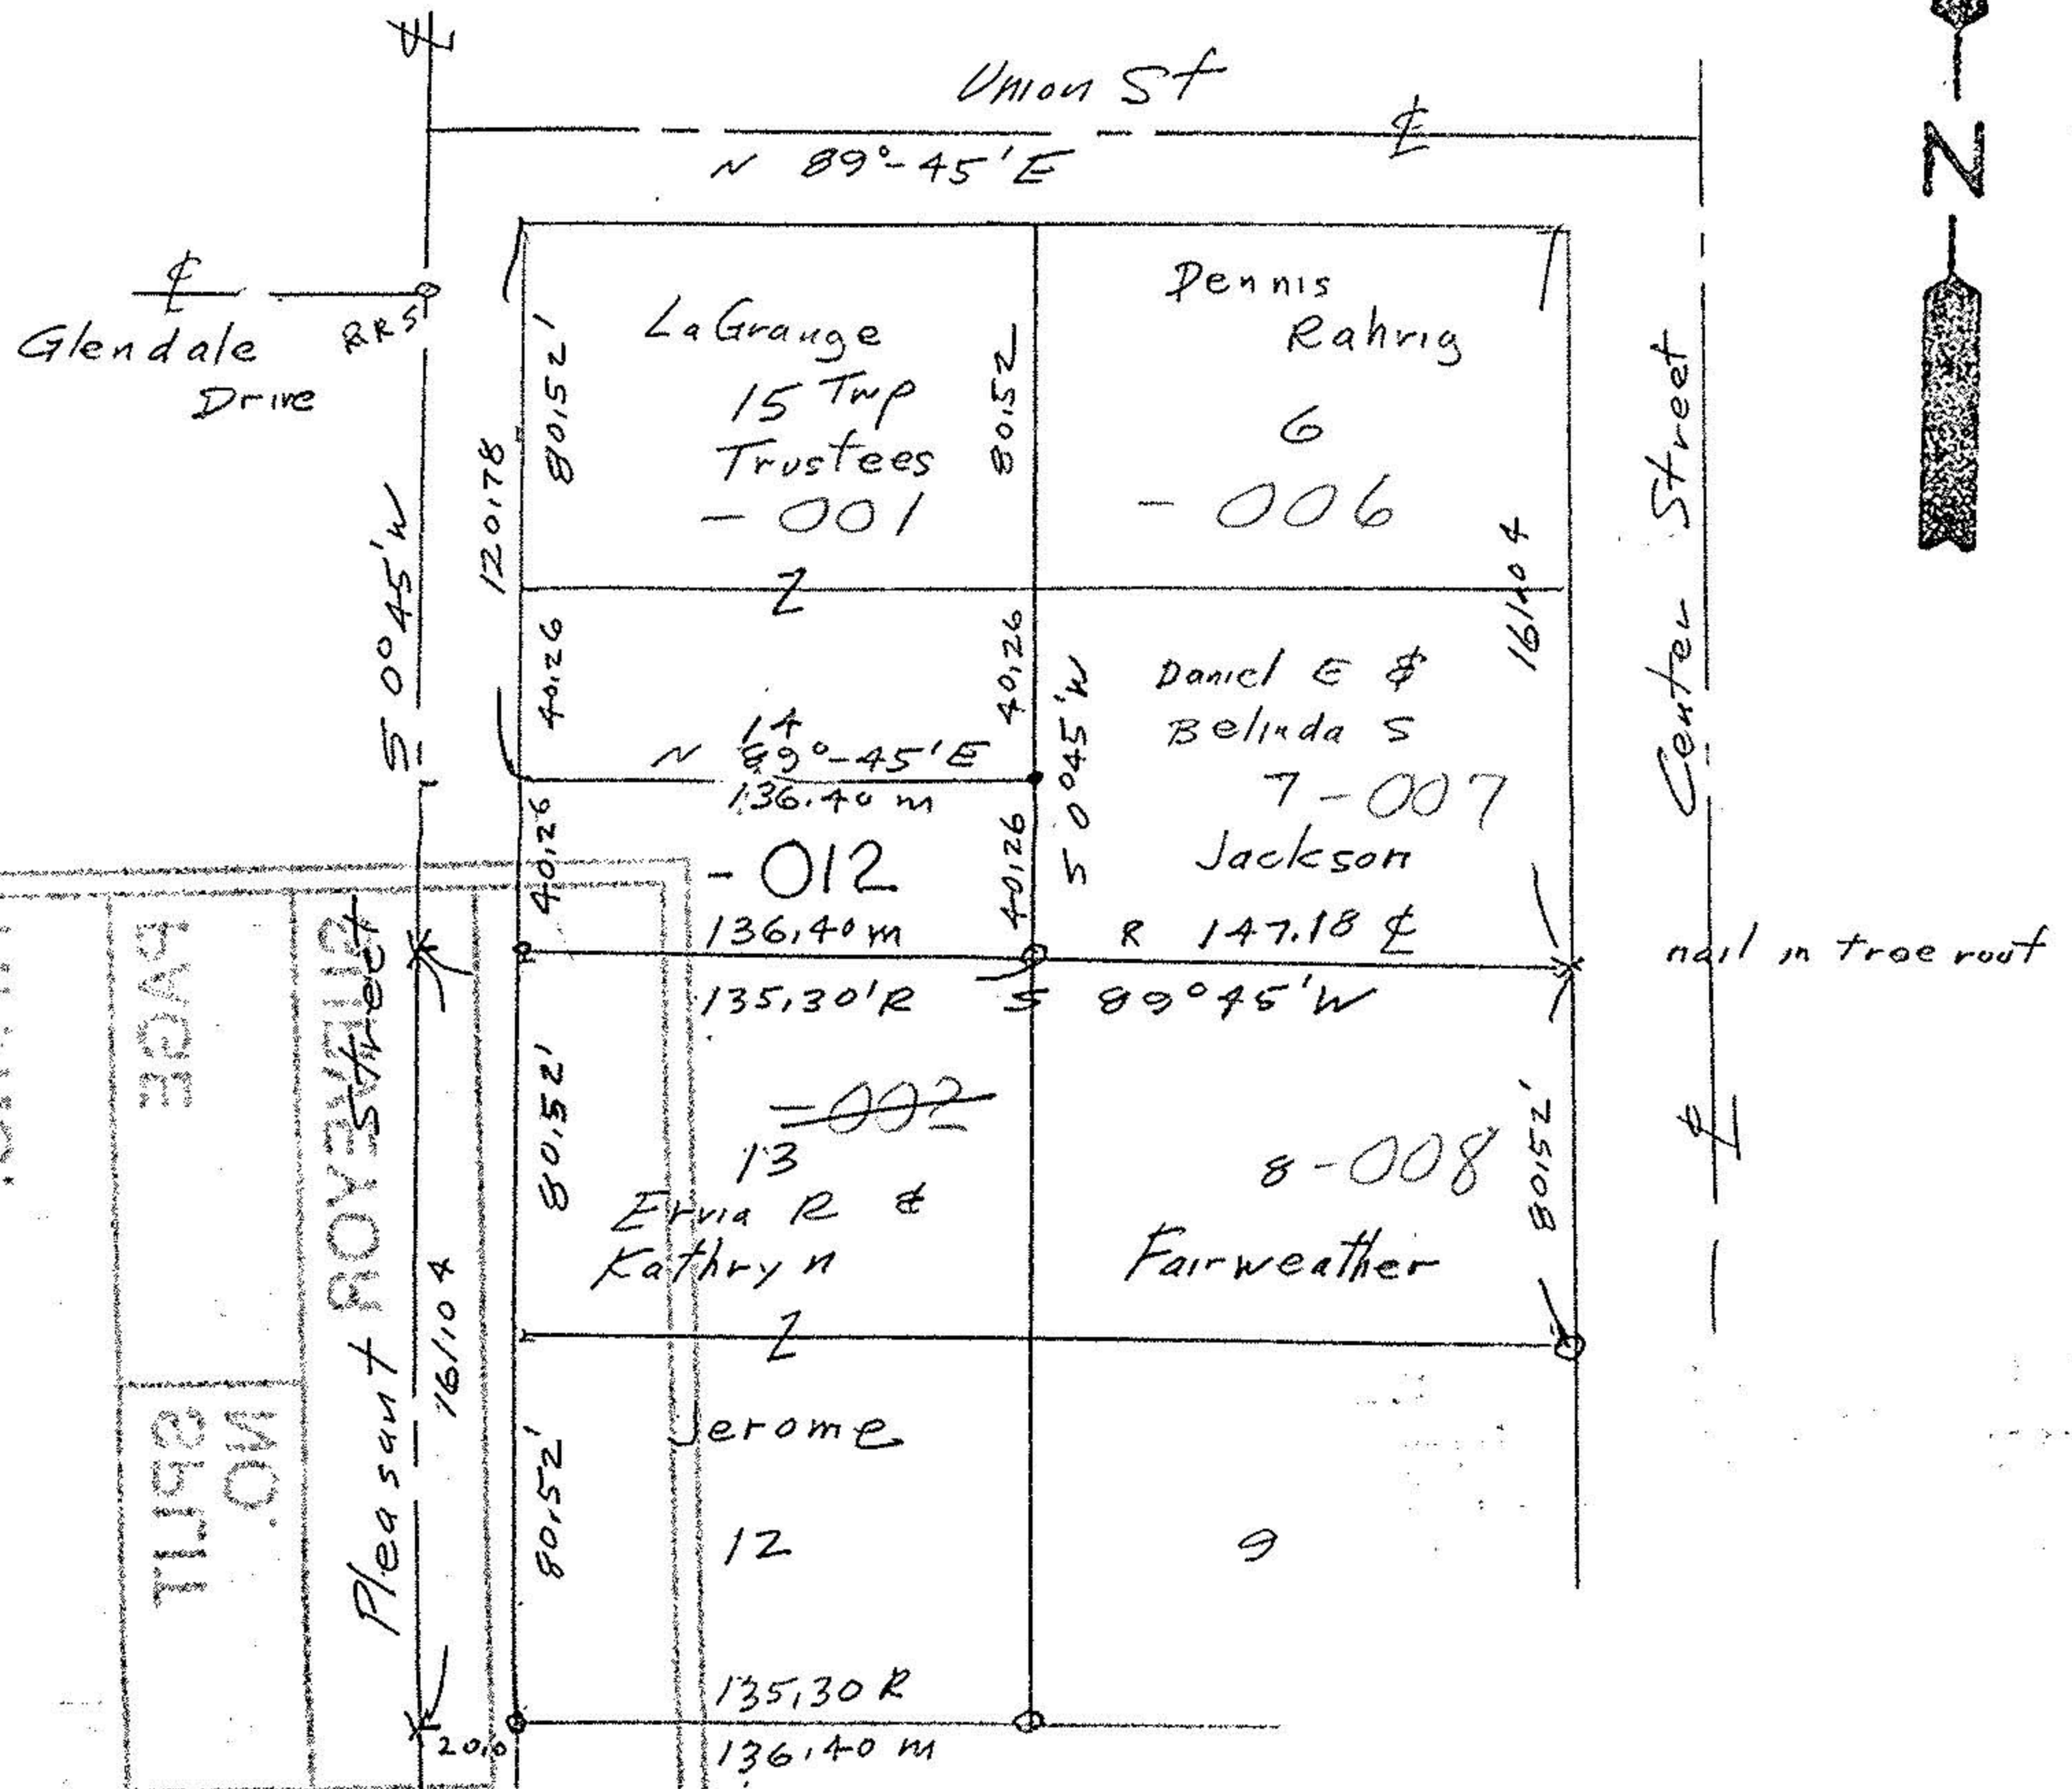

Survey of south half subplot 14
Grant's Addition
Plat Vol 1 Pg 30
Original LaGrange Twp Lot 56
Lorain County, Ohio
Scale 1" = 60' Jun 4, 1995