


CARDINAL SURVEYS
 PLAT OF SURVEY
 PREPARED FOR JERRY CAMP
 LAGRANGE TOWNSHIP O. L. NO. 57

15-00-057-000
 #18173
 15-F
 06.57

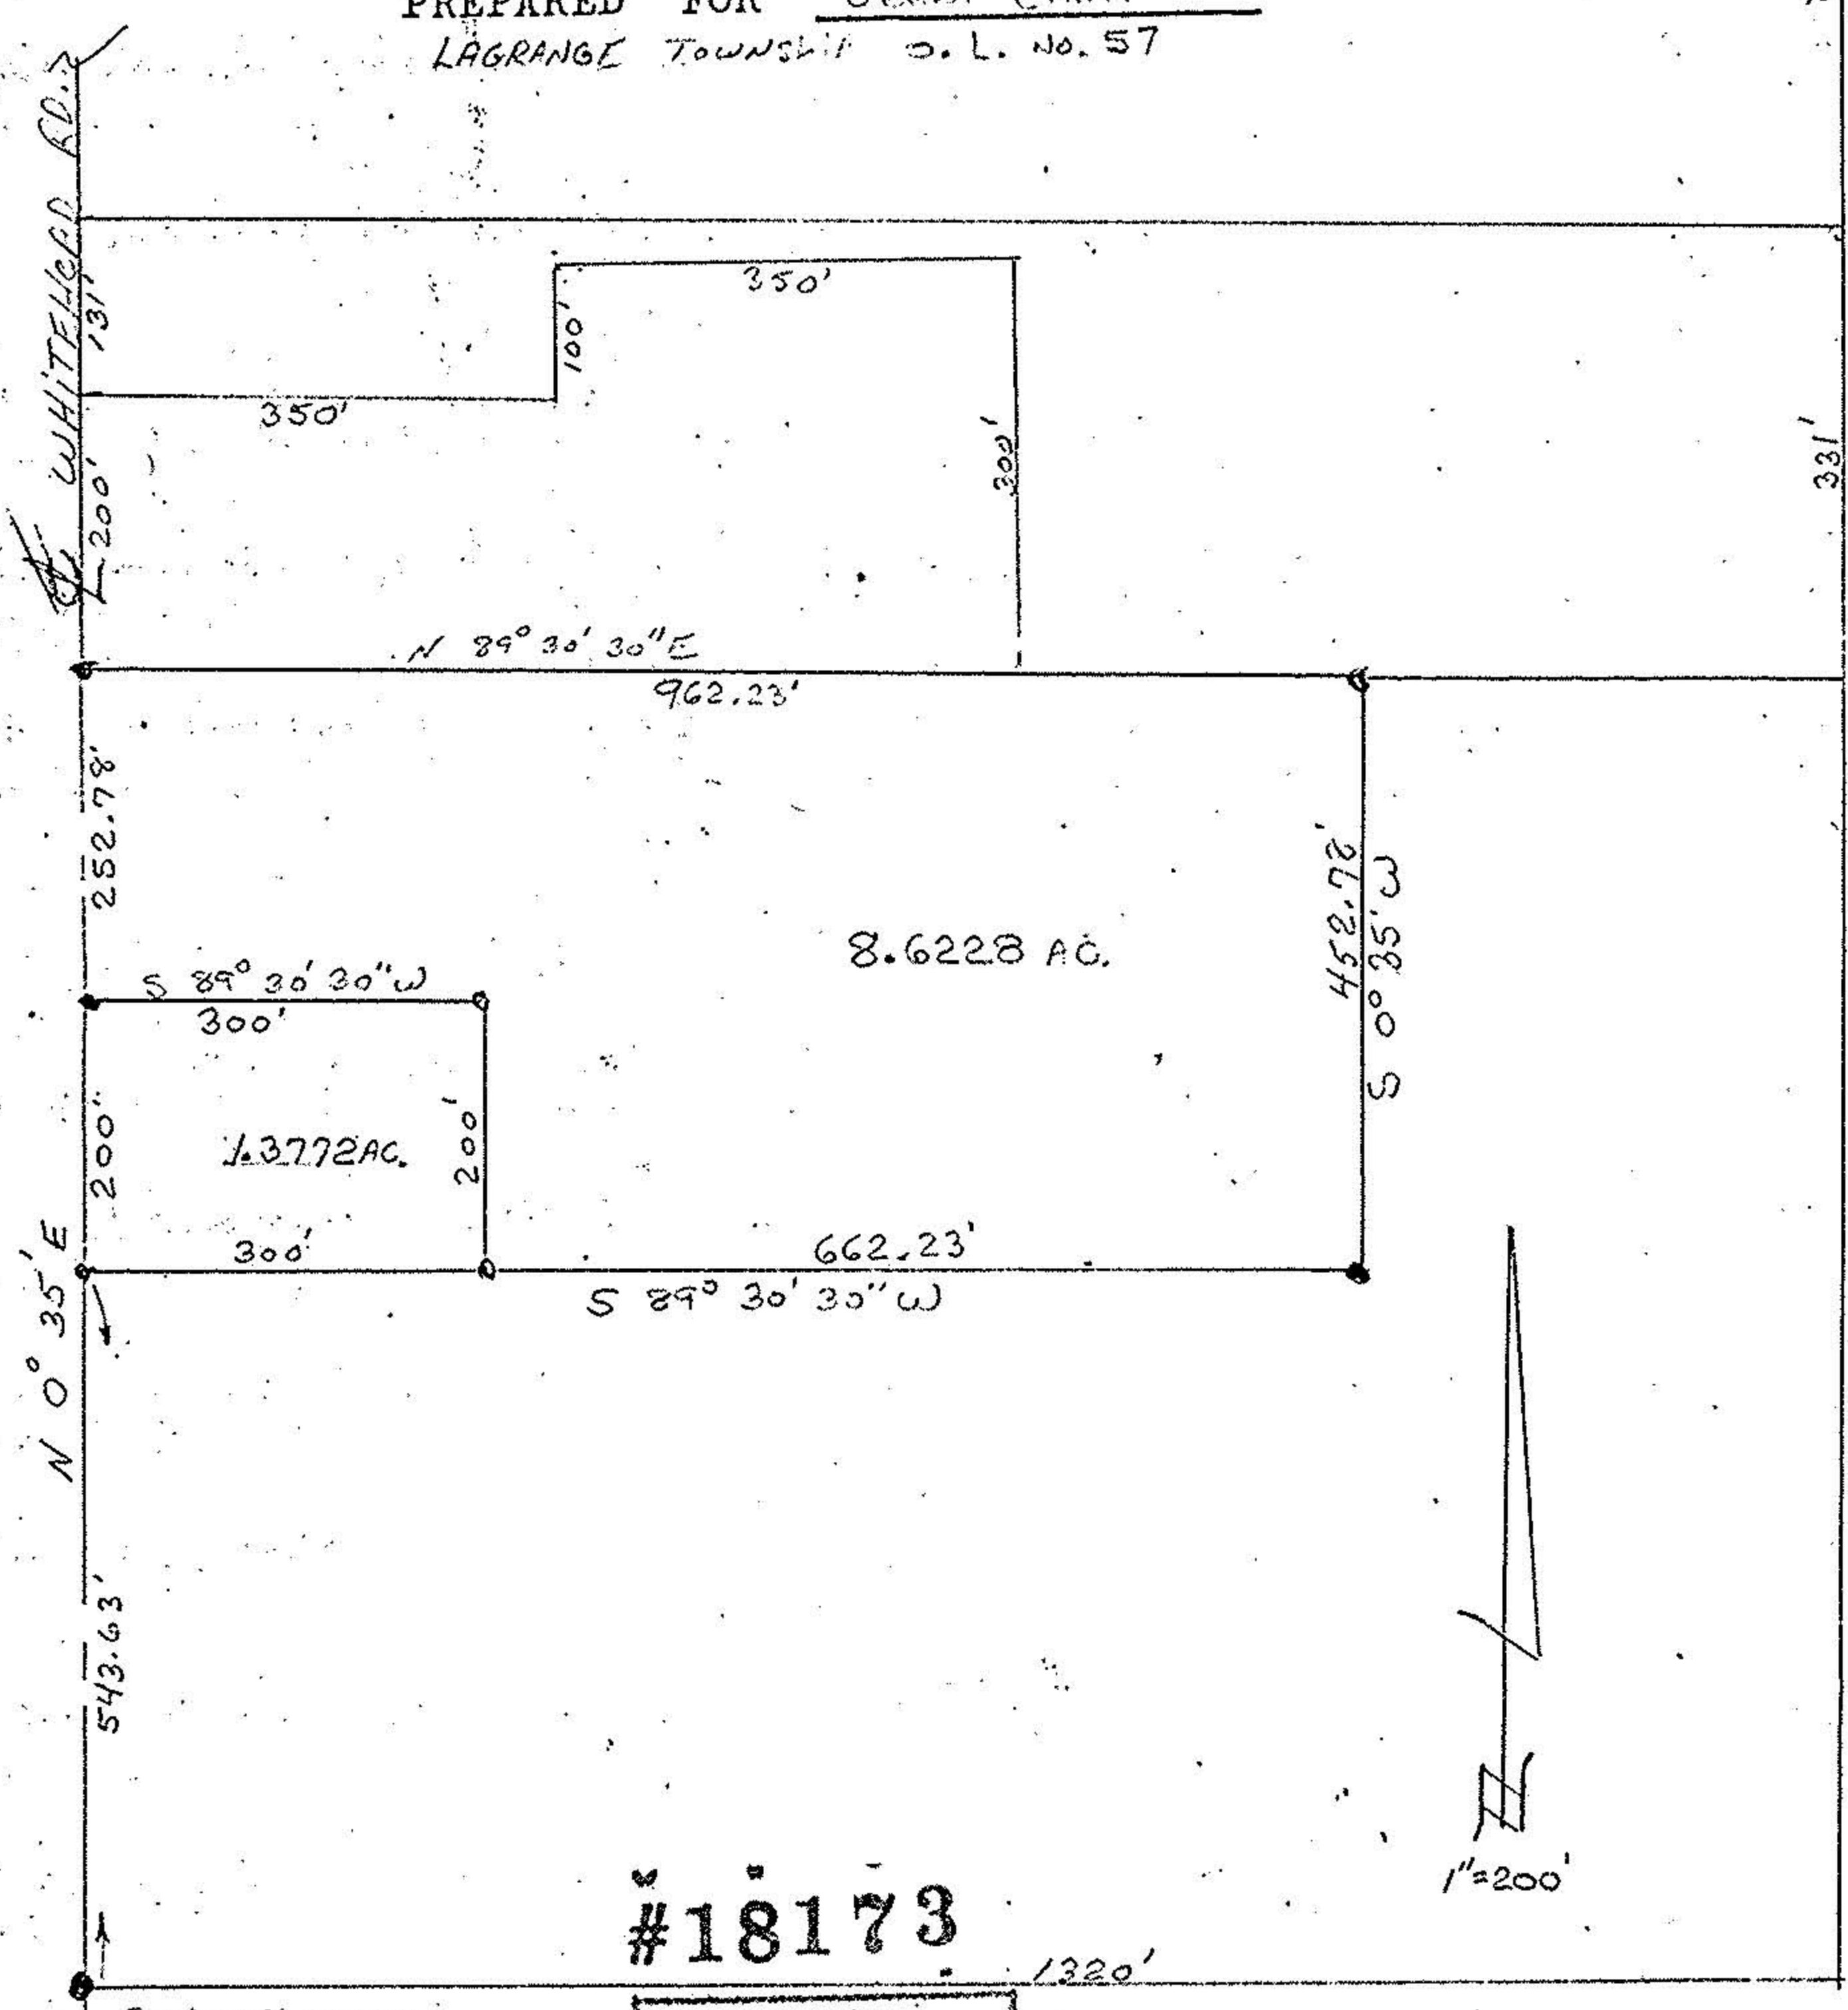

#18173

APPROVED
 LORAIN CO.
 MAP DEPT.
 DATE 10-11-88
 PAGE 15-F
 BY T. McMain
 VOID AFTER 18173

DATE: Oct. 3, 1988



SCALE: 1" = 200'