


MAP OF SURVEY FOR MIKE SAUTER
 GRAFTON TWP. - D.L. #60 - LORAIN CO.,
 MAY 1991
 JOHN R. HAMILTON - REG. SURV. #6861
 SCALE 1"=100'

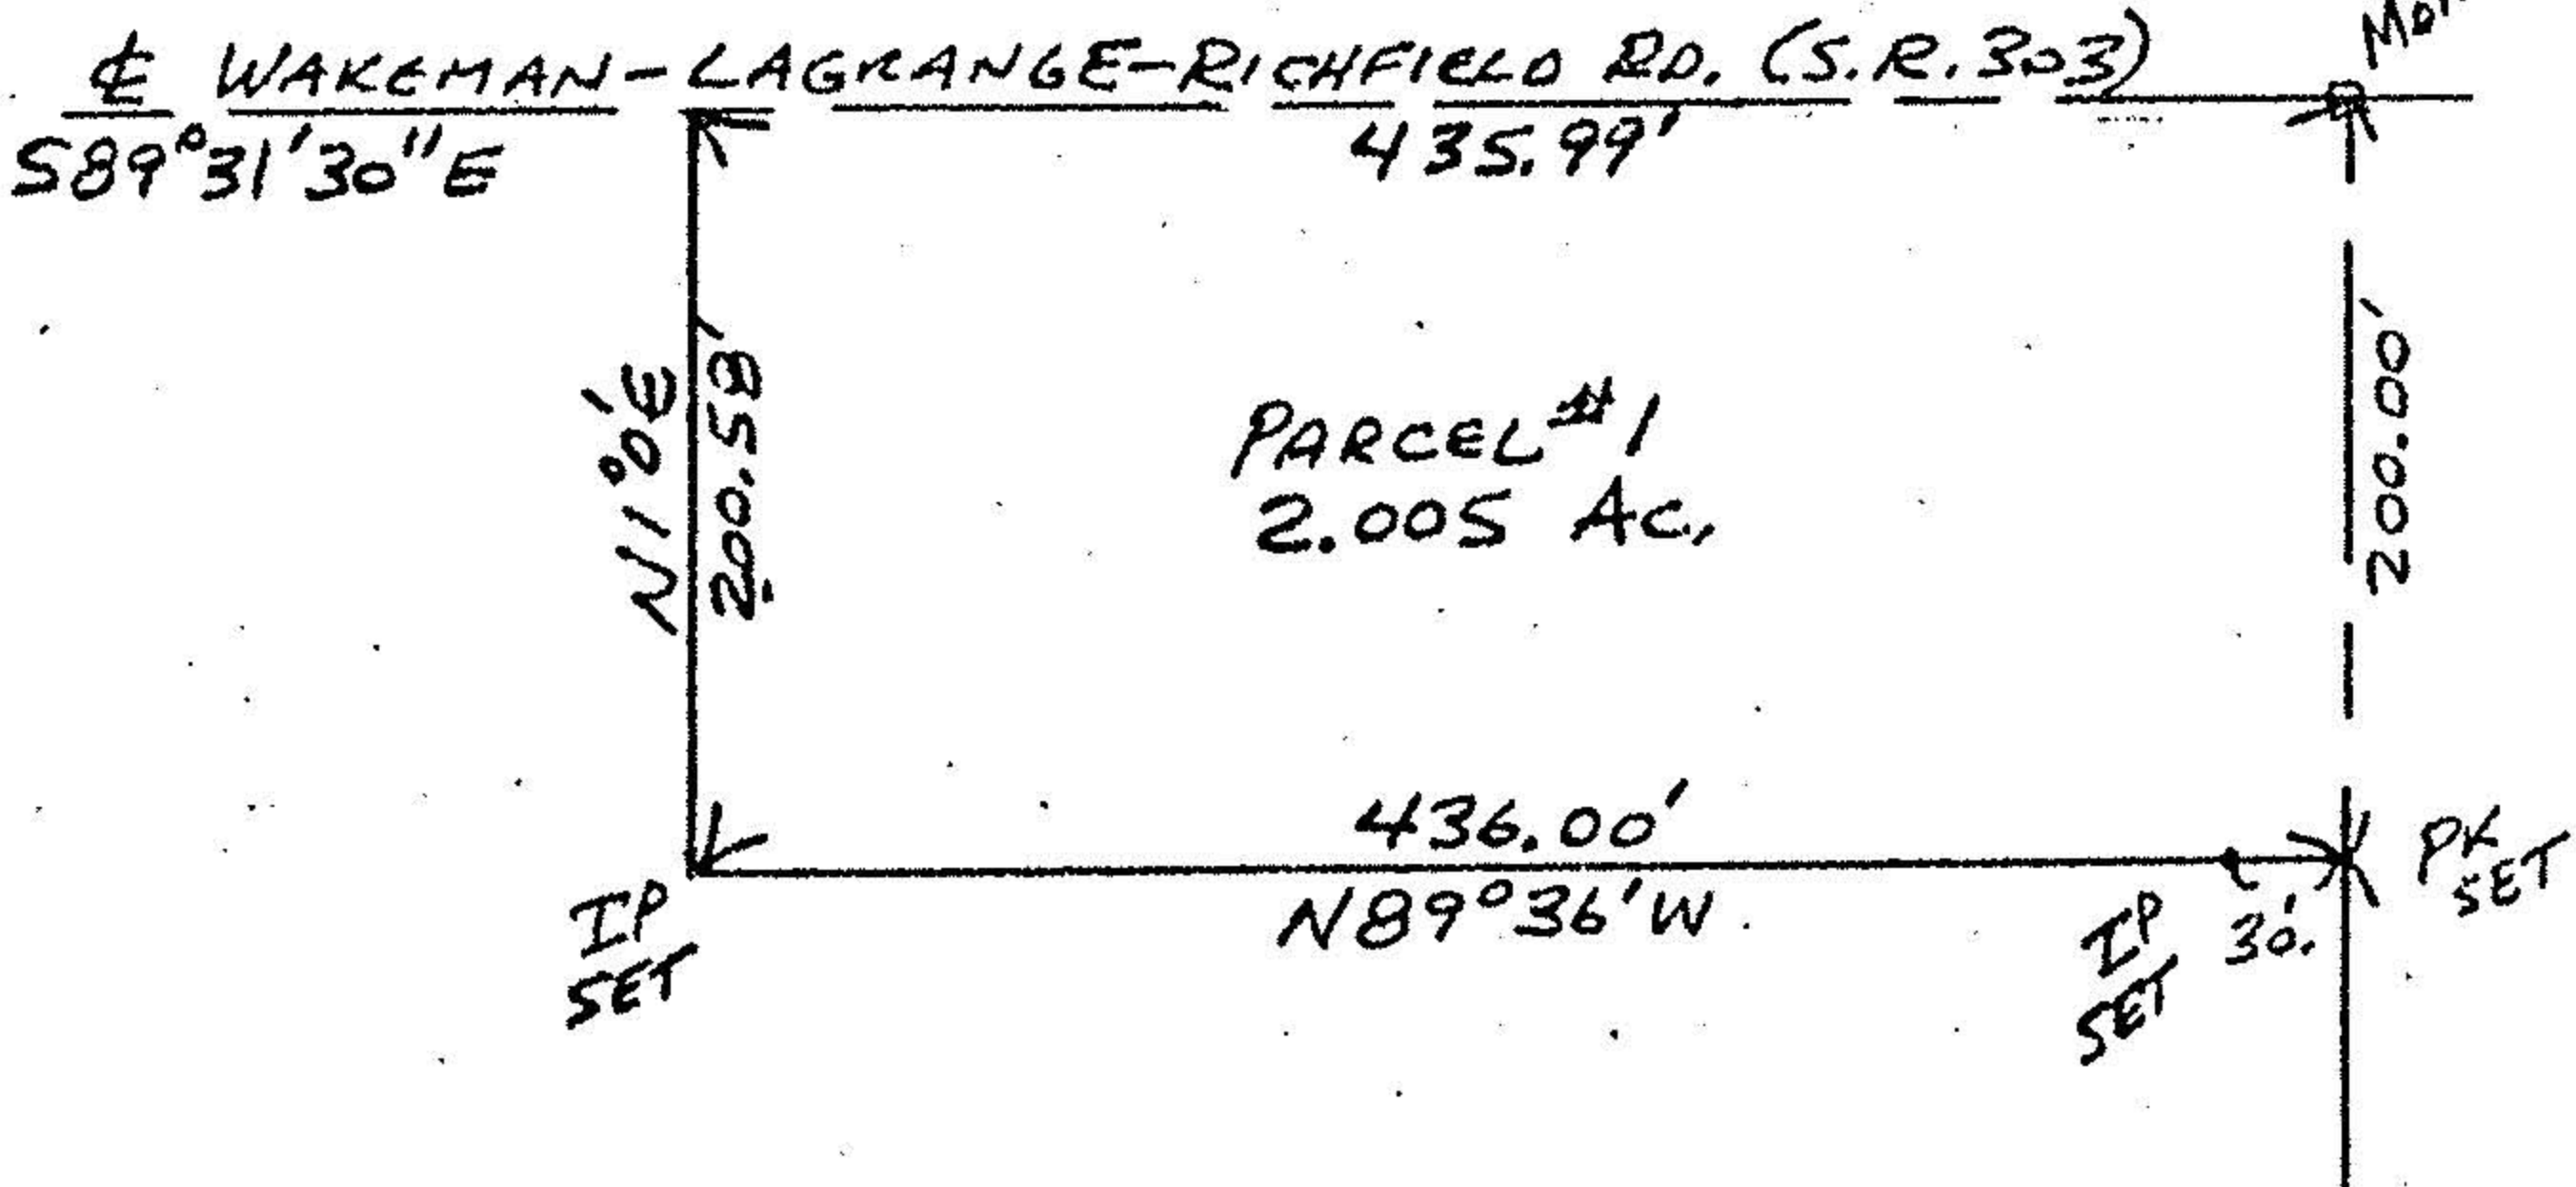

16-00 - 060 - 000 -
 19624
 16-E

NORTH
 SCALE 1"=100'

CHAMBERLAIN LAND Co.
 O.R. VOL. 246, P. 52 19624
 142.32 Ac. ORIG.
 138.313 Ac. REM.

APPROVED LORAIN CO. MAP DEPT.	
DATE 10-24-91	
PAGE 16-E	
CAROLYN BY FRANCIS	
VOID AFTER #	19624

