



16-00-060-000-2  
# 19467  
16-E 000-000-000

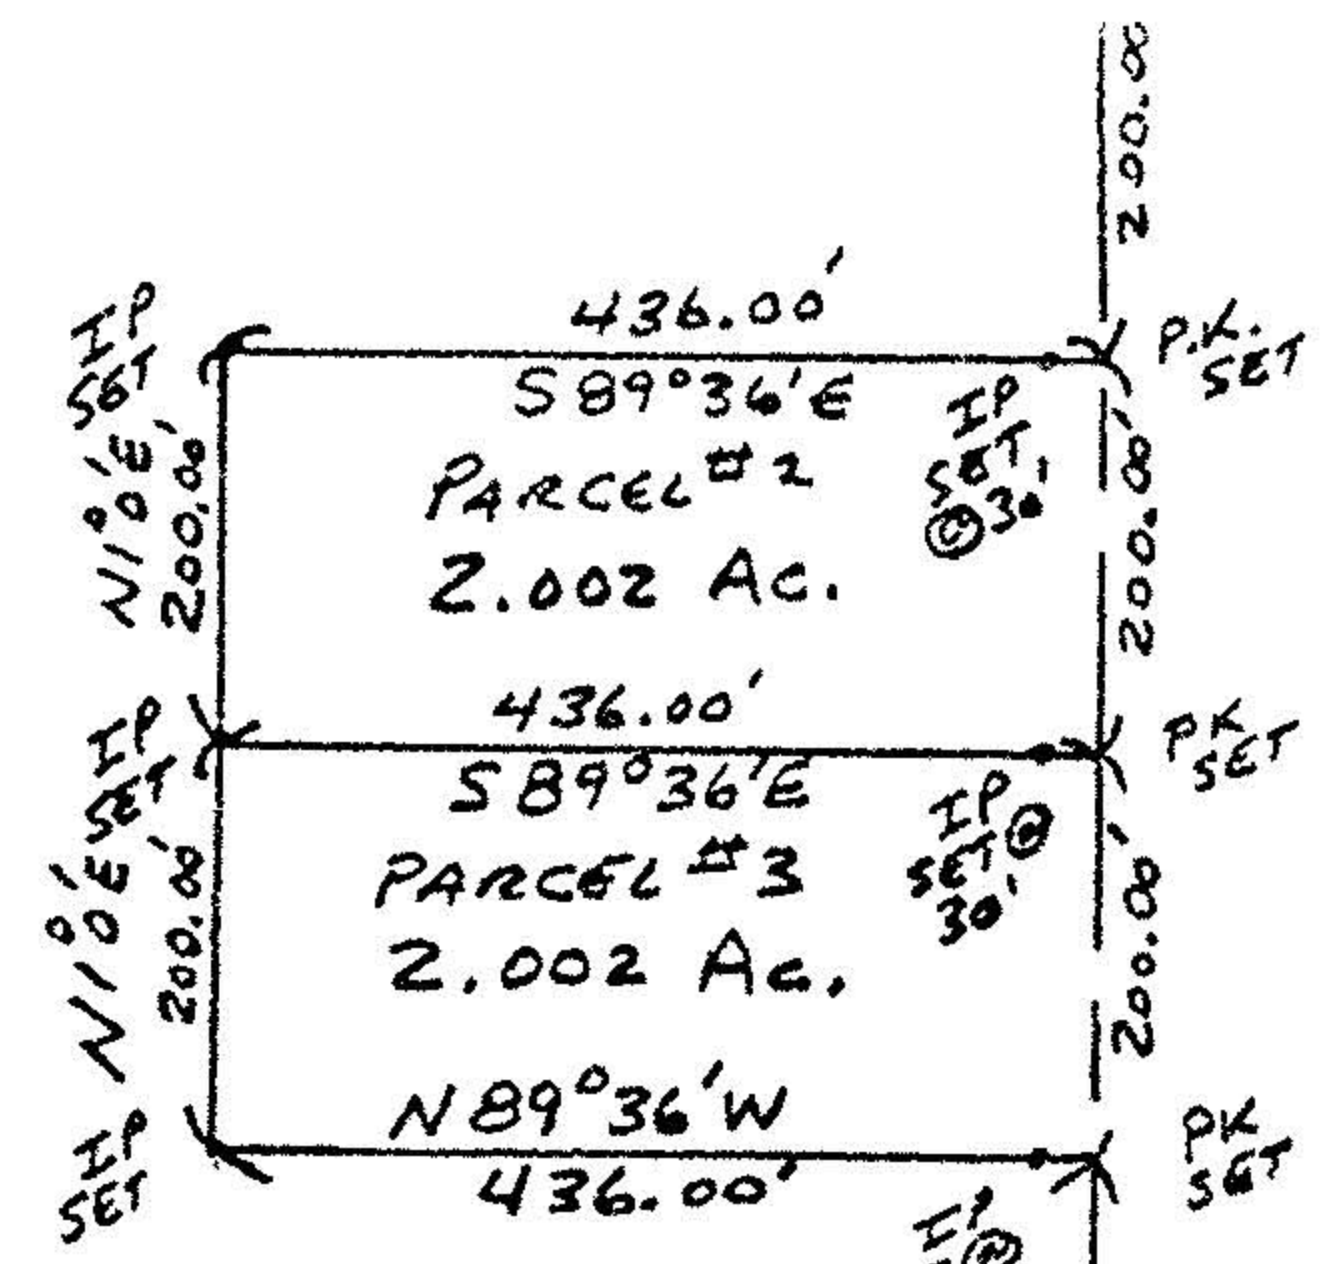

CHAMBERLAIN LAND CO.  
O.R. VOL. 246, P. 52  
142.32 AC. ORIG.  
136.316 AC. REM.

NORTH  
SCALE 1"=200'

MAP OF SURVEY FOR MIKE SAUTER  
GRAFTON TWP. - O.L. 60 - LORAIN CO.  
MAY 1991 SCALE 1"=200'  
JOHN R. HAMILTON - REG. SURV. #6861

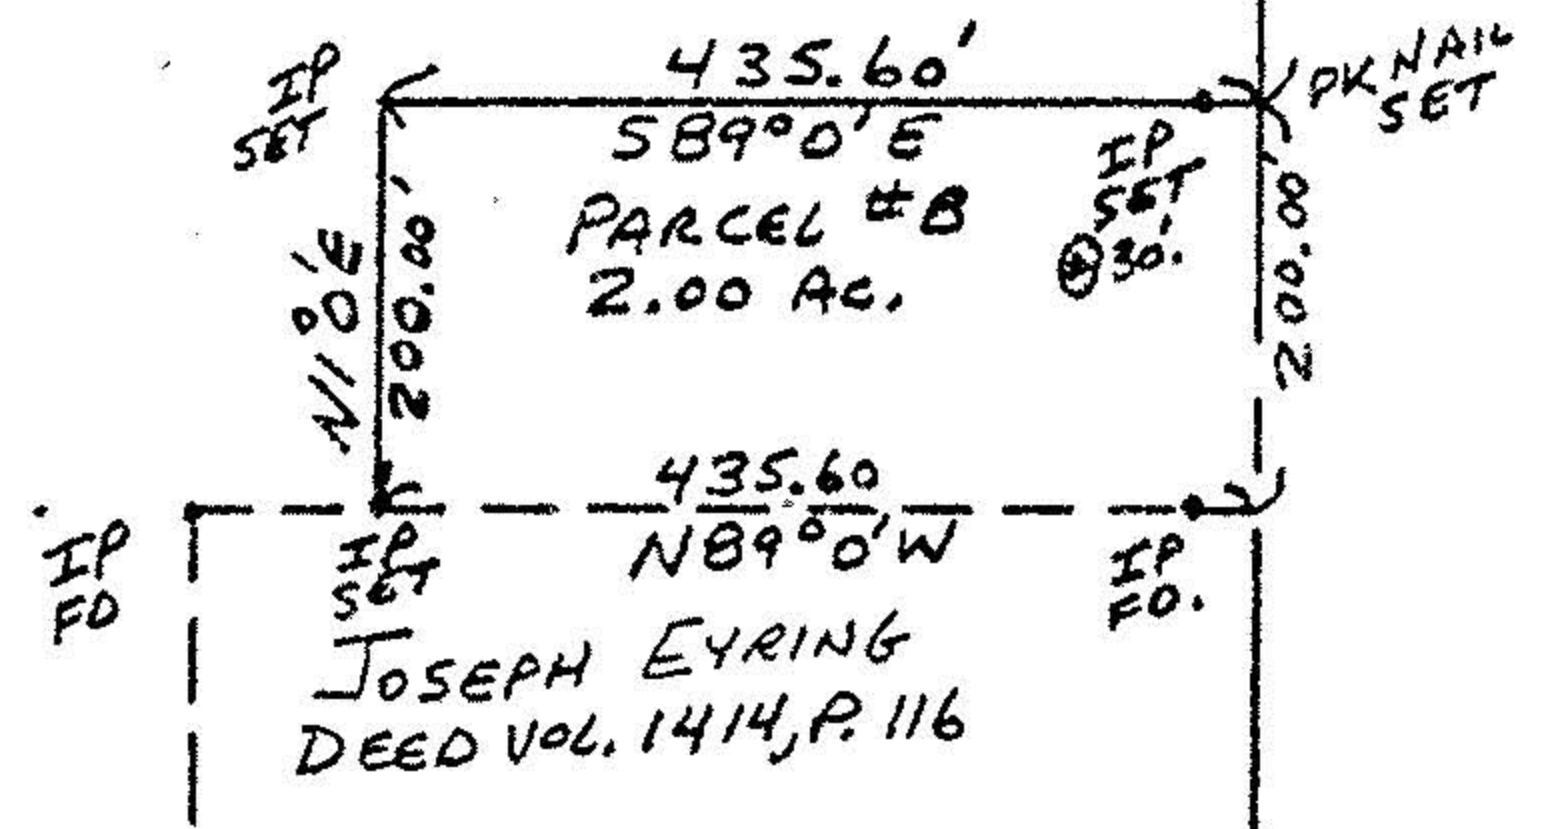

# 19467



APPROVED LORAIN CO. MAP DEPT.	
DATE	7-9-91
PAGE	16 E
BY	CAROLYN FRANCIS
VOID AFTER #	19467