



16-00-072-000-

#19218  
#19248

16H

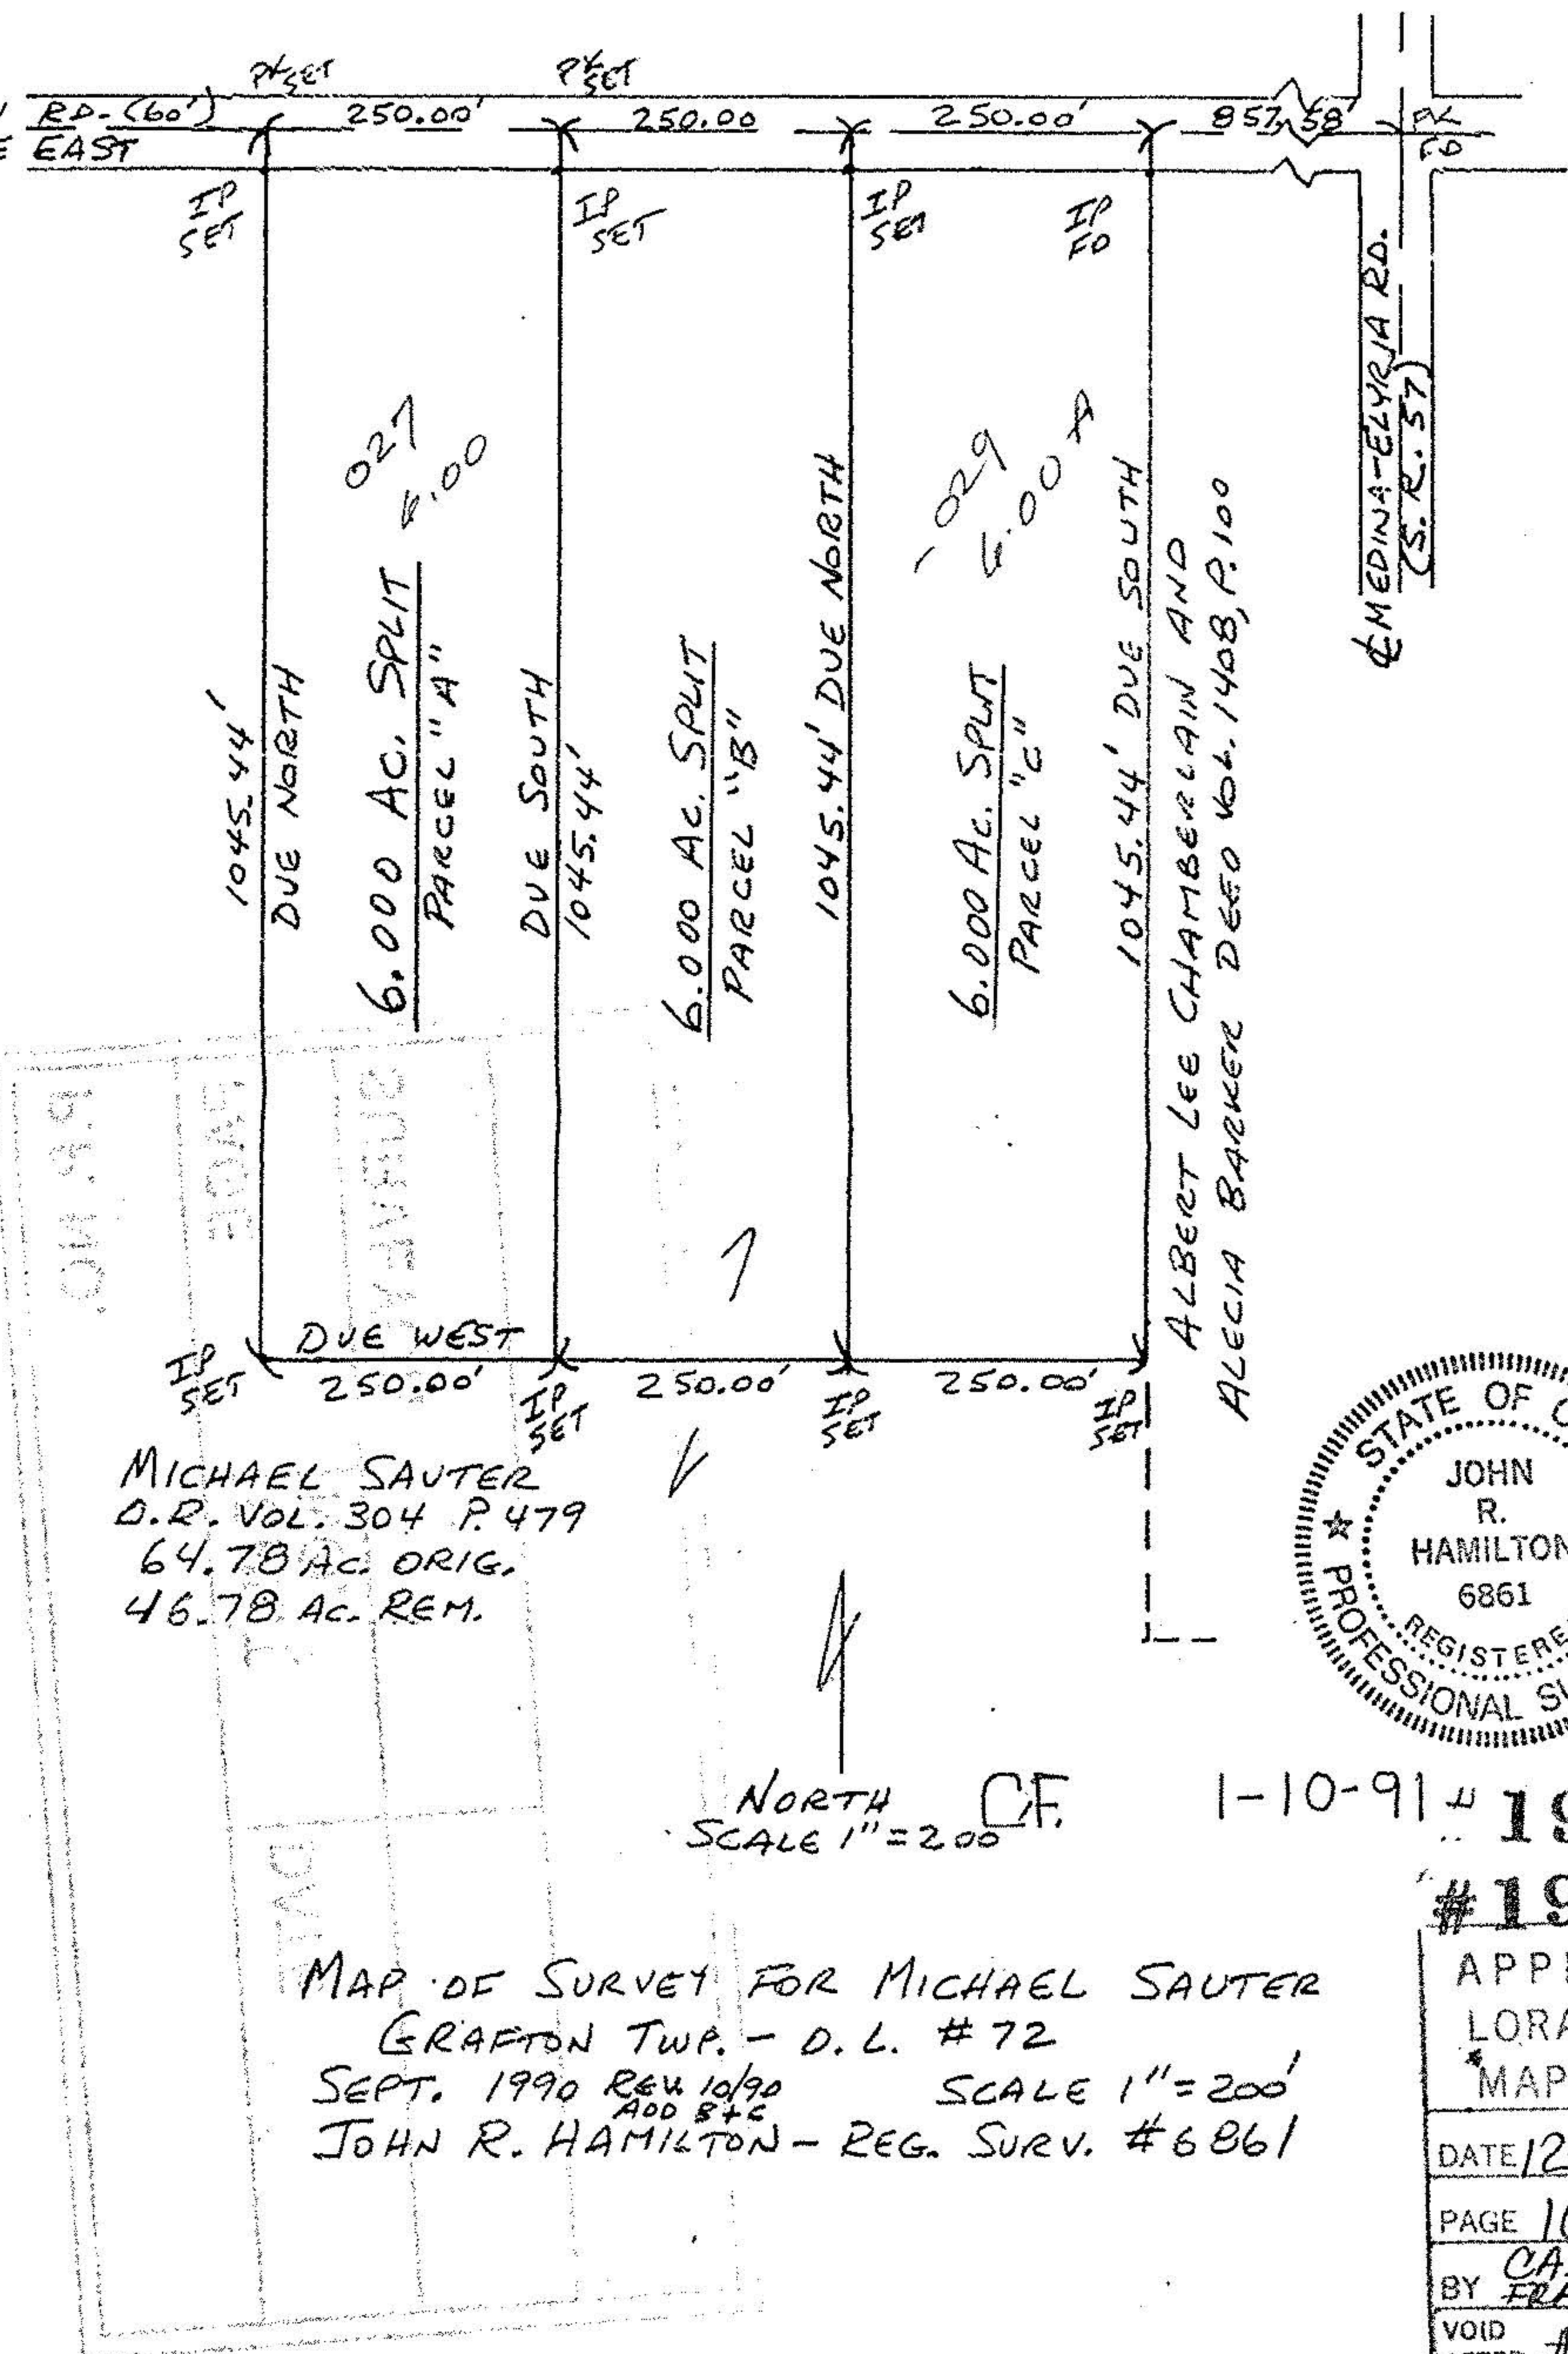

MICHAEL SAUTER  
 D.R. VOL. 304 P. 479  
 64.78 AC. ORIG.  
 46.78 AC. REM.

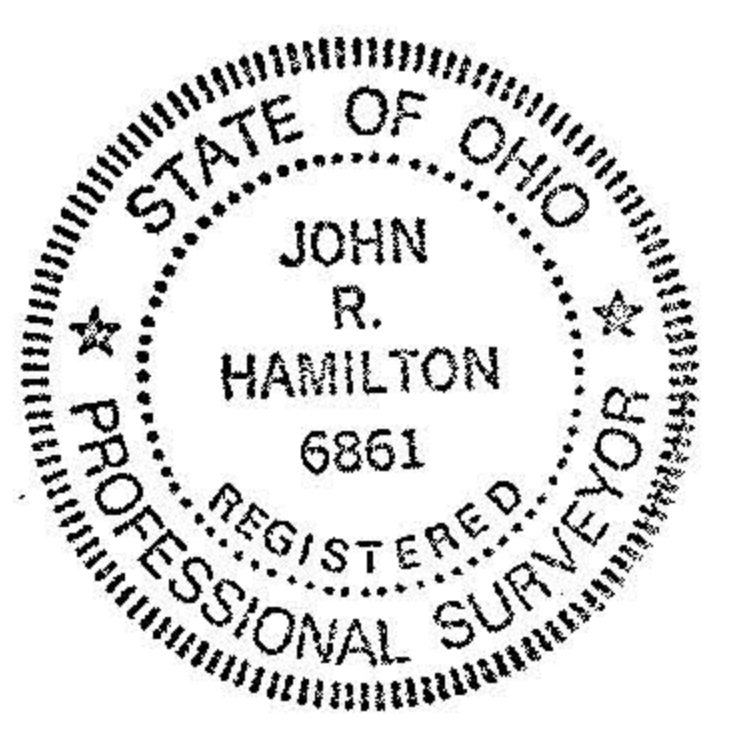

NORTH  
 SCALE 1" = 200'

1-10-91 #19248

MAP OF SURVEY FOR MICHAEL SAUTER  
 GRAFTON TWP. - D.L. #72  
 SEPT. 1990 REV 10/90 SCALE 1" = 200'  
 JOHN R. HAMILTON - REG. SURV. #6861

#19218
APPROVED LORAIN CO. MAP DEPT.
DATE 12-13-90
PAGE 16-H
BY CAROLYN FRANCIS
VOID AFTER # 19218

ORIG