


Iron pipes fd or set 30ft fr & at right angles  
 • iron pipe fd  
 o iron pipe set

#19257	
APPROVED LORAIN CO. MAP DEPT.	
DATE	2-4-91
PAGE	16-H
BY	CAROLYN FRANCIS
VOID AFTER #	19257

John Poznywak  
 Reg Surveyor  
 5292

Survey for James Demyan  
 Part of Original Lots 72, 73 & 89  
 Grafton Township  
 Lorain County Ohio  
 Scale 1"=200' May 8, 1990

Rev 8/1/90  
 8/2/90  
 8/13/90

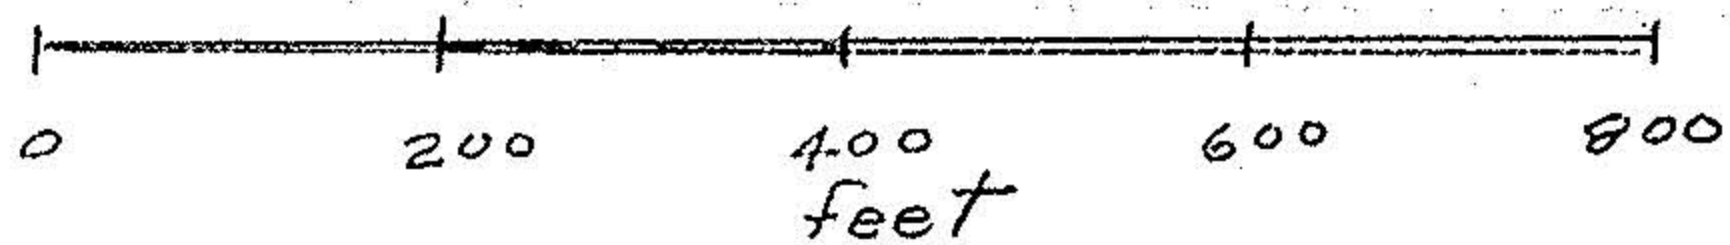

AUG 16 1990