
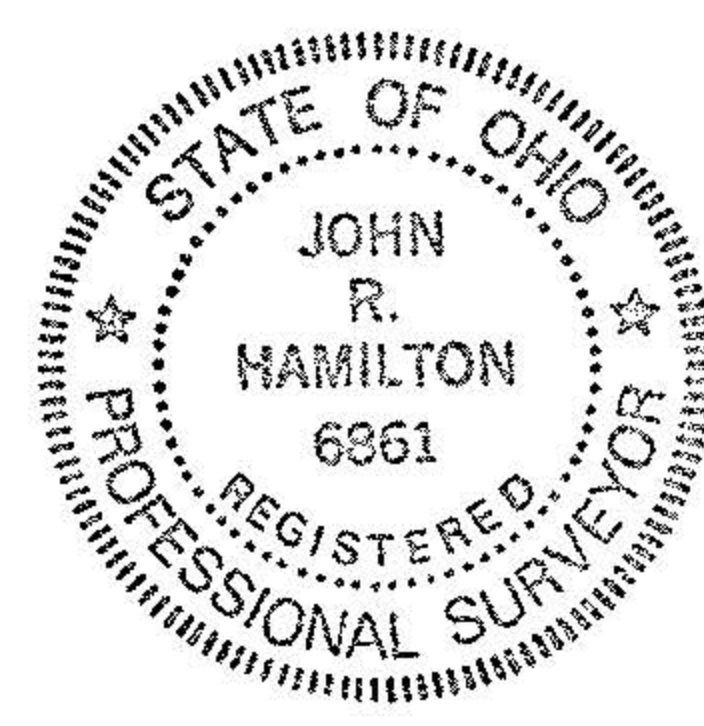


16-00-072-000

MICHAEL SAUTER
O.R. Vol. 304 P. 479
46.78 AC. ORIG.
40.78 AC. REM.

1990
65 201 4

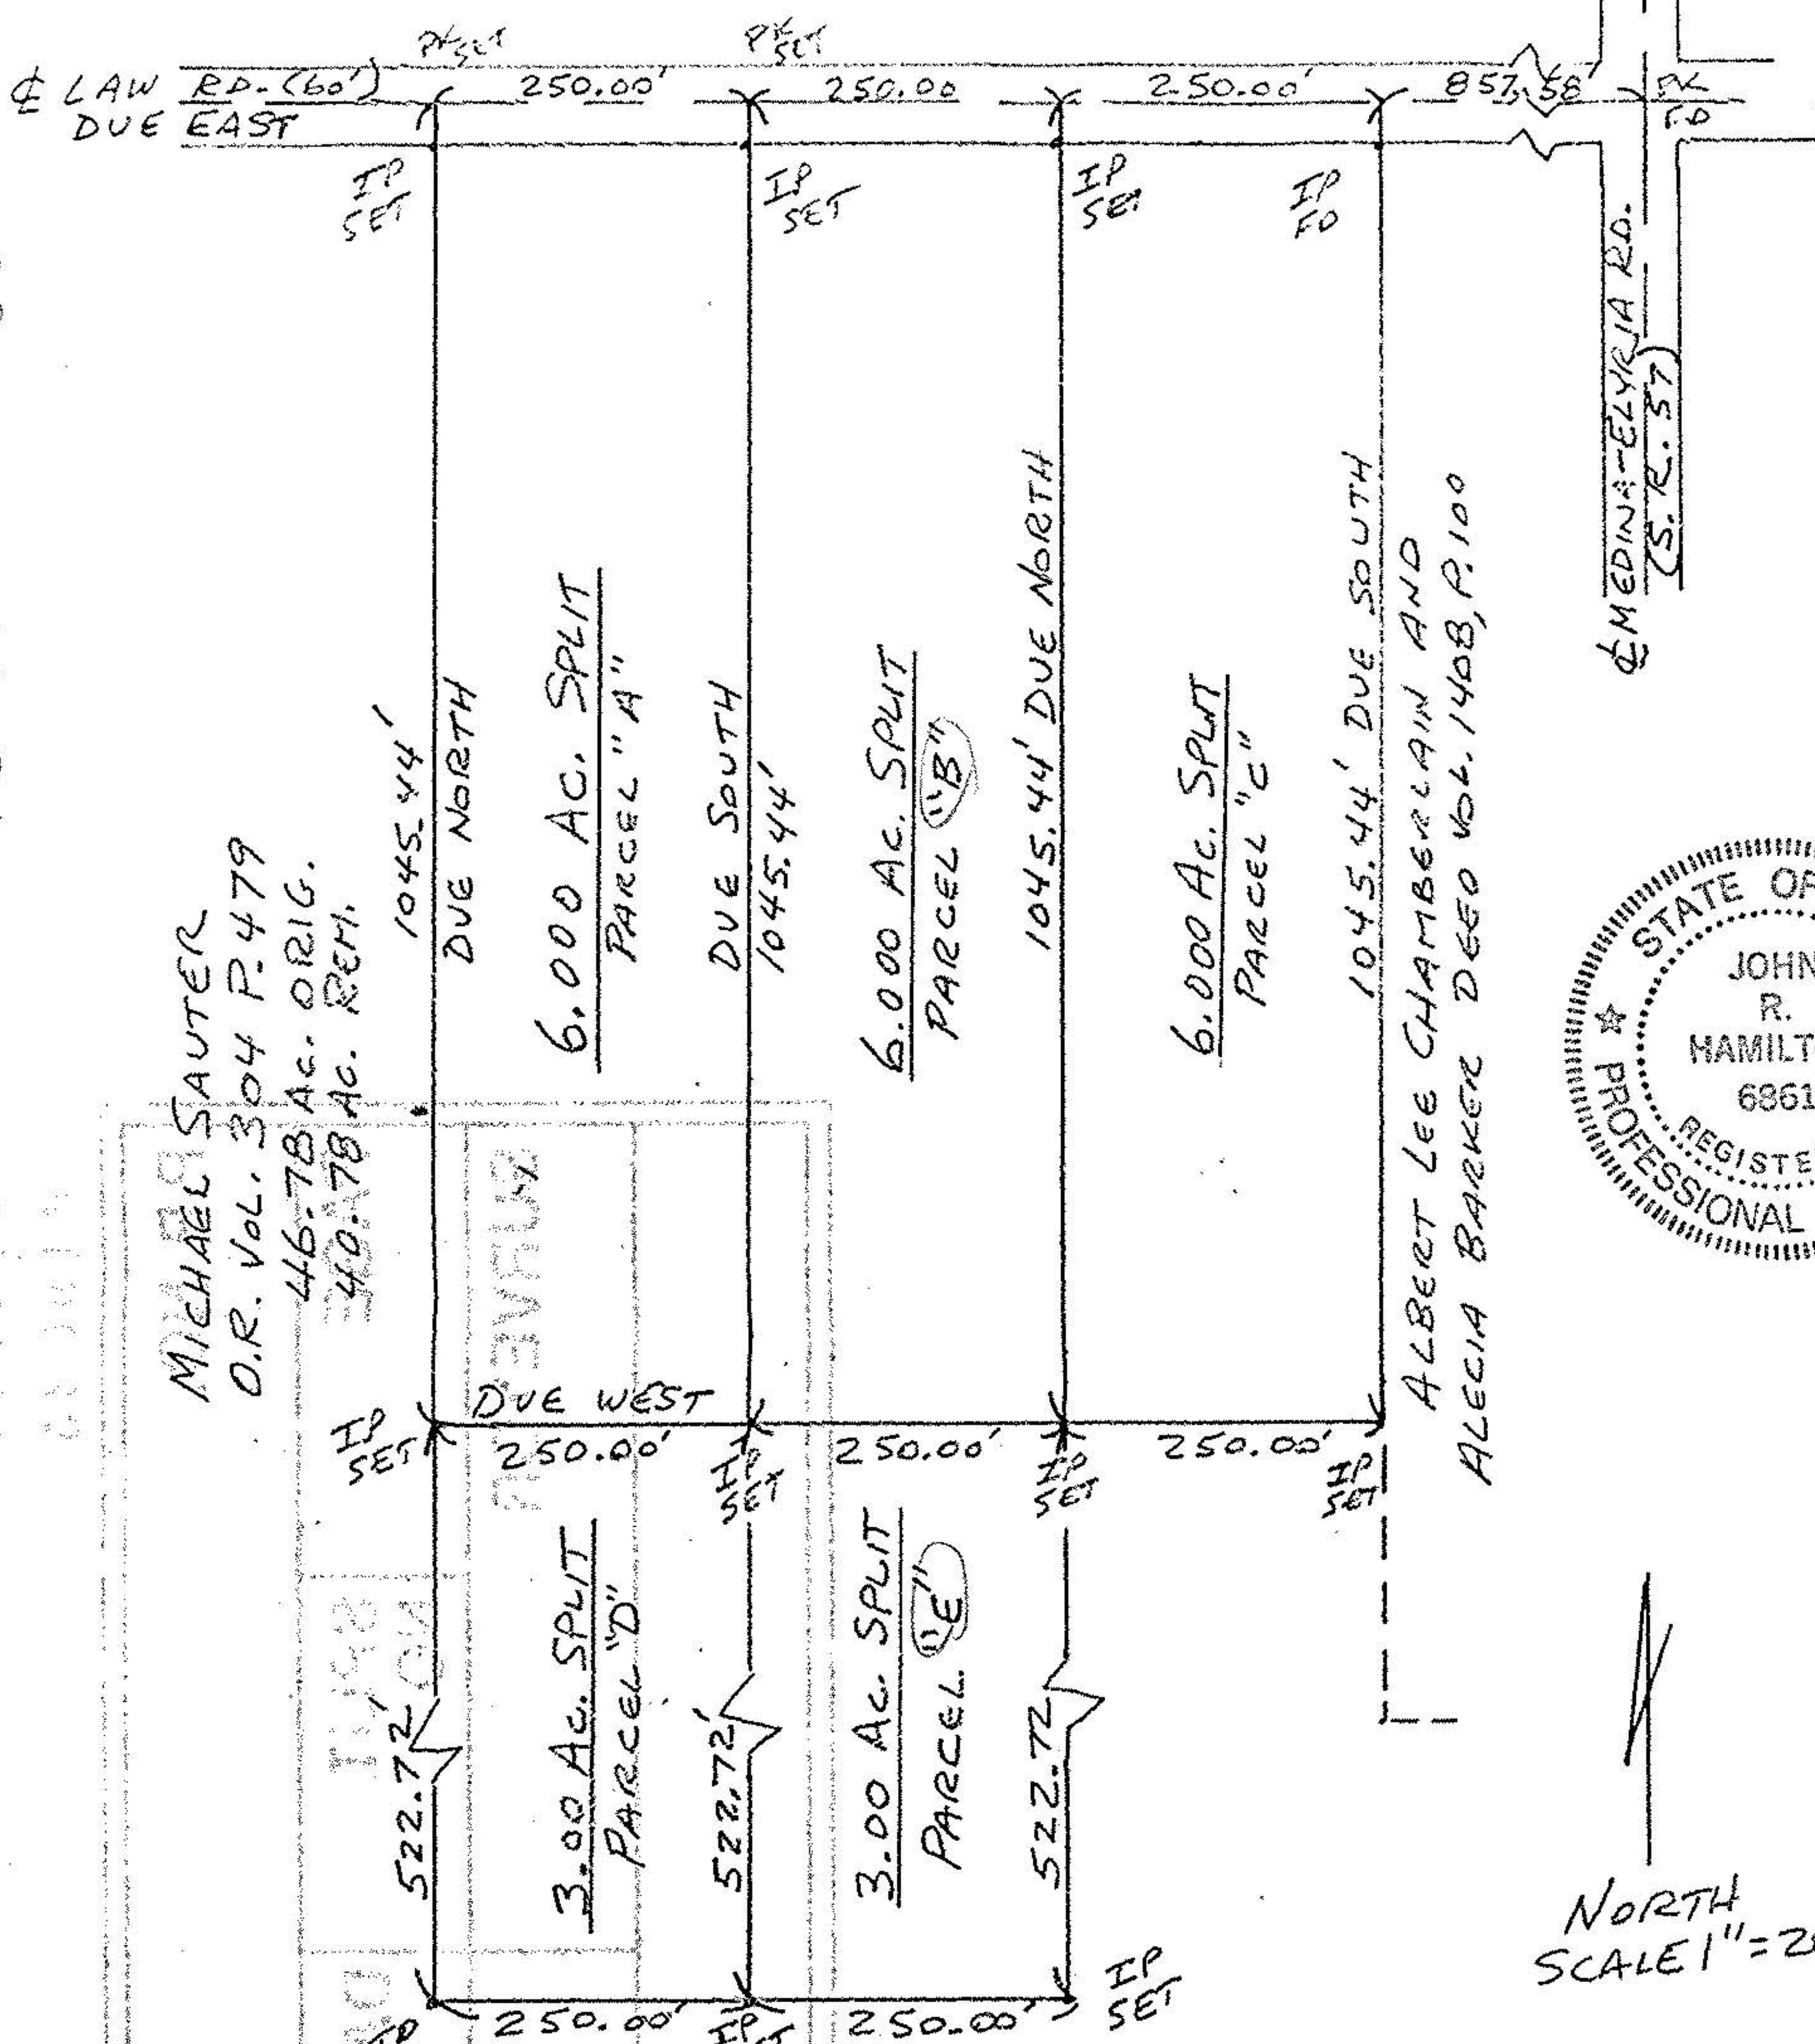

NORTH
SCALE 1" = 200'

MAP OF SURVEY FOR MICHAEL SAUTER
GRAFTON TWP. - D. L. # 72
SEPT. 1990 REV. 10/90 10/91 SCALE 1" = 200'
ADD B+C ADD D+E
JOHN R. HAMILTON - REG. SURV. # 6861