

CATHERINE BOT SCH
DEED Vol. 1224 P. 616-618
54.56 AC. ORIG. 51.385 REM.

ON 99

DEAN + MARGARET CARPENTER
DEED VOL. 1224, P. 619

ROYBVAUS

IP FD.
(2' W)

614.67 N 87° 55' W

IP
FD.

30'

N 30° E

225.0' S.R. 57 (MEDINA-ELYRIA RD.)

3.175 AC. SPLIT

NORTH
SCALE 1" = 100'

O.L. 72
O.L. 89

IP
SET

614.67' S 87° 55' E

REBAR
FD.

30'

CONRAD + SUSAN KNOLL
DEED VOL. 1325, P. 375

17980


APPROVED
LORAIN CO.
MAP DEPT.

DATE 6-8-88

PAGE 16-H

BY Carol Francis

VOID AFTER # 17980

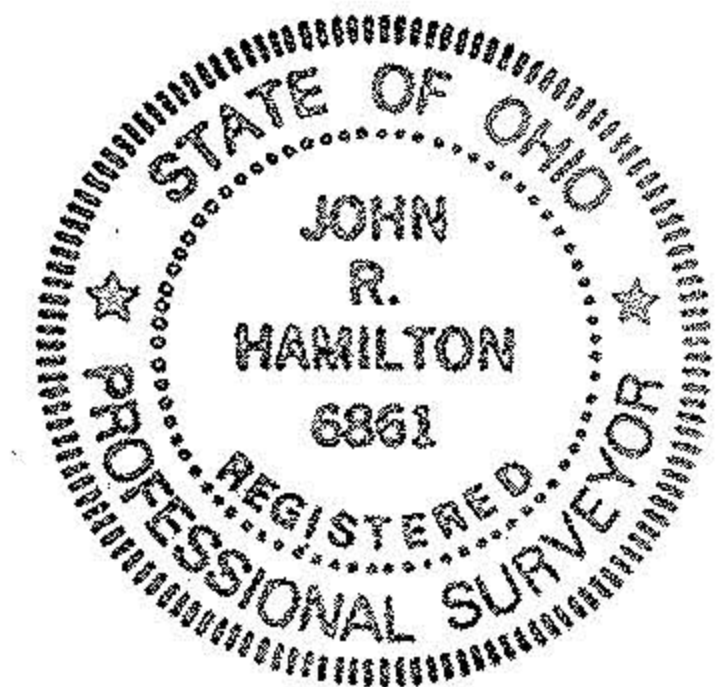

MAP OF SURVEY FOR GORDY HALES
O.L. 72 - GRAFTON TWP. - LORAIN Co.
SCALE 1" = 100'
JOHN R. HAMILTON - REG. SURV. #6861