



20162

APPROVED
LORAIN CO.
MAP DEPT.
DATE 11-24-92
PAGE 16-00-003 A
BY CAROLYN FERANCLIS
VOID AFTER # 20162

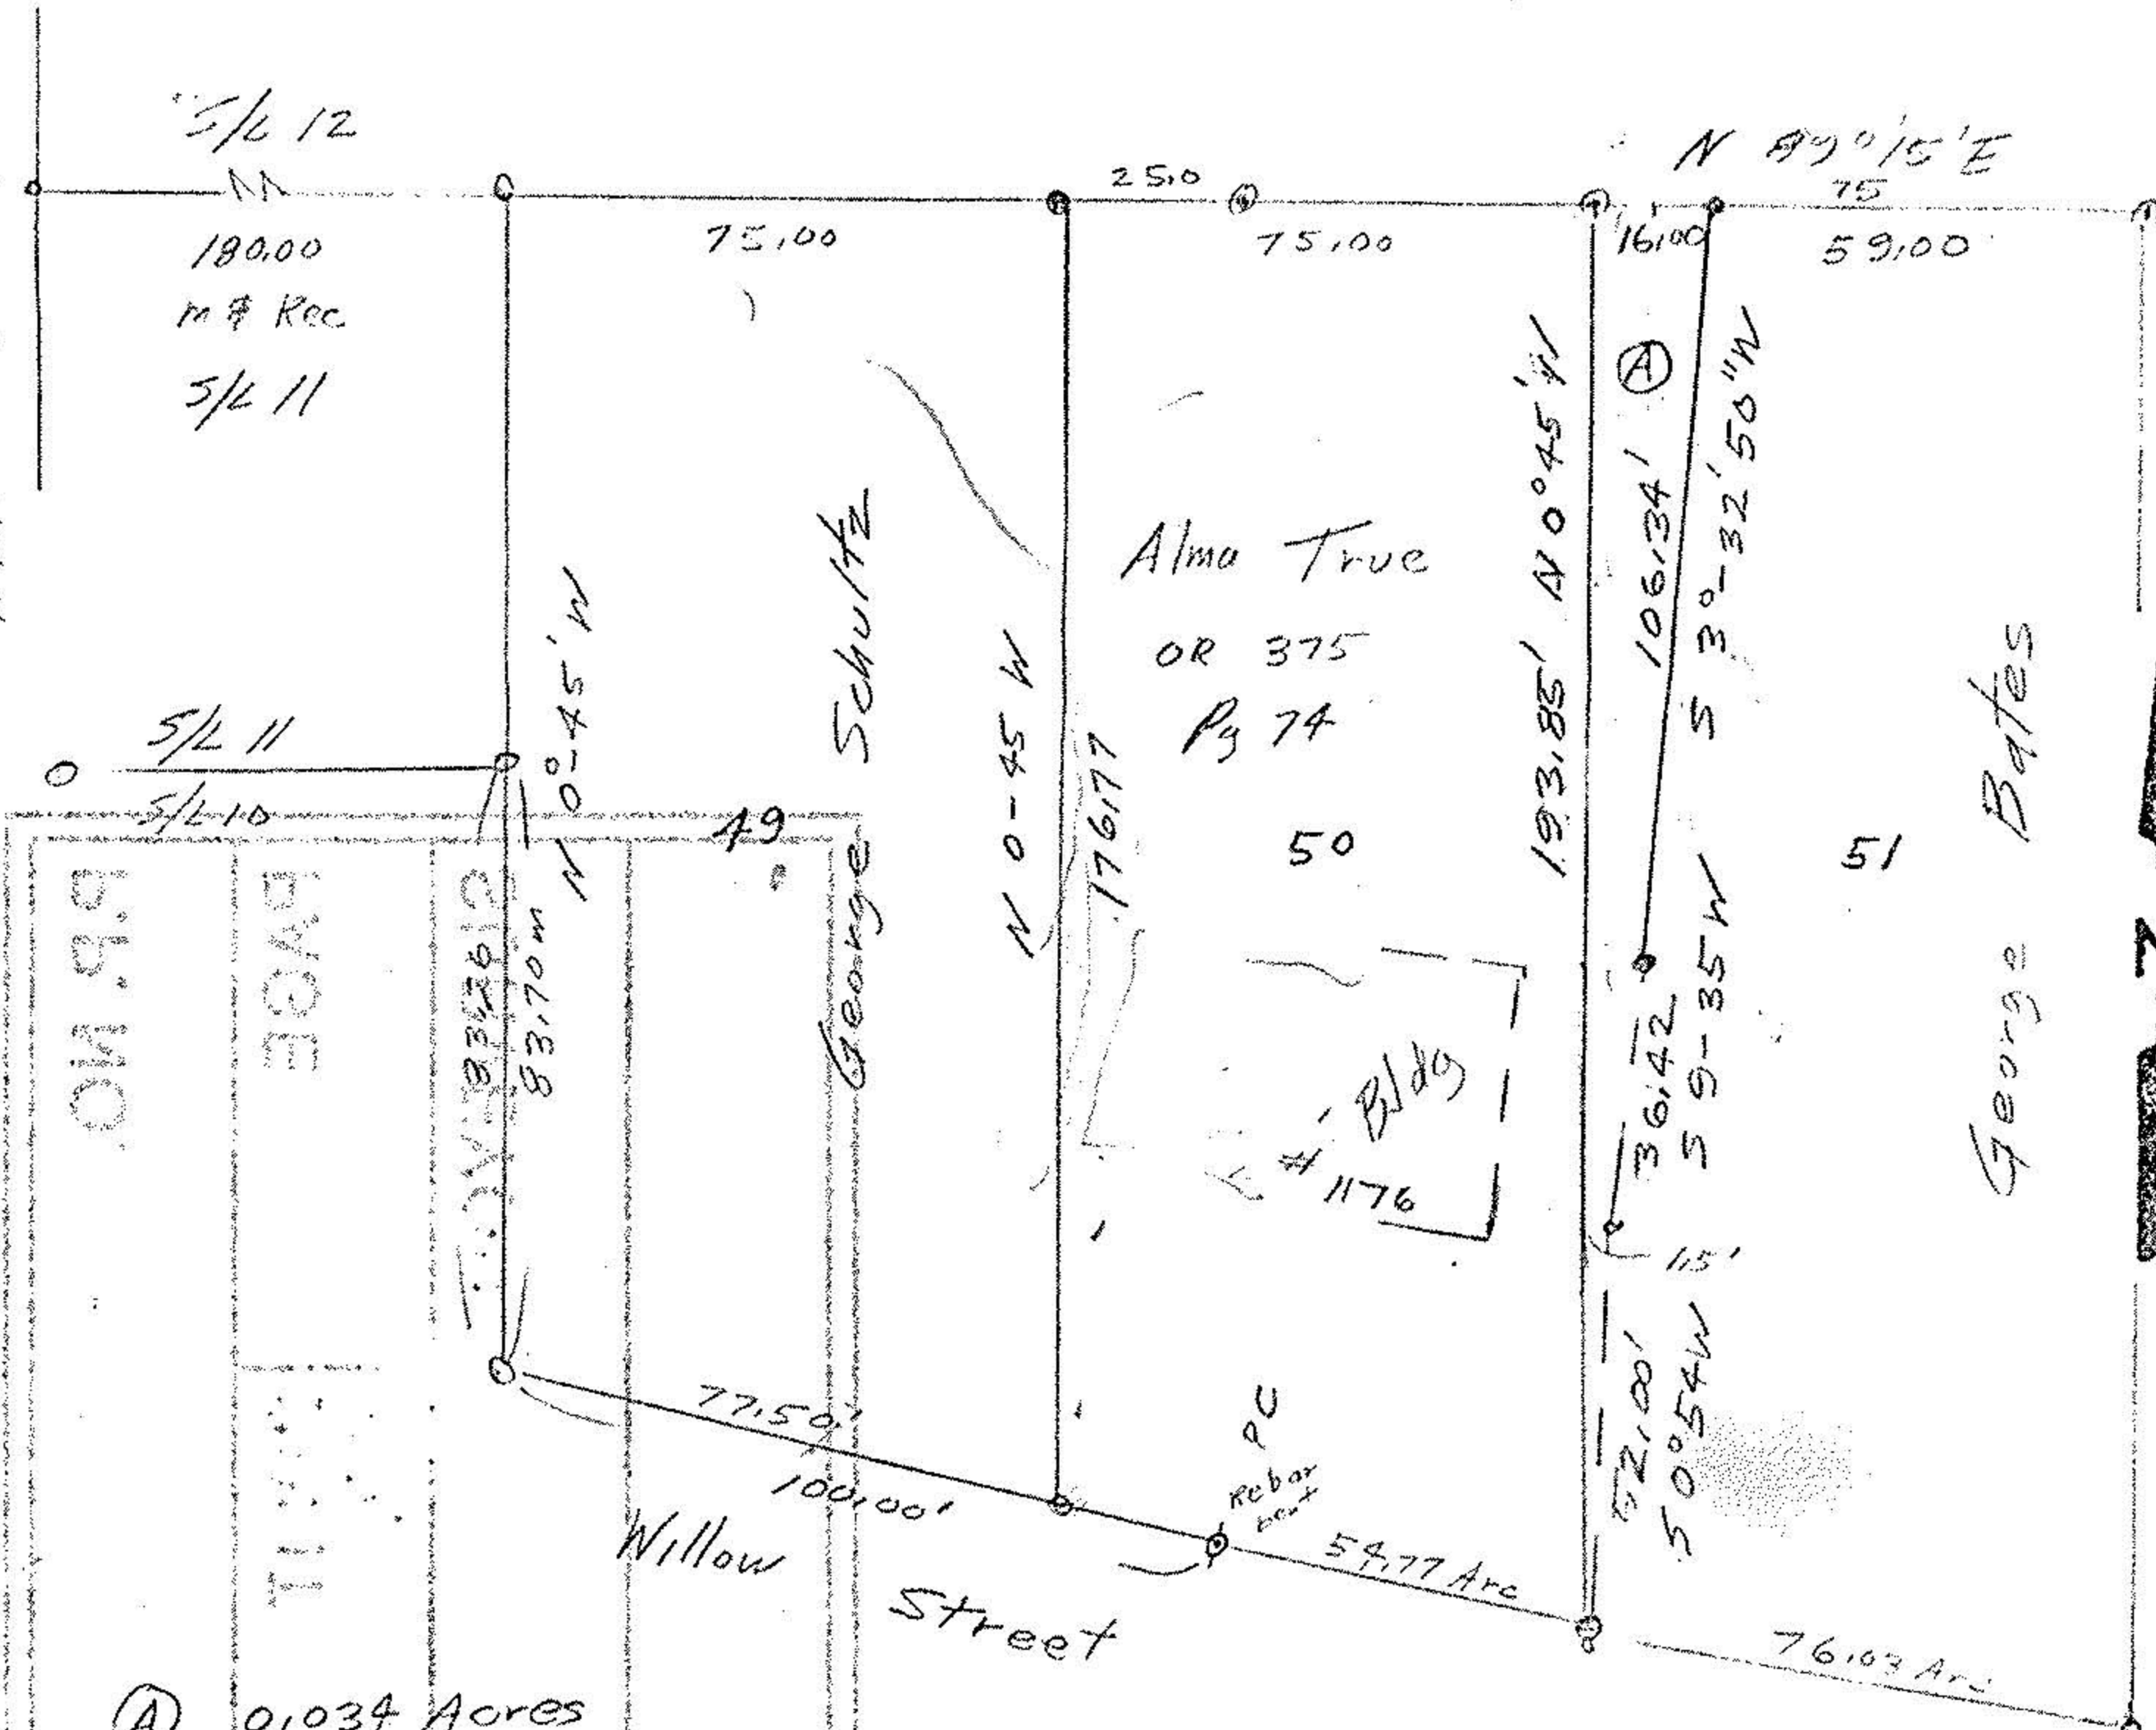

- Ⓐ 0.1034 Acres
- o iron pipes fd
- o 45 rebar fd
- o rebar set

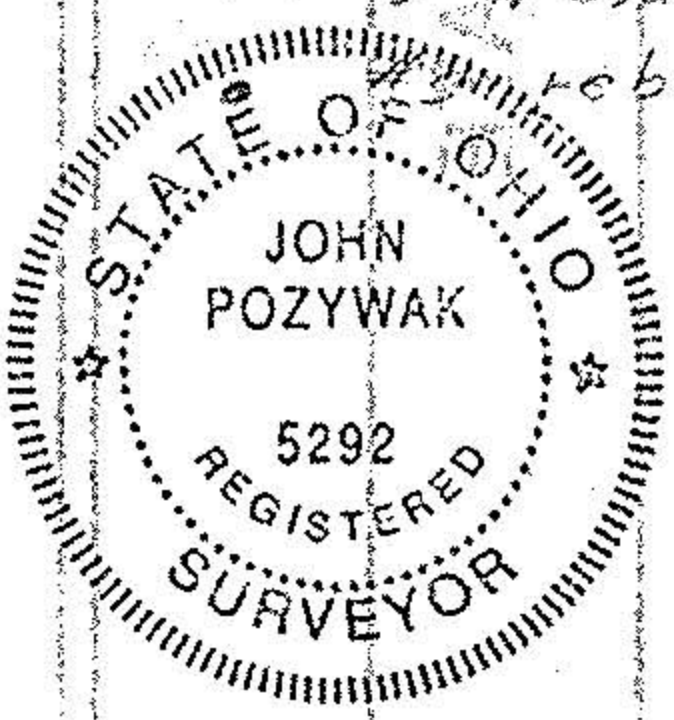

Survey of subplot 50 in  
 Myles Knechtger Sub'd # 3  
 Proposed Purchase for  
 Nolan True  
 Part of Original Grafton Trp Lot 3  
 Lorain County Ohio  
 Scale 1" = 40' Aug 29, 1992  
 Revised Oct 1992

John Pozywak  
 Reg Surveyor 5292

