


D

COWLEY ROAD

10101
160
0610

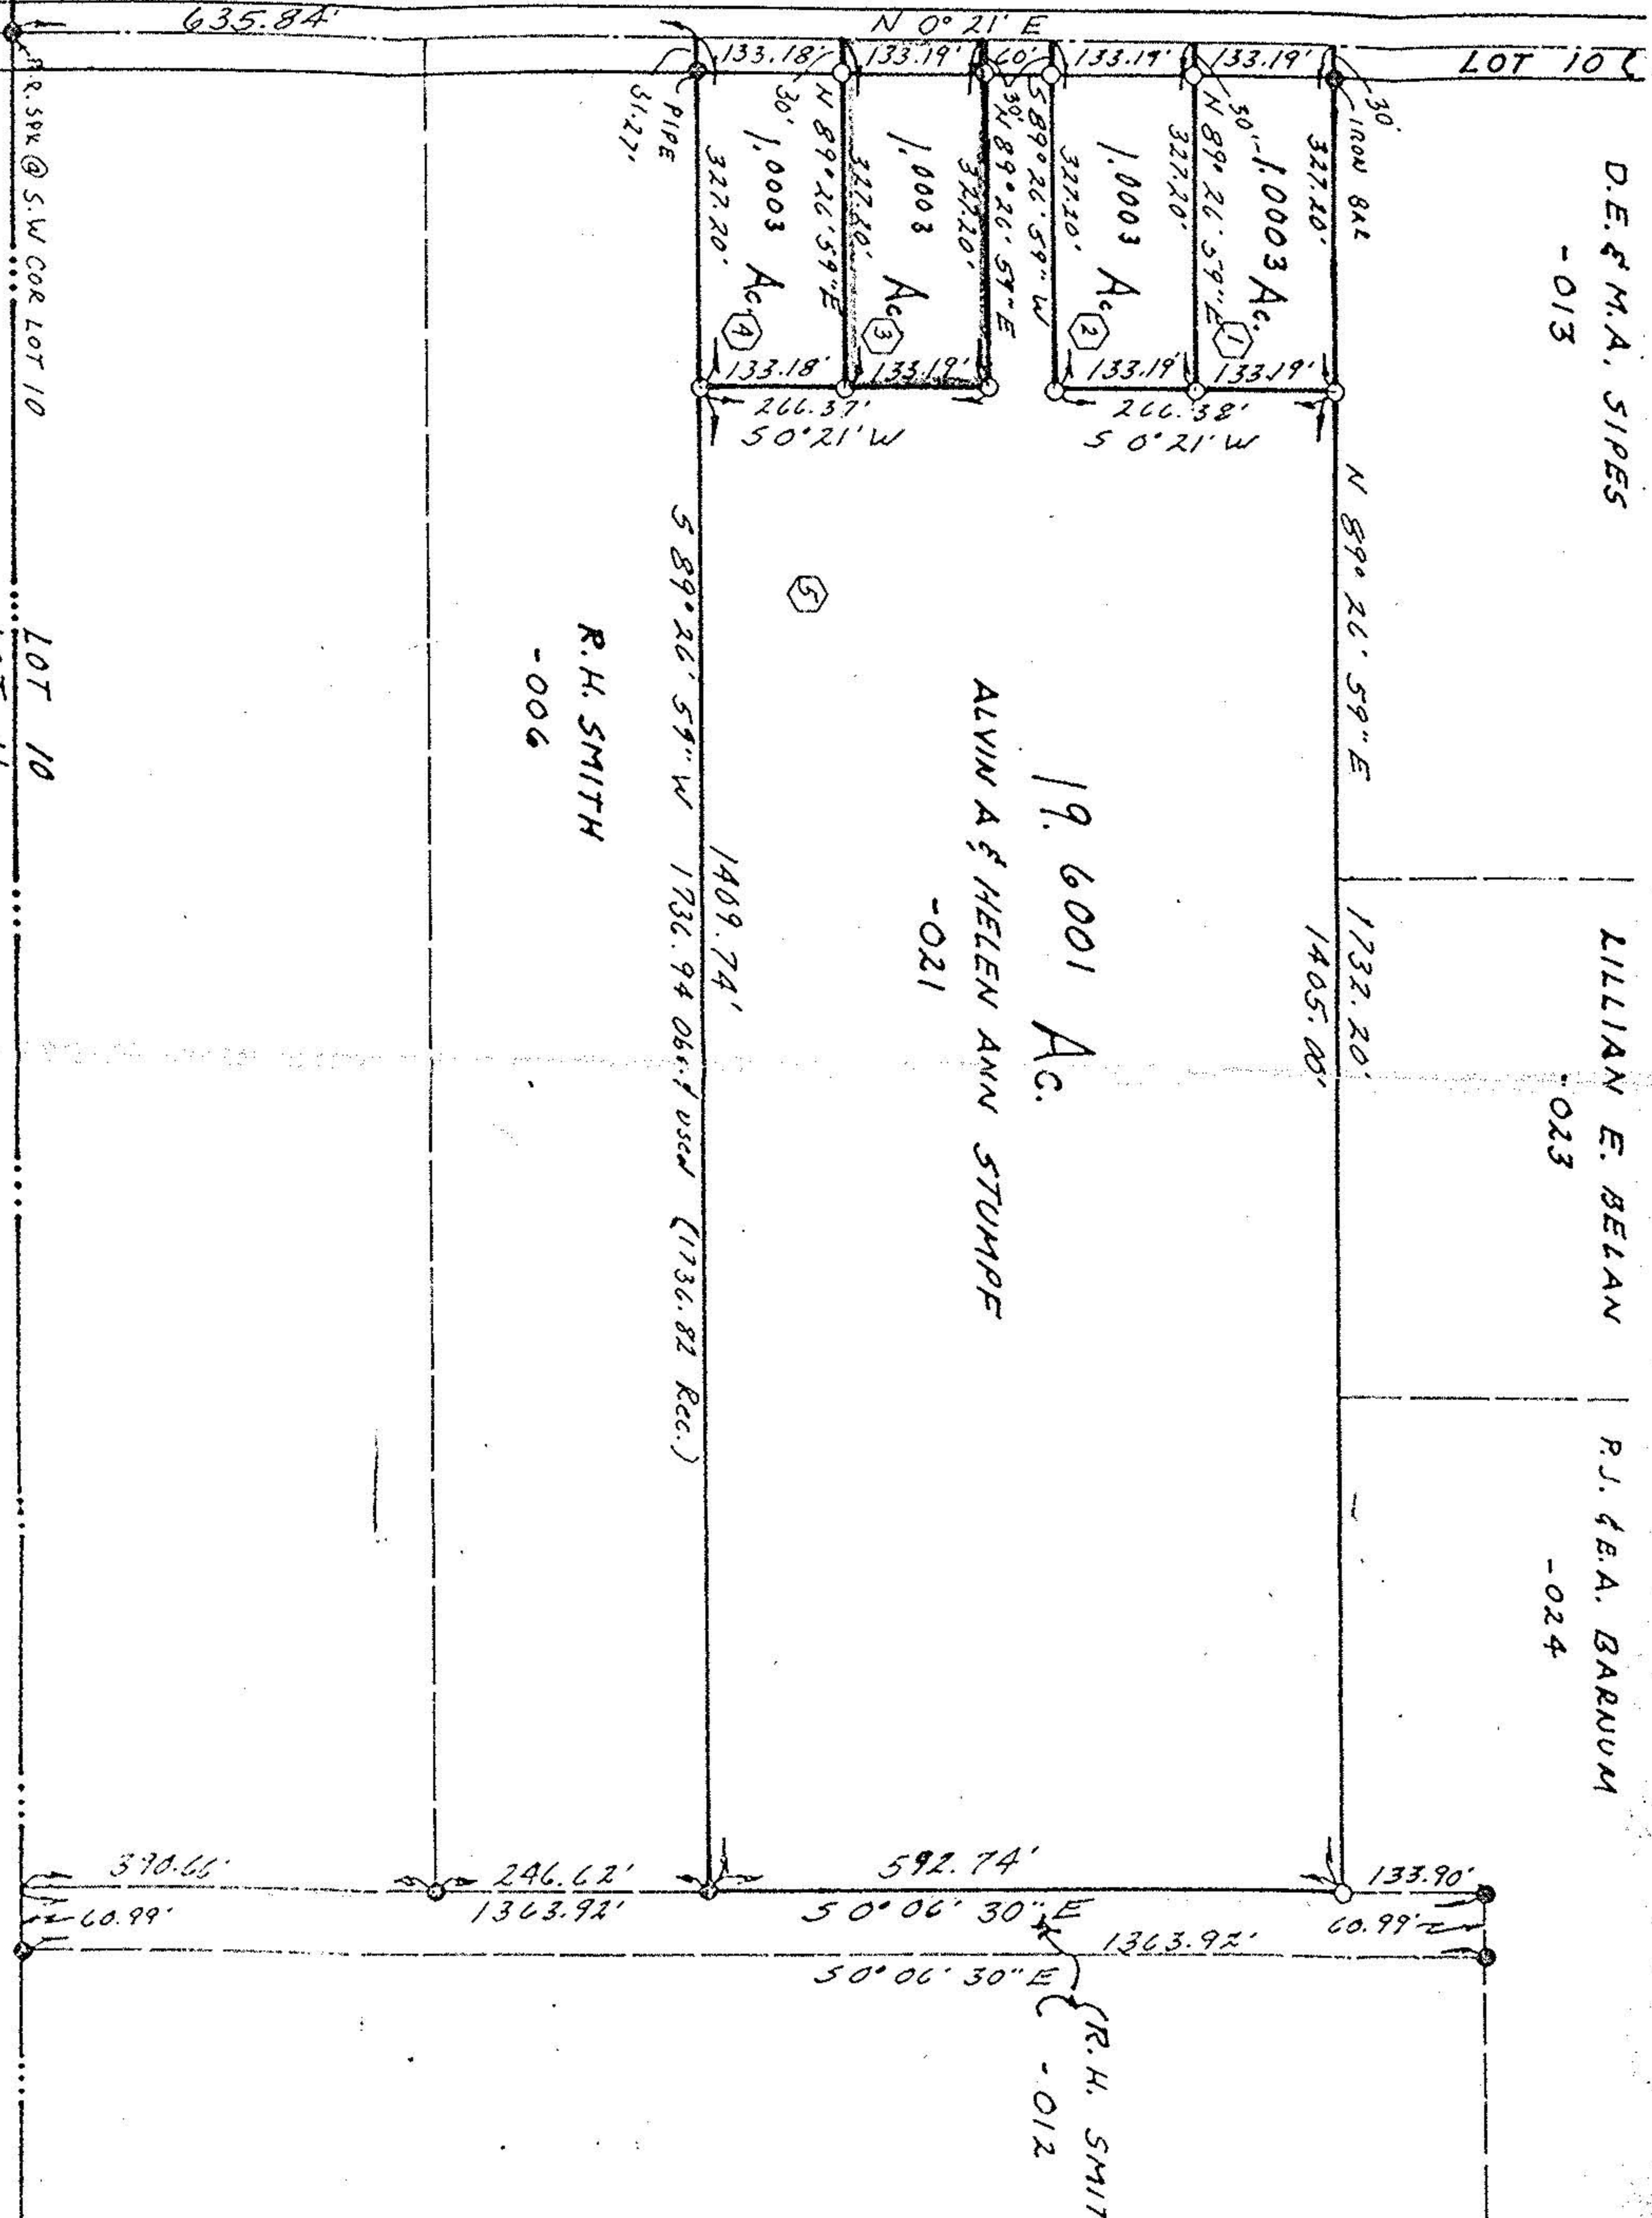

LEGEND
 O I.P. SET
 • I.P. FOUND


I Hereby
 Correct Survey and
 The Field and A
 RECORDS.

SCALE

16 W =

10401
160
0610

COWLEY ROAD

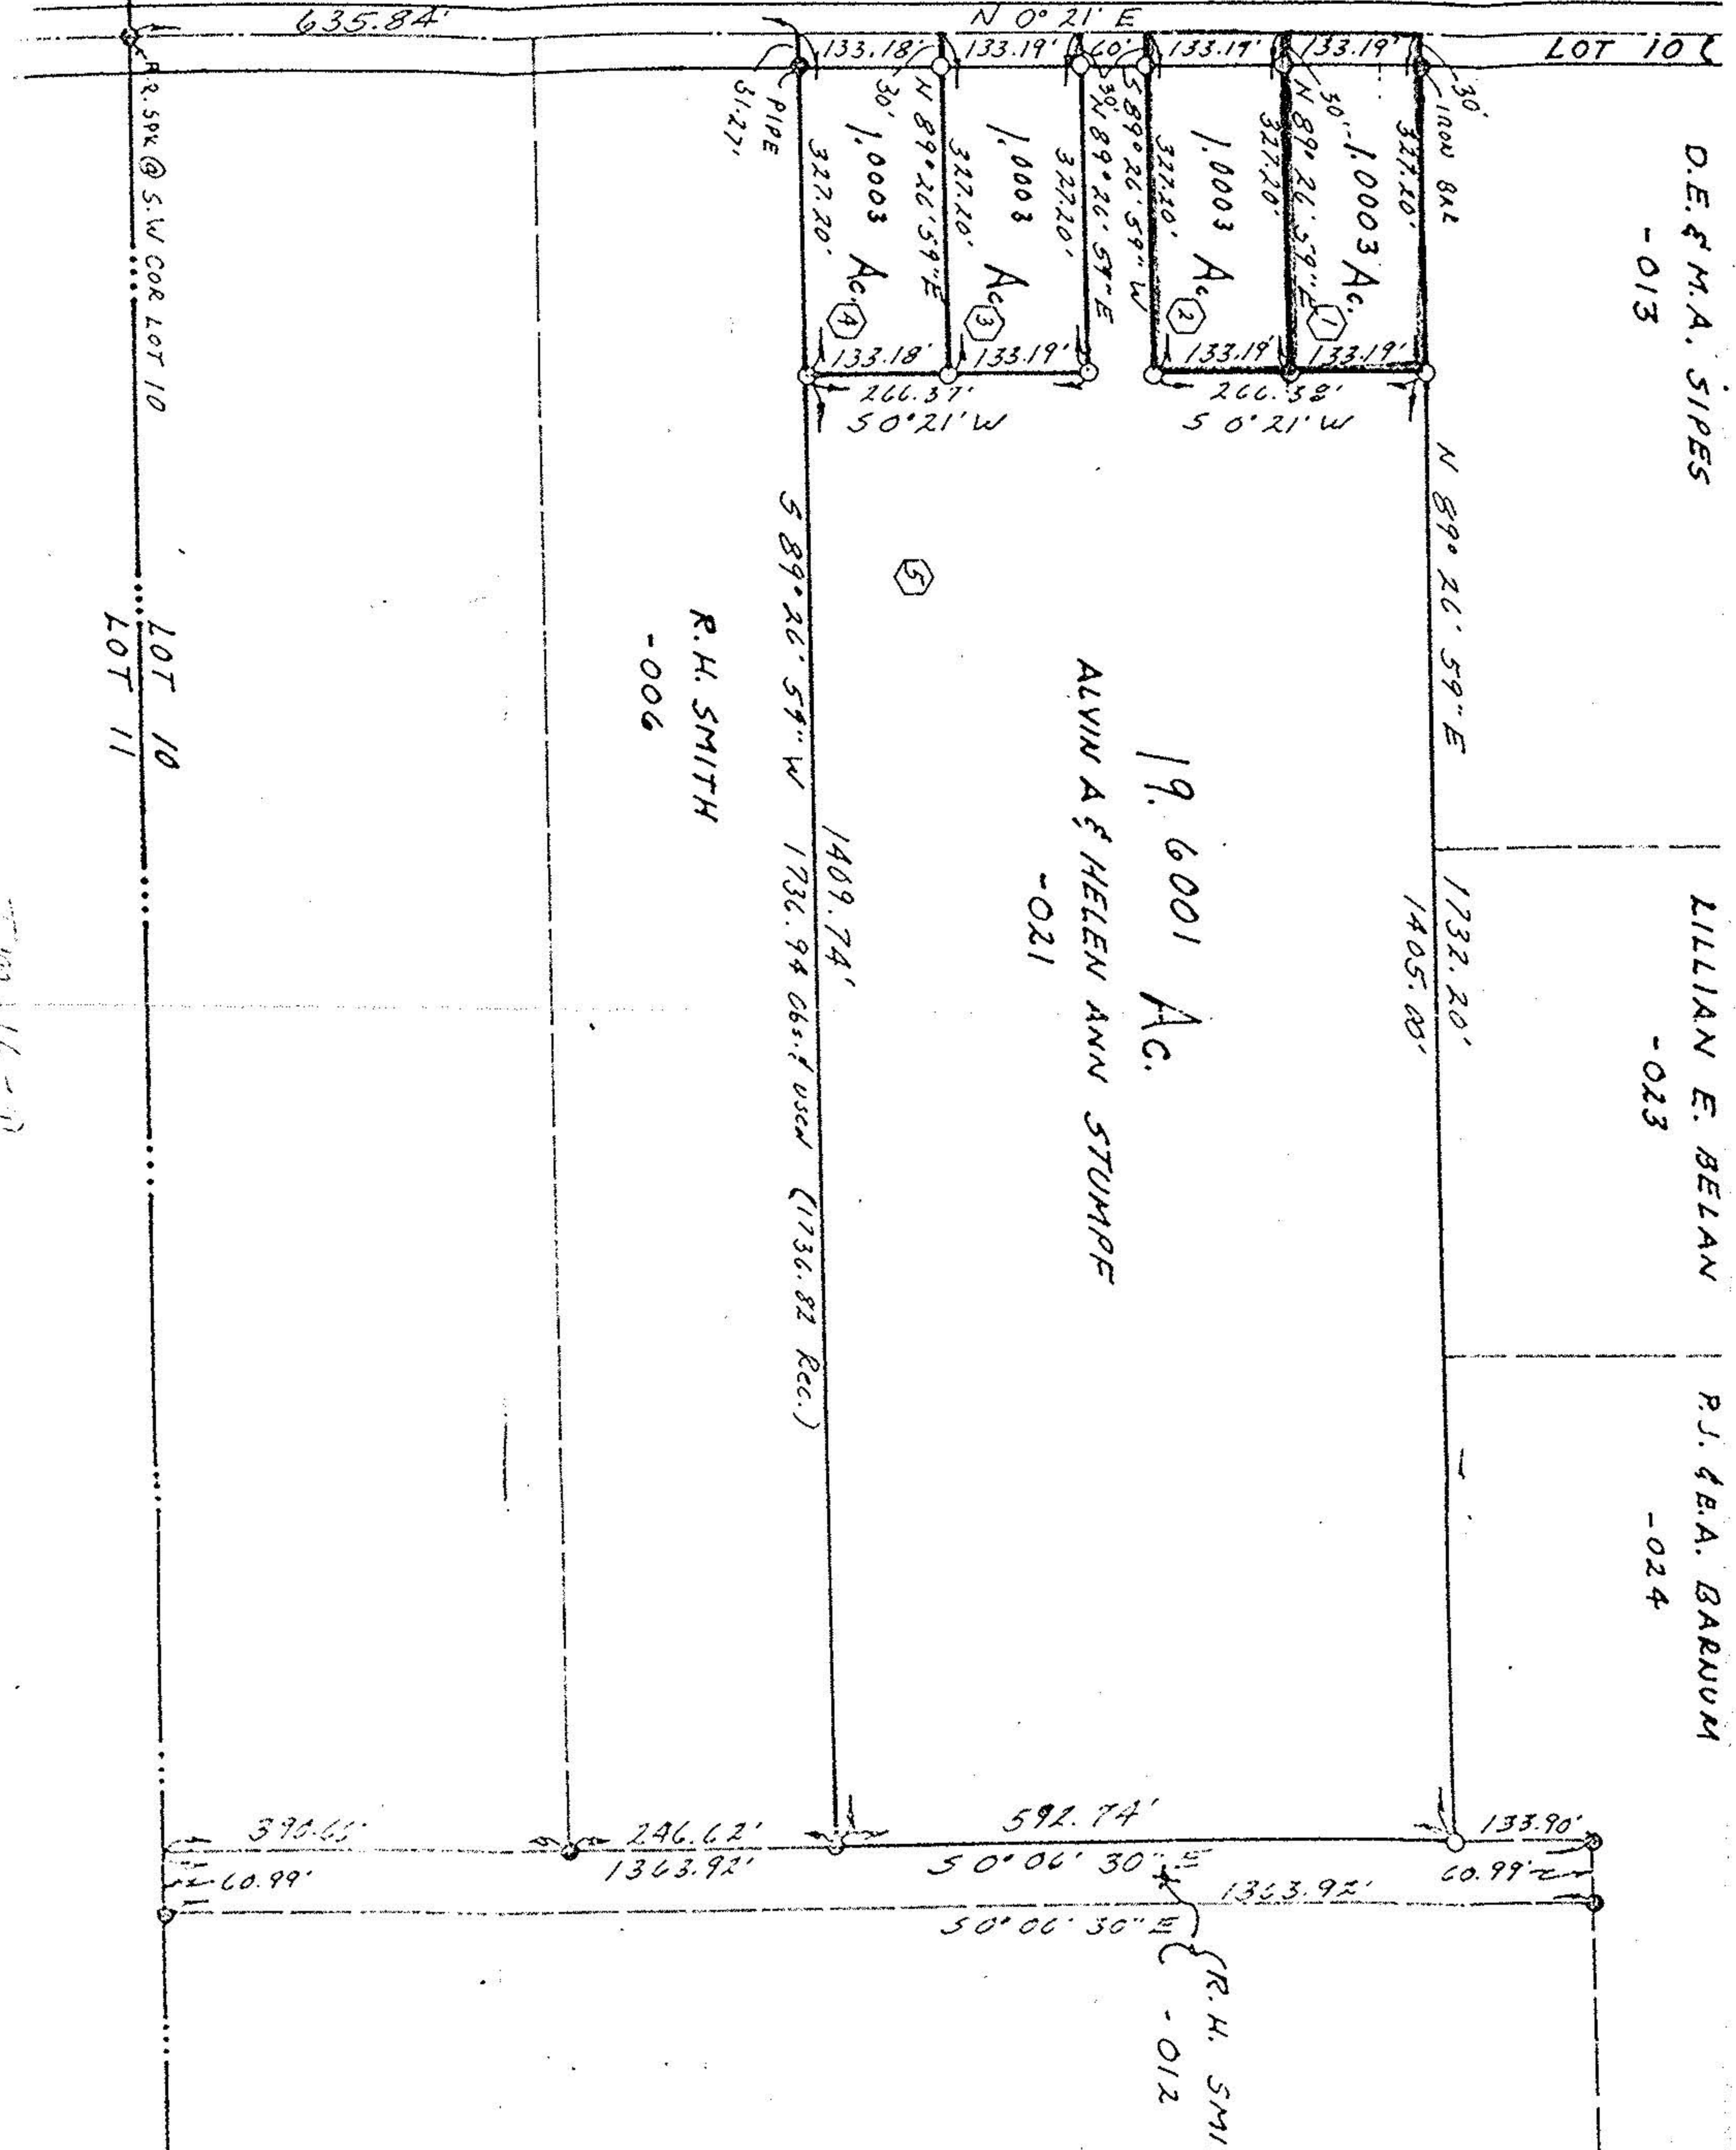

LEGEND
 O I.P. SET
 • I.P. FOUND

I Hereby
 Correct Survey
 The Field and
 RECORDS.

SCALE

W