


KLEINOEDER · SCHMIDT
and ASSOCIATES
ENGINEERS — SURVEYORS — CONSULTANTS IN LAND PLANNING
ELYRIA · NORWALK · MEDINA OHIO

SURVEY

Sublot(s) _____
Subd'n _____

110-00-91

Township GRAFTON Tract _____
Orig. Lot(s) 11 Sec. _____
County of LORAIN State of Ohio
Corporation _____

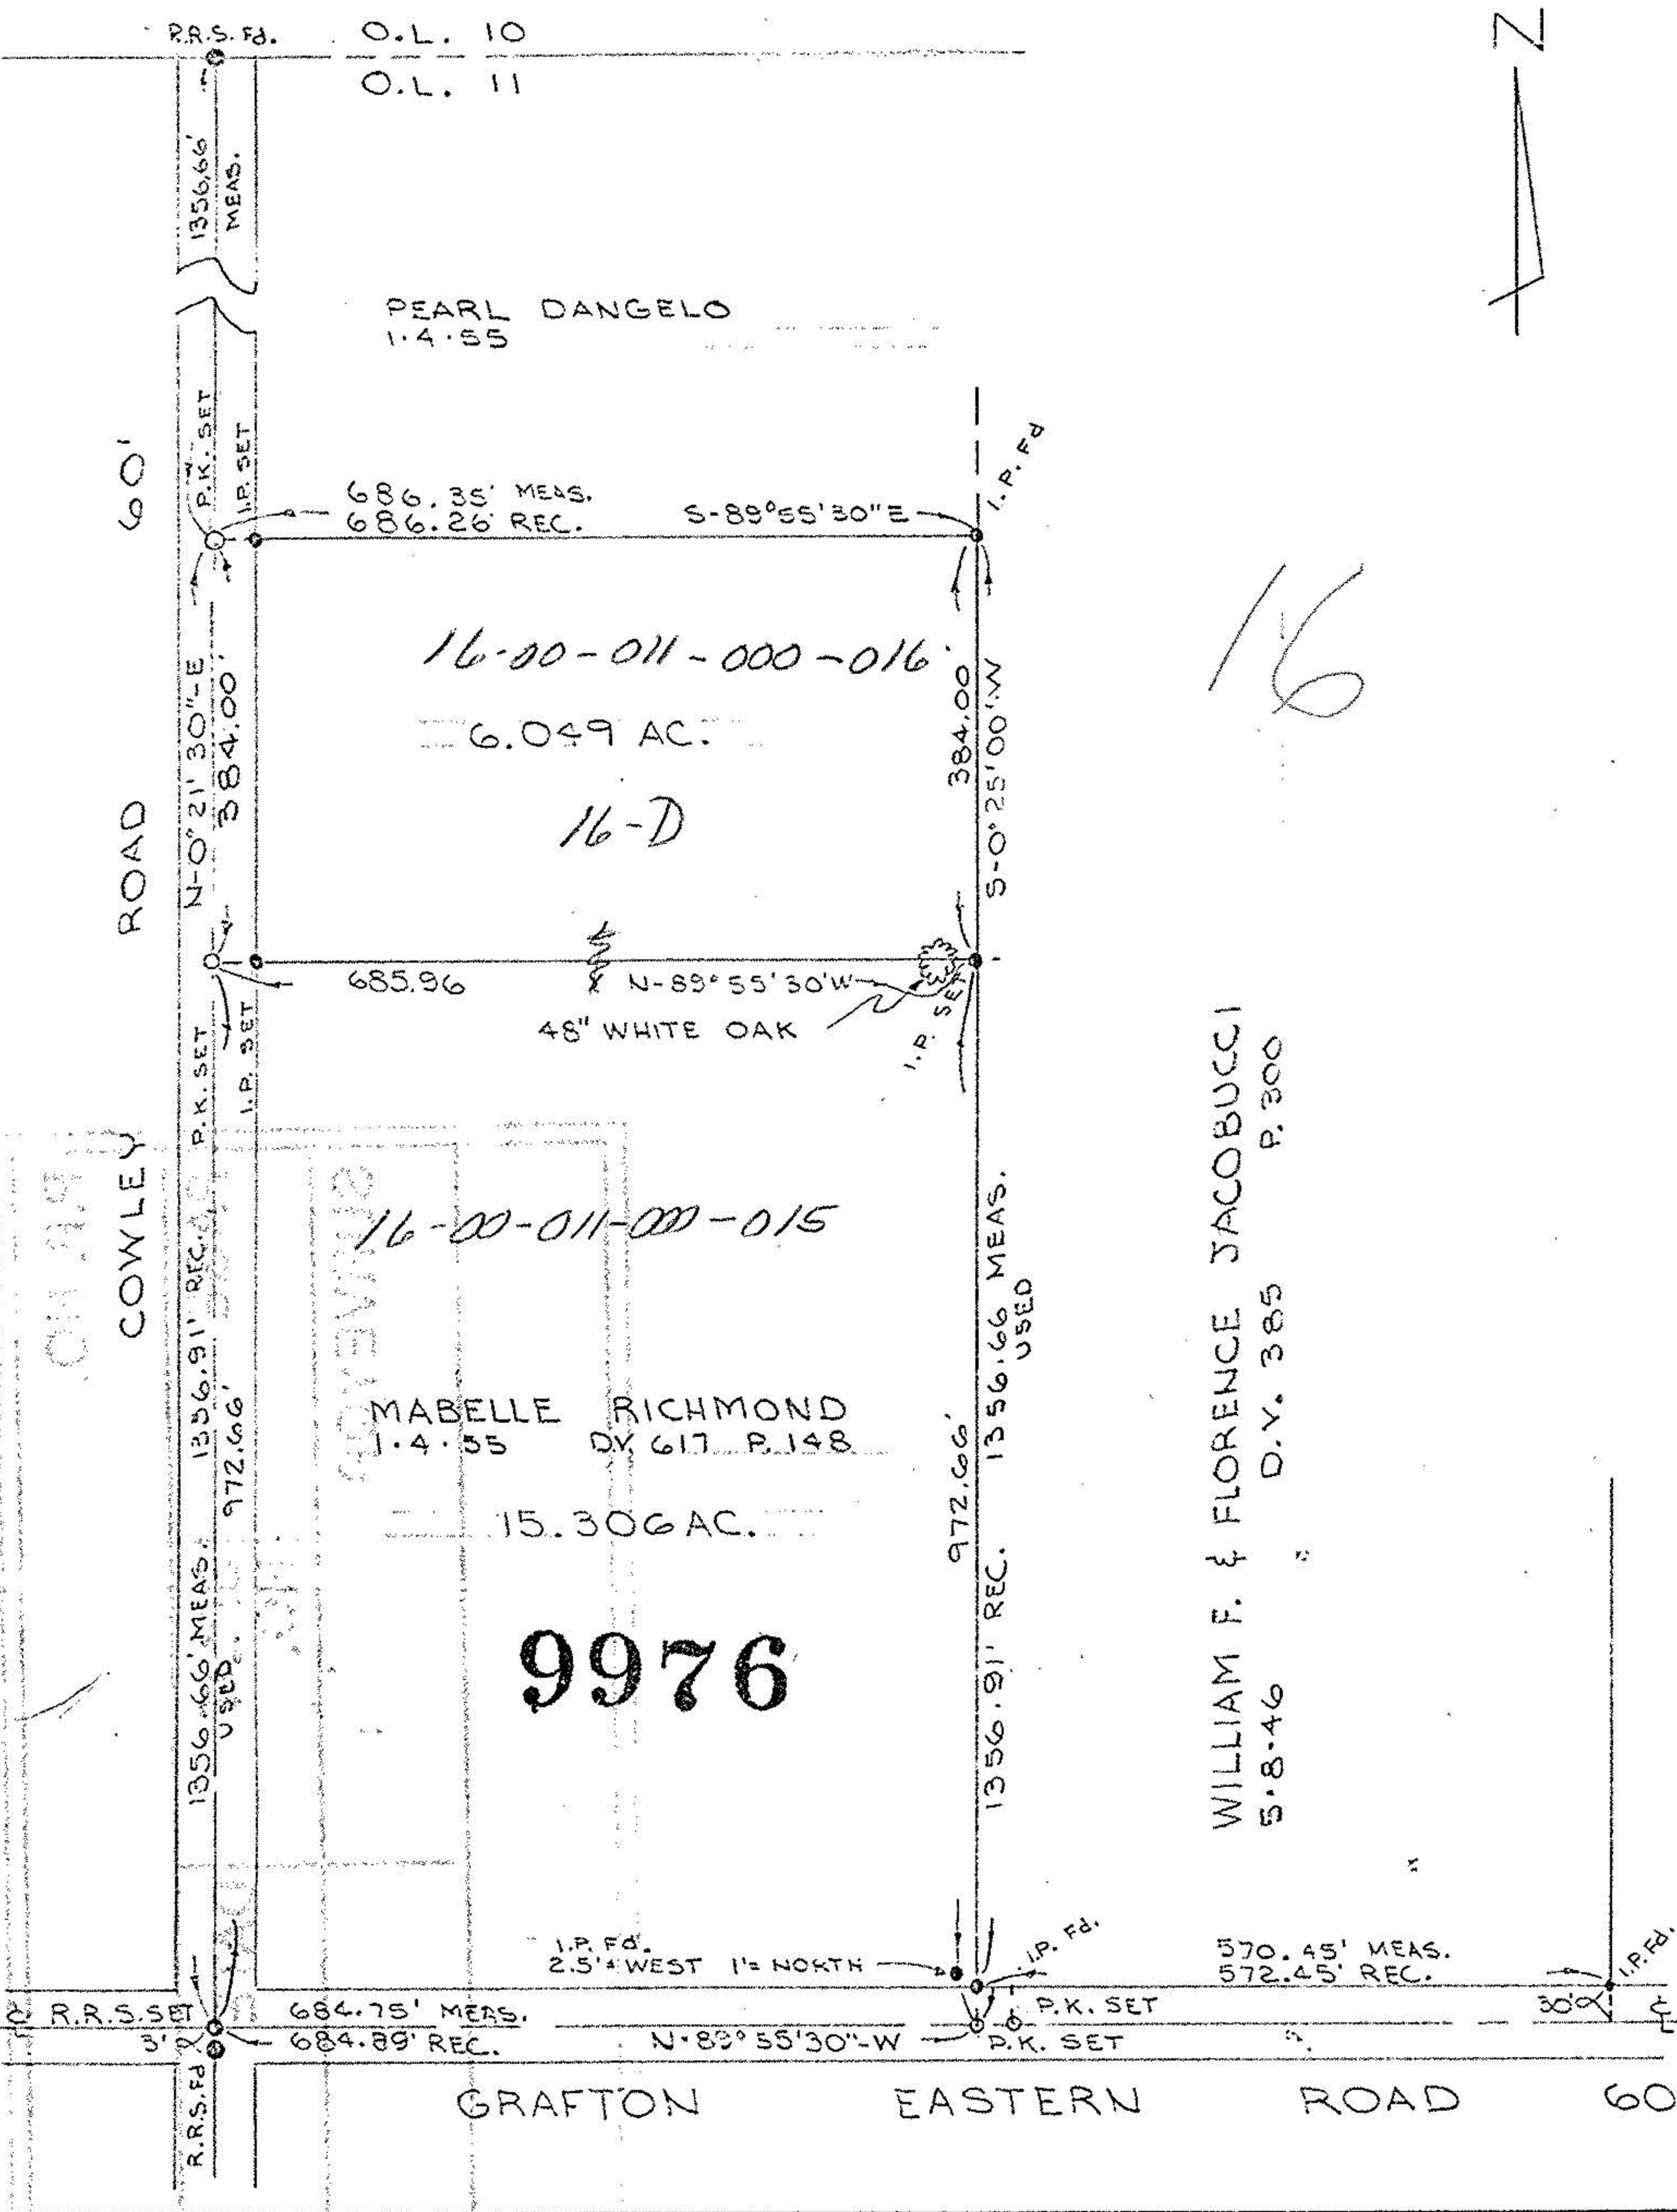

WILLIAM F. & FLORENCE JACOBUCCI
5-8-46 D.V. 385 P. 300

Prepared for: J.C. WOODINGS
Scale: 1" = 200' Date: 8-24-76 Dr. by: _____ Job No 76-256

16-D