


CARDINAL SURVEYS
PLAT OF SURVEY

PREPARED FOR MR. DONALD TILBERG

PREPARED FOR MK. DONAHUE
ORIGINAL GRAFTON TOWNSHIP LOT NO. 16 AVON-BELDEN RD.
SPLIT TWO 1.3774 ACRE PARCELS FROM 4.1322 AC. PARCEL
1.3774 ACRE REMAINDER

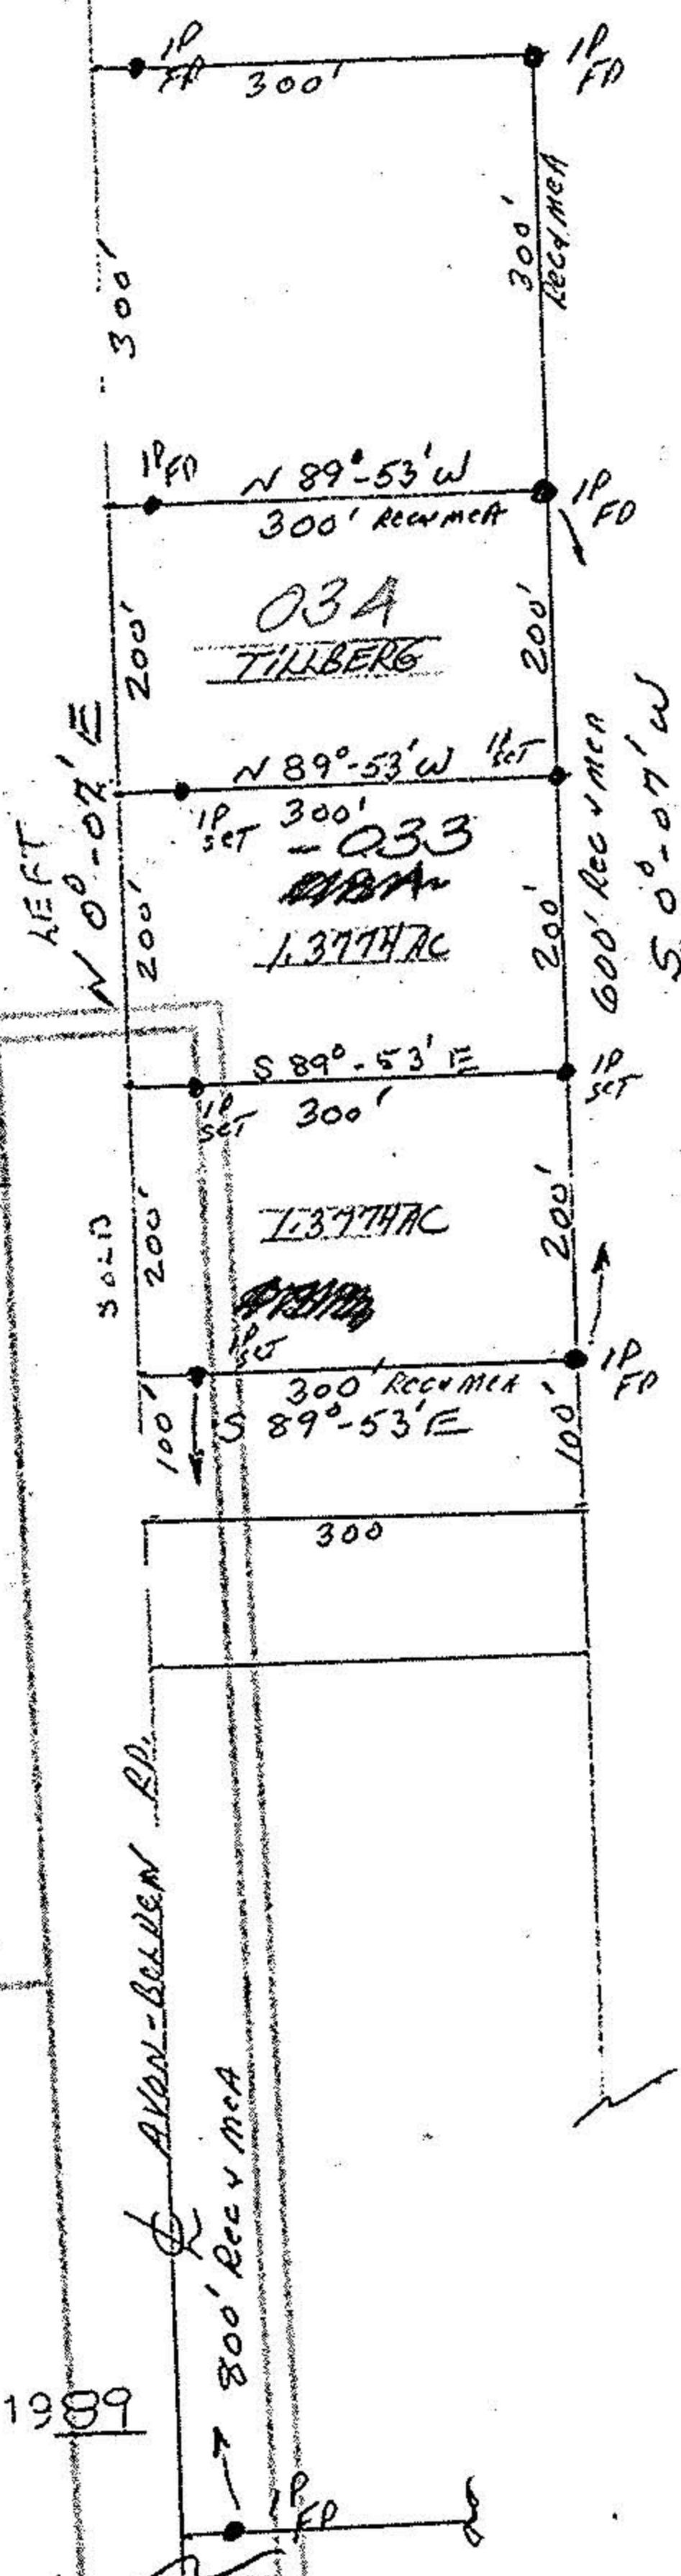

DATE: Dec. 4, 1989

SCALE: 1" = 200'

16-00-015-000-

DATE 12-14-93
PAGE 16-00-015A
BY CAROLYN FRANCIS
VOID # 20636
AFTER