


16-00-015-000

#18816

CARDINAL SURVEYS  
PLAT OF SURVEY

PREPARED FOR MR. DONALD TILBERG

ORIGINAL GRAFTON TOWNSHIP LOT NO. 16 AVON-BELDEN  
SPLIT ONE 1.3774 ACRE PARCEL'S FROM 4.1322 AC. P.  
2.7548 ACRE REMAINDER

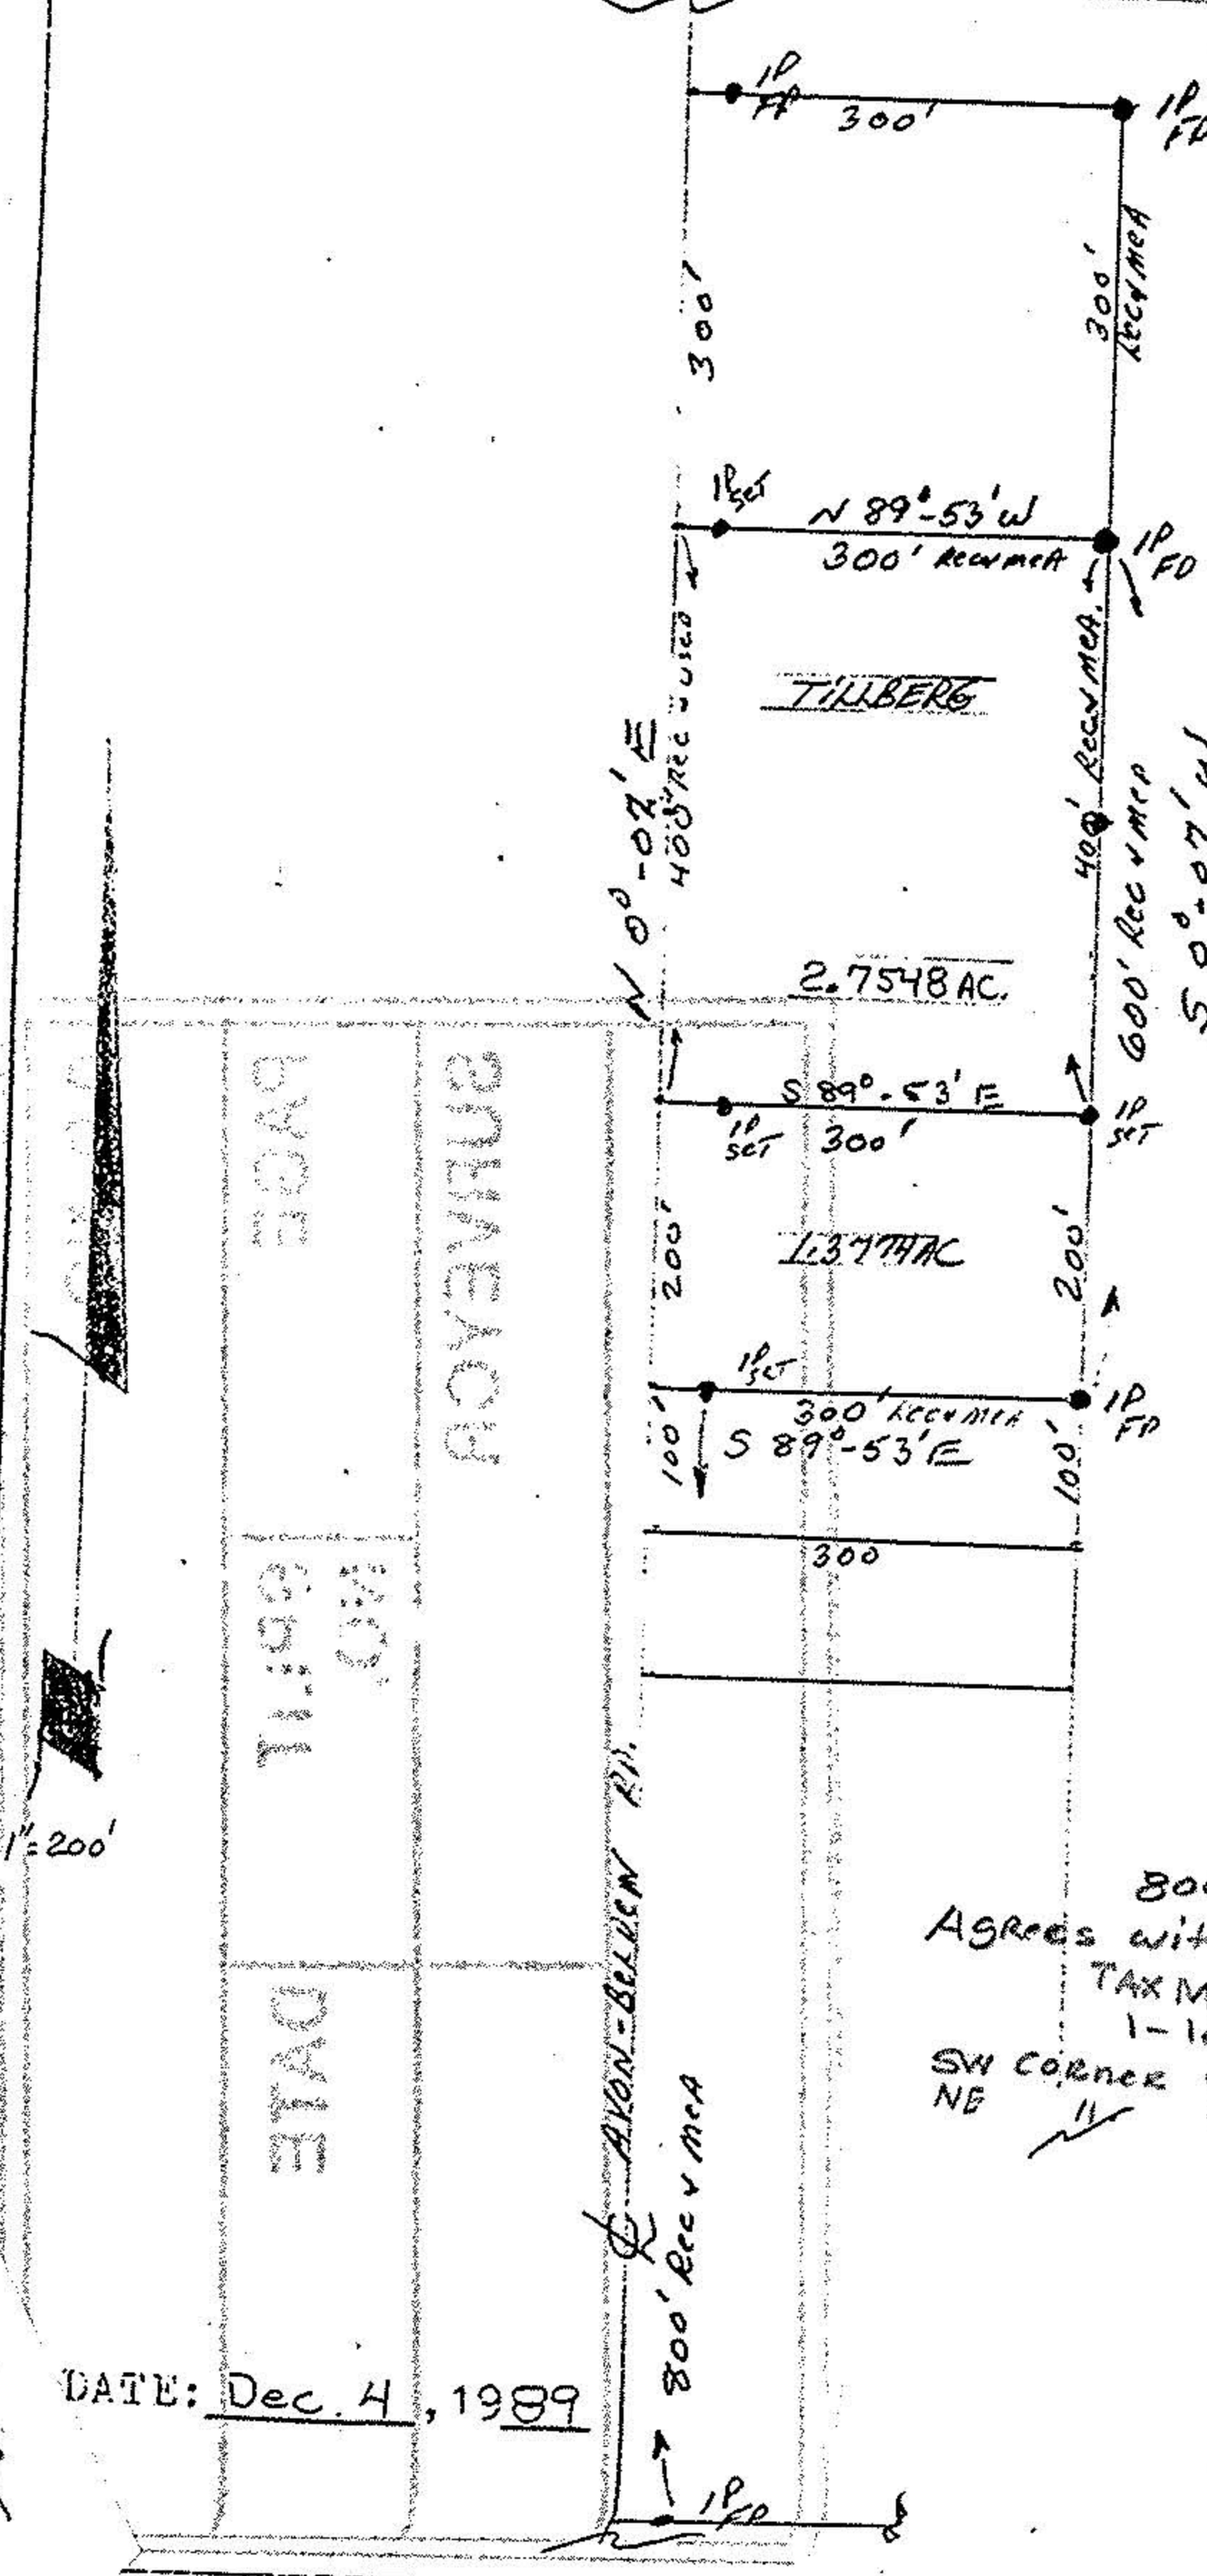

800'  
Agrees with old  
TAX MAP of  
1-18-90  
SW CORNER OF -019  
NE OF -028

#18816

APPROVED  
LORAIN CO.  
MAP DEPT.

DATE 1-18-90

PAGE 16-00-015A

BY CAROLYN  
FRANCIS

VOID  
AFTER # 18816

SCALE: 1" = 200'

DATE: Dec. 4, 1989

100'

1" = 200'