


1. Pin Set is a capped 5/8" x 30" rebar stamped CARLSON

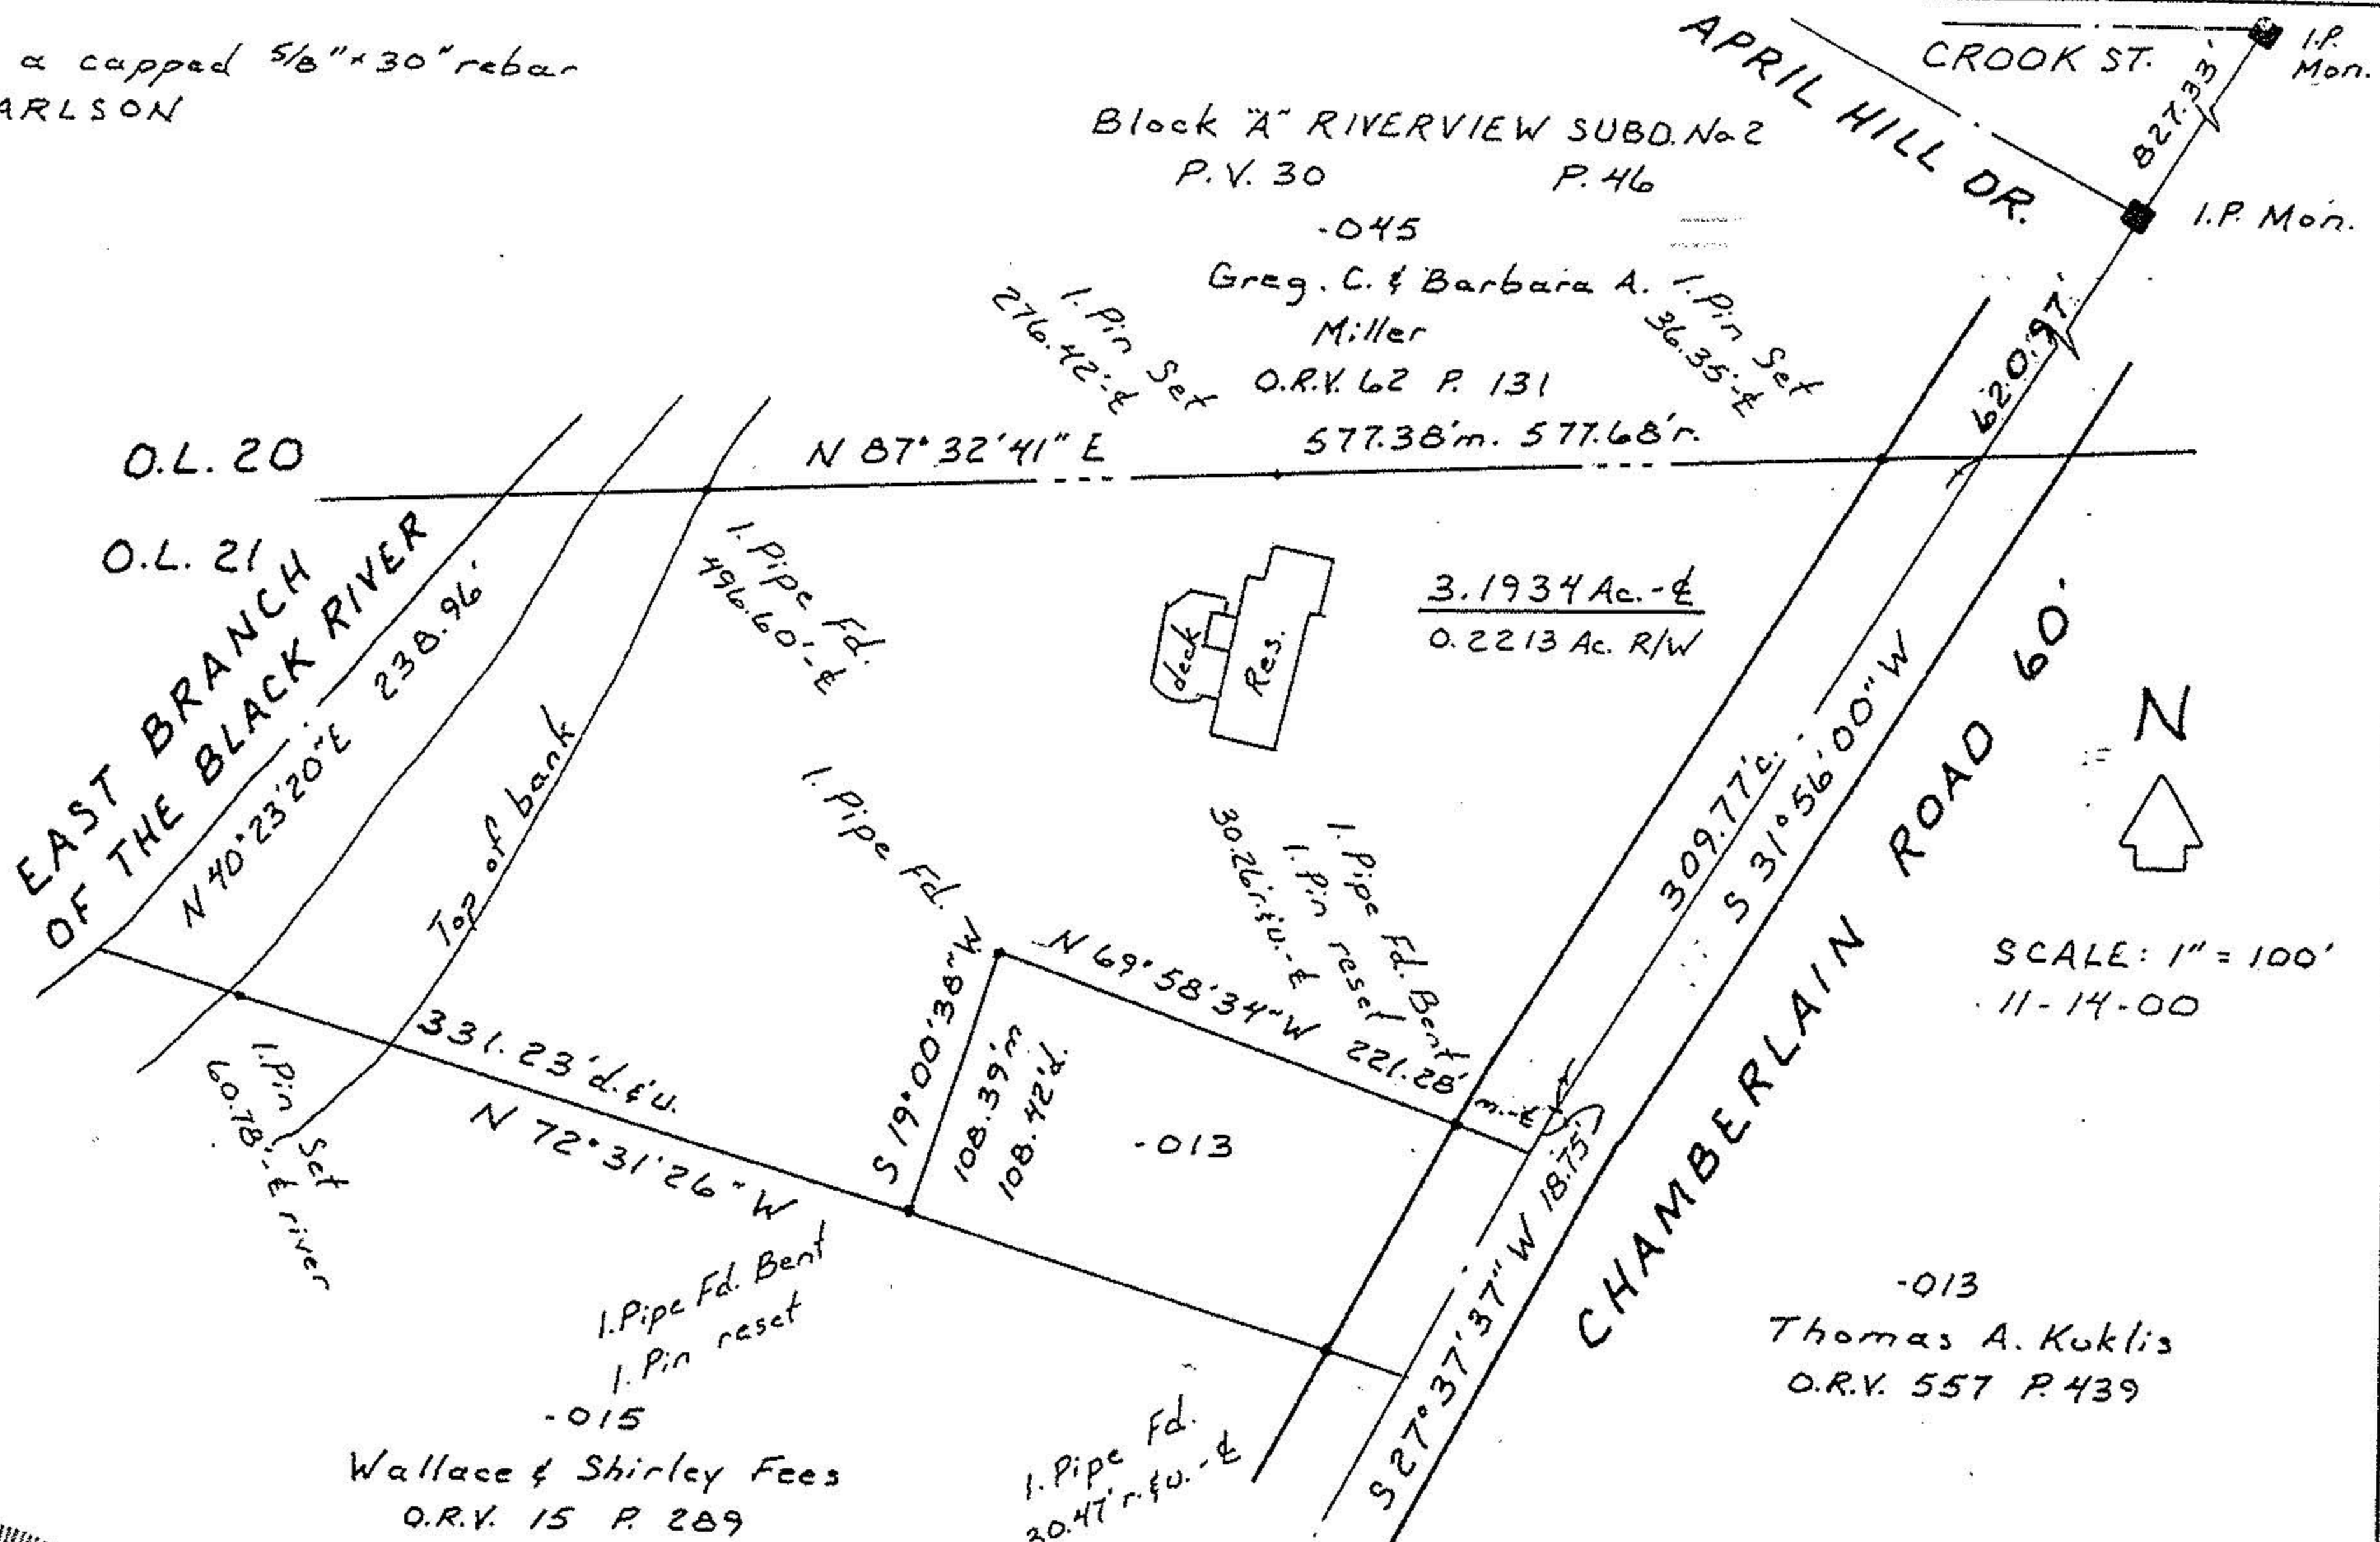

SCALE: 1" = 100'  
11-14-00



DATE	1-29-02
PAGE	16-A
BY	R. MAINES
APPROVED	LORAIN CO. MAP DEPT.
FILE NO.	02-00648-A

No 00648-A

Boundary Survey  
For  
**WILLIAM & DEBRA SINGLETON**  
Grafton Twp. O.L. 21  
County of Lorain State of Ohio  
CARLSON SURVEYS  
440-926-0200