
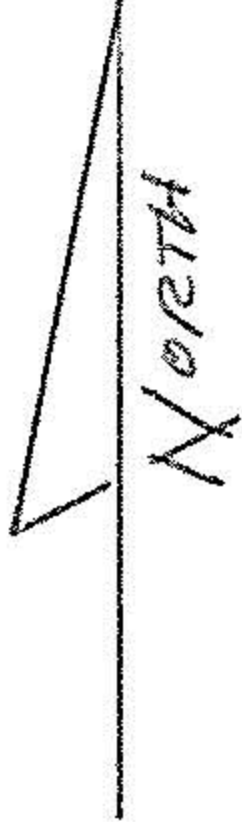


LORAIN EASTERN ROAD 6

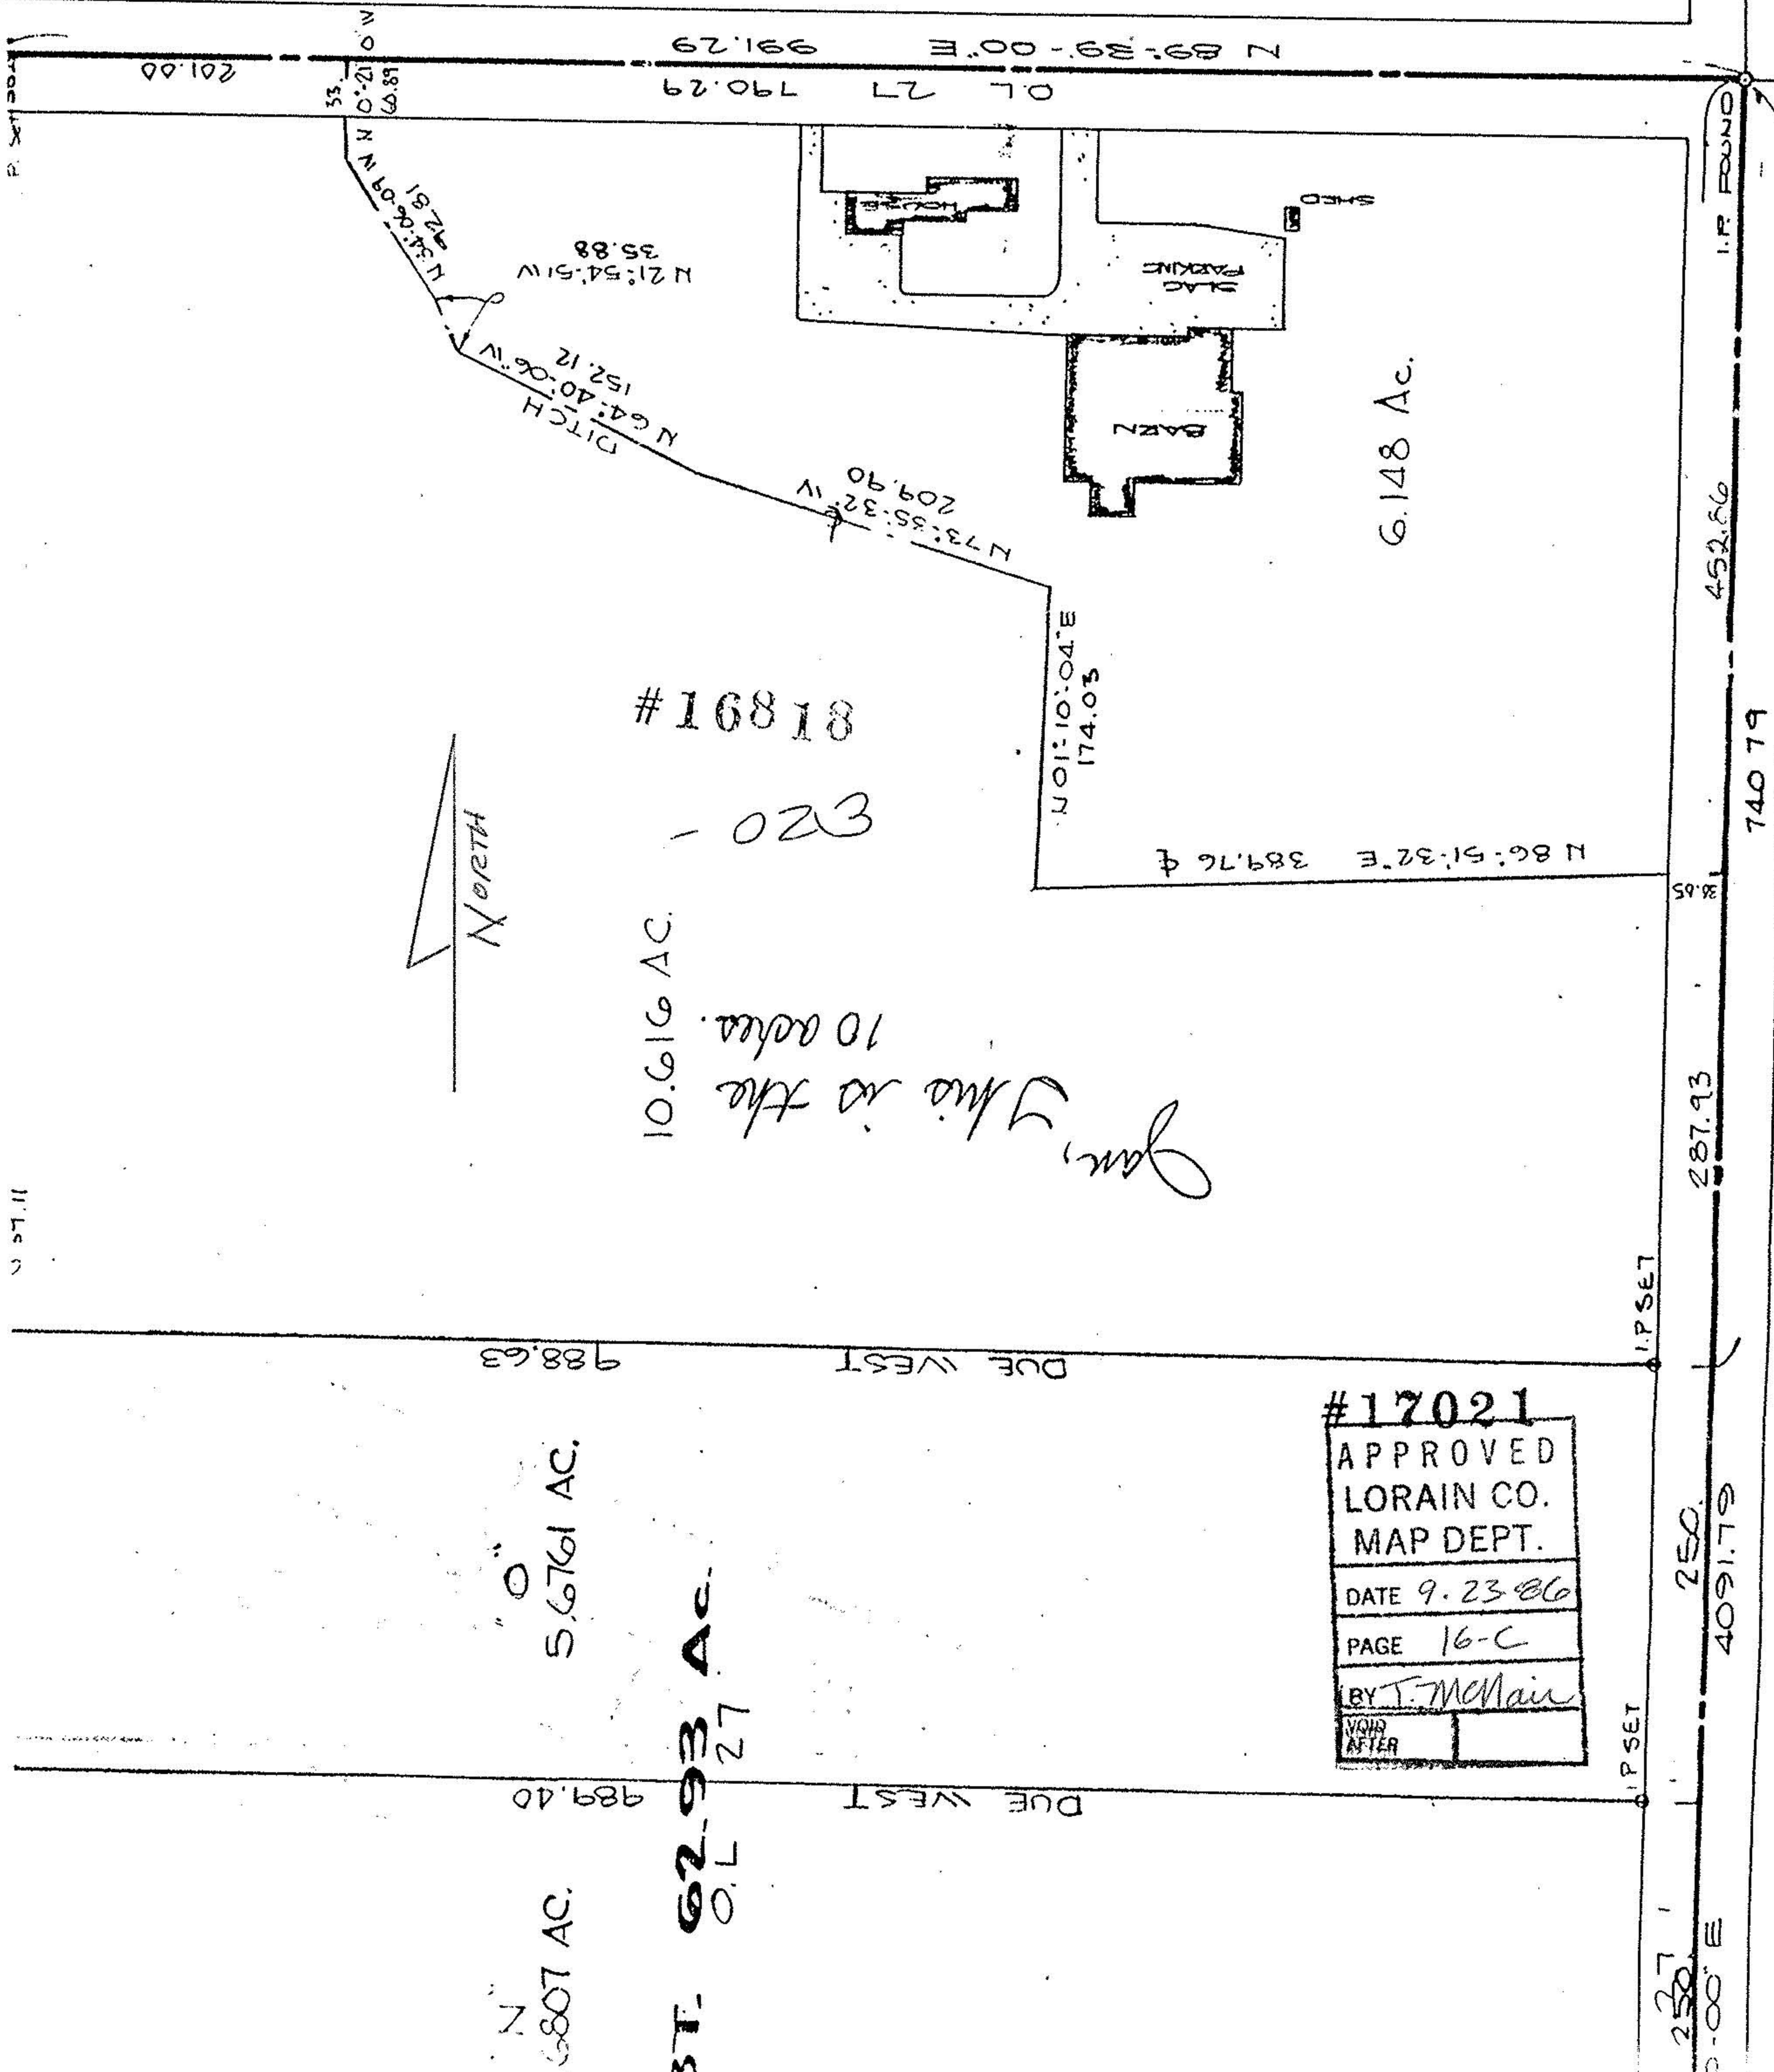

#16818

- 023

Jan, This is the 10 ac. area.

#17021
 APPROVED
 LORAIN CO.
 MAP DEPT.
 DATE 9.23.86
 PAGE 16-C
 BY T. McMain
 VOID AFTER

ROAD 60'

250' 1
 0-00" E
 250
 4091.79
 I.P. SET
 287.93
 740 79
 452.66
 I.P. FOUND