




LAUNDON . SIMON . CAHL & ASSOC. INC.
CONSULTING ENGINEERS & SURVEYORS
219 COURT ST. ELYRIA, OHIO 44035

SURVEY FOR:

DOMINIC FERRITO

Orig. Lot 30	City of	Date APRIL '86 Scale 1"=200'
Orig. Sec	Village of	Dwn. by R.G.S. Chkd. by
Tract	County of LORAIN	Job No. 86-1472 F.B. —
Township of GRAFTON	State of OHIO	Printed MAY - 2

#18433 16-00-030-000-16-D

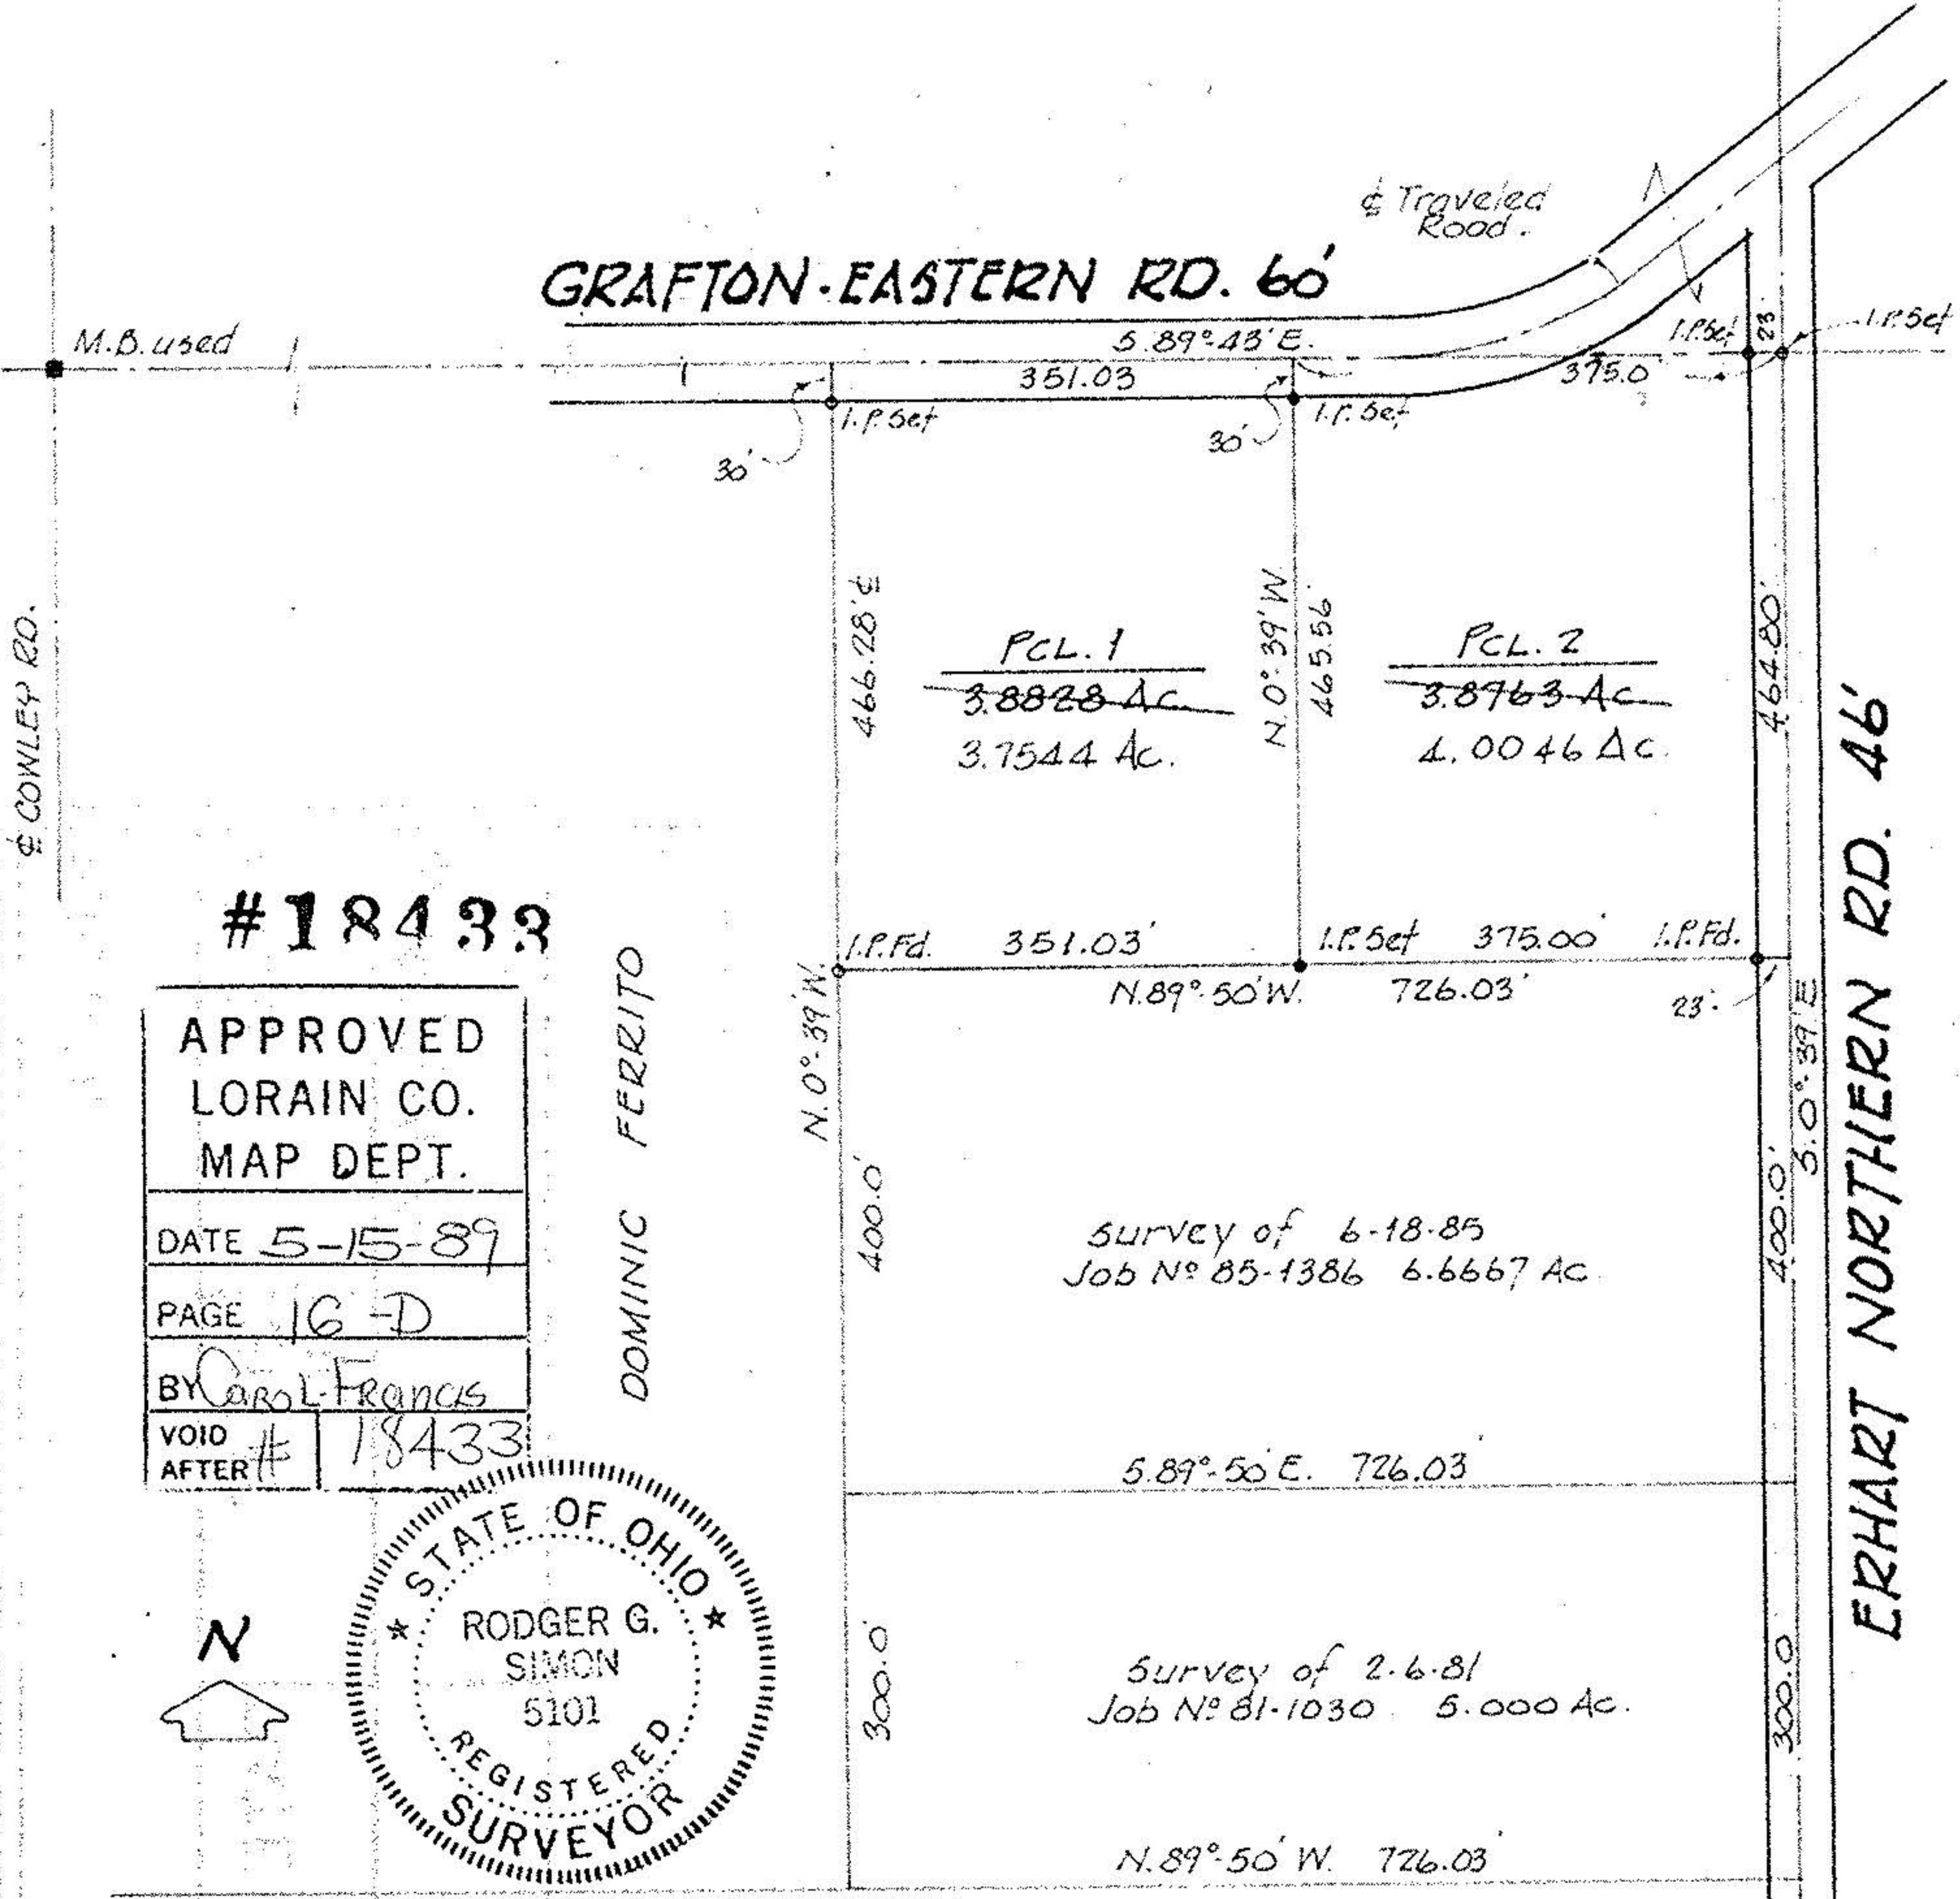

#18433


APPROVED
LORAIN CO.
MAP DEPT.

DATE 5-15-89

PAGE 16-D

BY Carol Francis

VOID AFTER # 18433

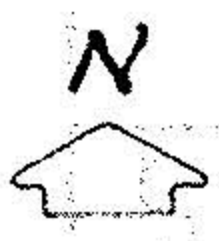

CARL W. & PATRICIA DEIMLING
V.952 P.405

REV. MAY 1, 1989 (Pcl. 2)