



LAUNDON, SIMON, CAHL & ASSOC. INC.
CONSULTING ENGINEERS & SURVEYORS
219 COURT ST. ELYRIA, OHIO 44035


SURVEY FOR:

DOMINIC FERRITO

16-00-030-000

16-D

Orig. Lot #30	City of	Date APRIL '86 Scale 1"=200'
Orig. Sec	Village of	Dwn. by R.G.S. Chkd. by
Tract	County of LORAIN	Job No. 86-1472 F.B. —
Township of GRAFTON	State of OHIO	Printed JAN 2

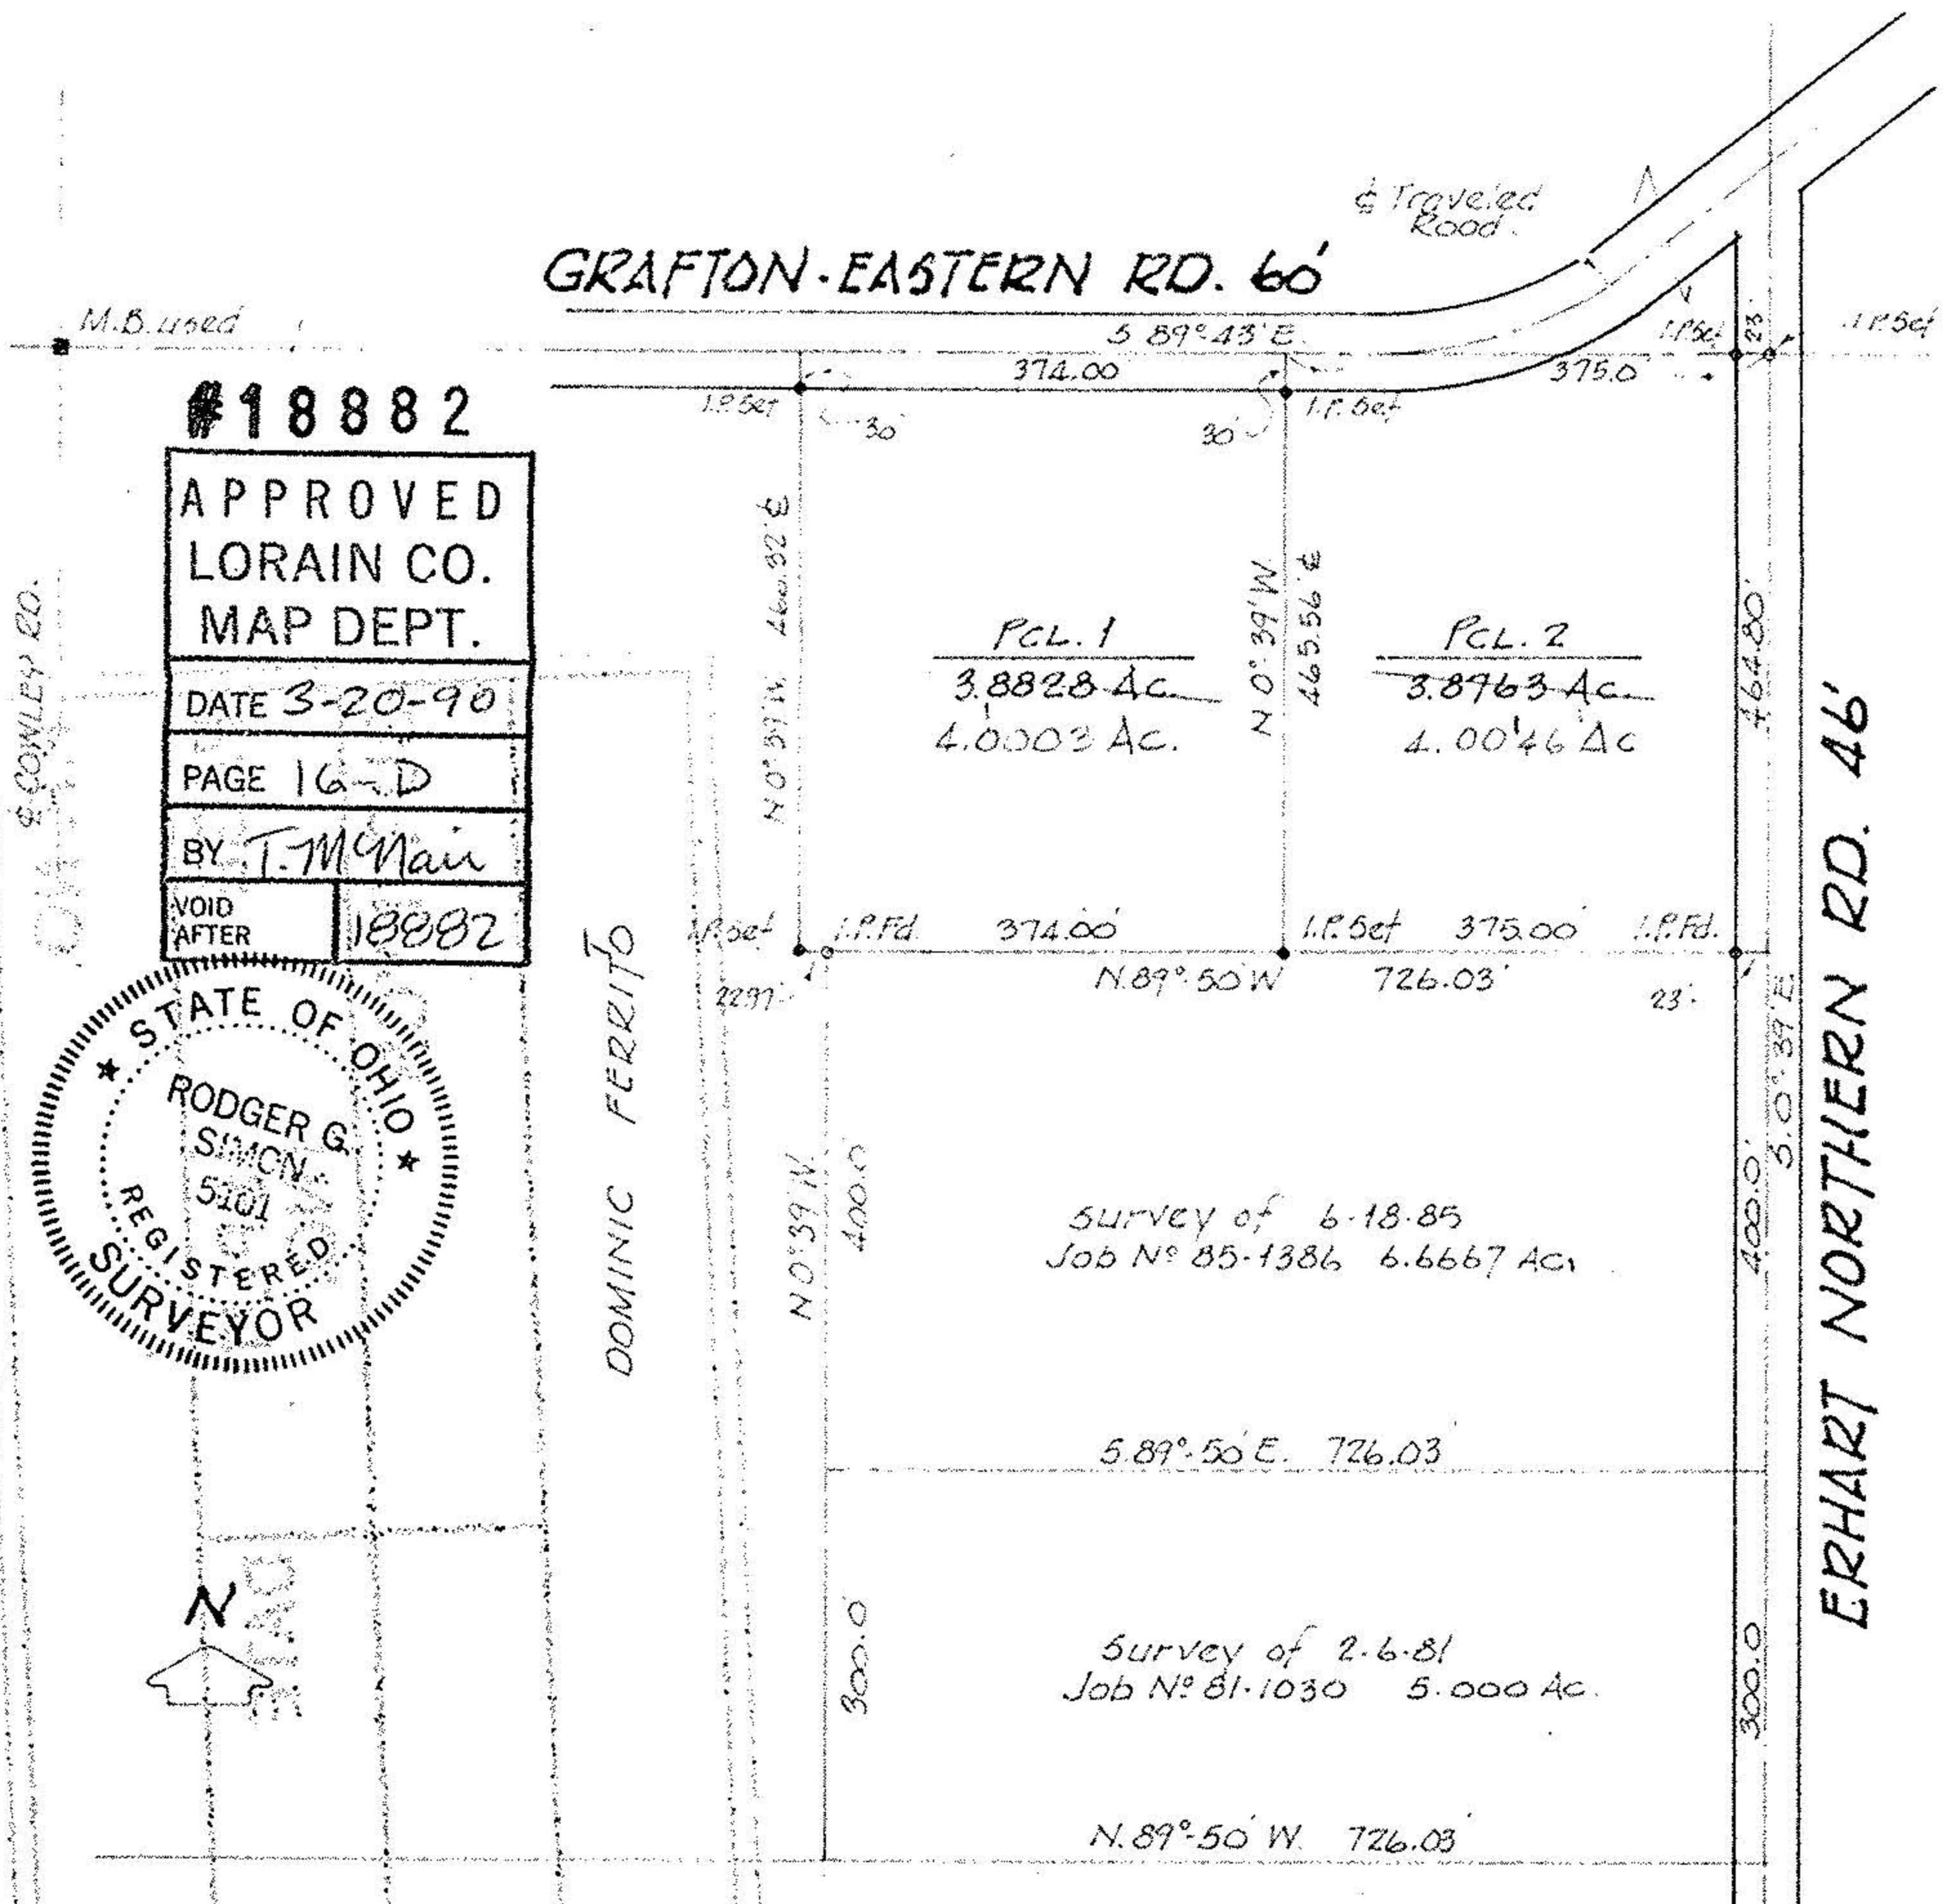

#18882
 APPROVED
 LORAIN CO.
 MAP DEPT.
 DATE 3-20-90
 PAGE 16-D
 BY T. McNair
 VOID AFTER 18882



CARL W. & PATRICIA DEIMLING
V. 952 P. 405

REV. 12-15-89 Change Parcel to 4.0 Ac.
REV. MAY 1, 1989 (PCL. 2)