




LAUNDON • SIMON • CAHL & ASSOC., INC.
CONSULTING ENGINEERS & SURVEYORS
110 MIDDLE AVE., ELYRIA, O. 44035

SURVEY FOR:
JOE FERRITO

Orig. Lot 30	City of	Date 9/22/95 Scale 1"=100'
Orig. Sec	Village of	Dwn. by R.G.S., Chkd. by R.C.
Tract	County of LORAIN	Job No. 95-2777 F.B.235/58
Township of GRAFTON	State of OHIO	Printed

21573

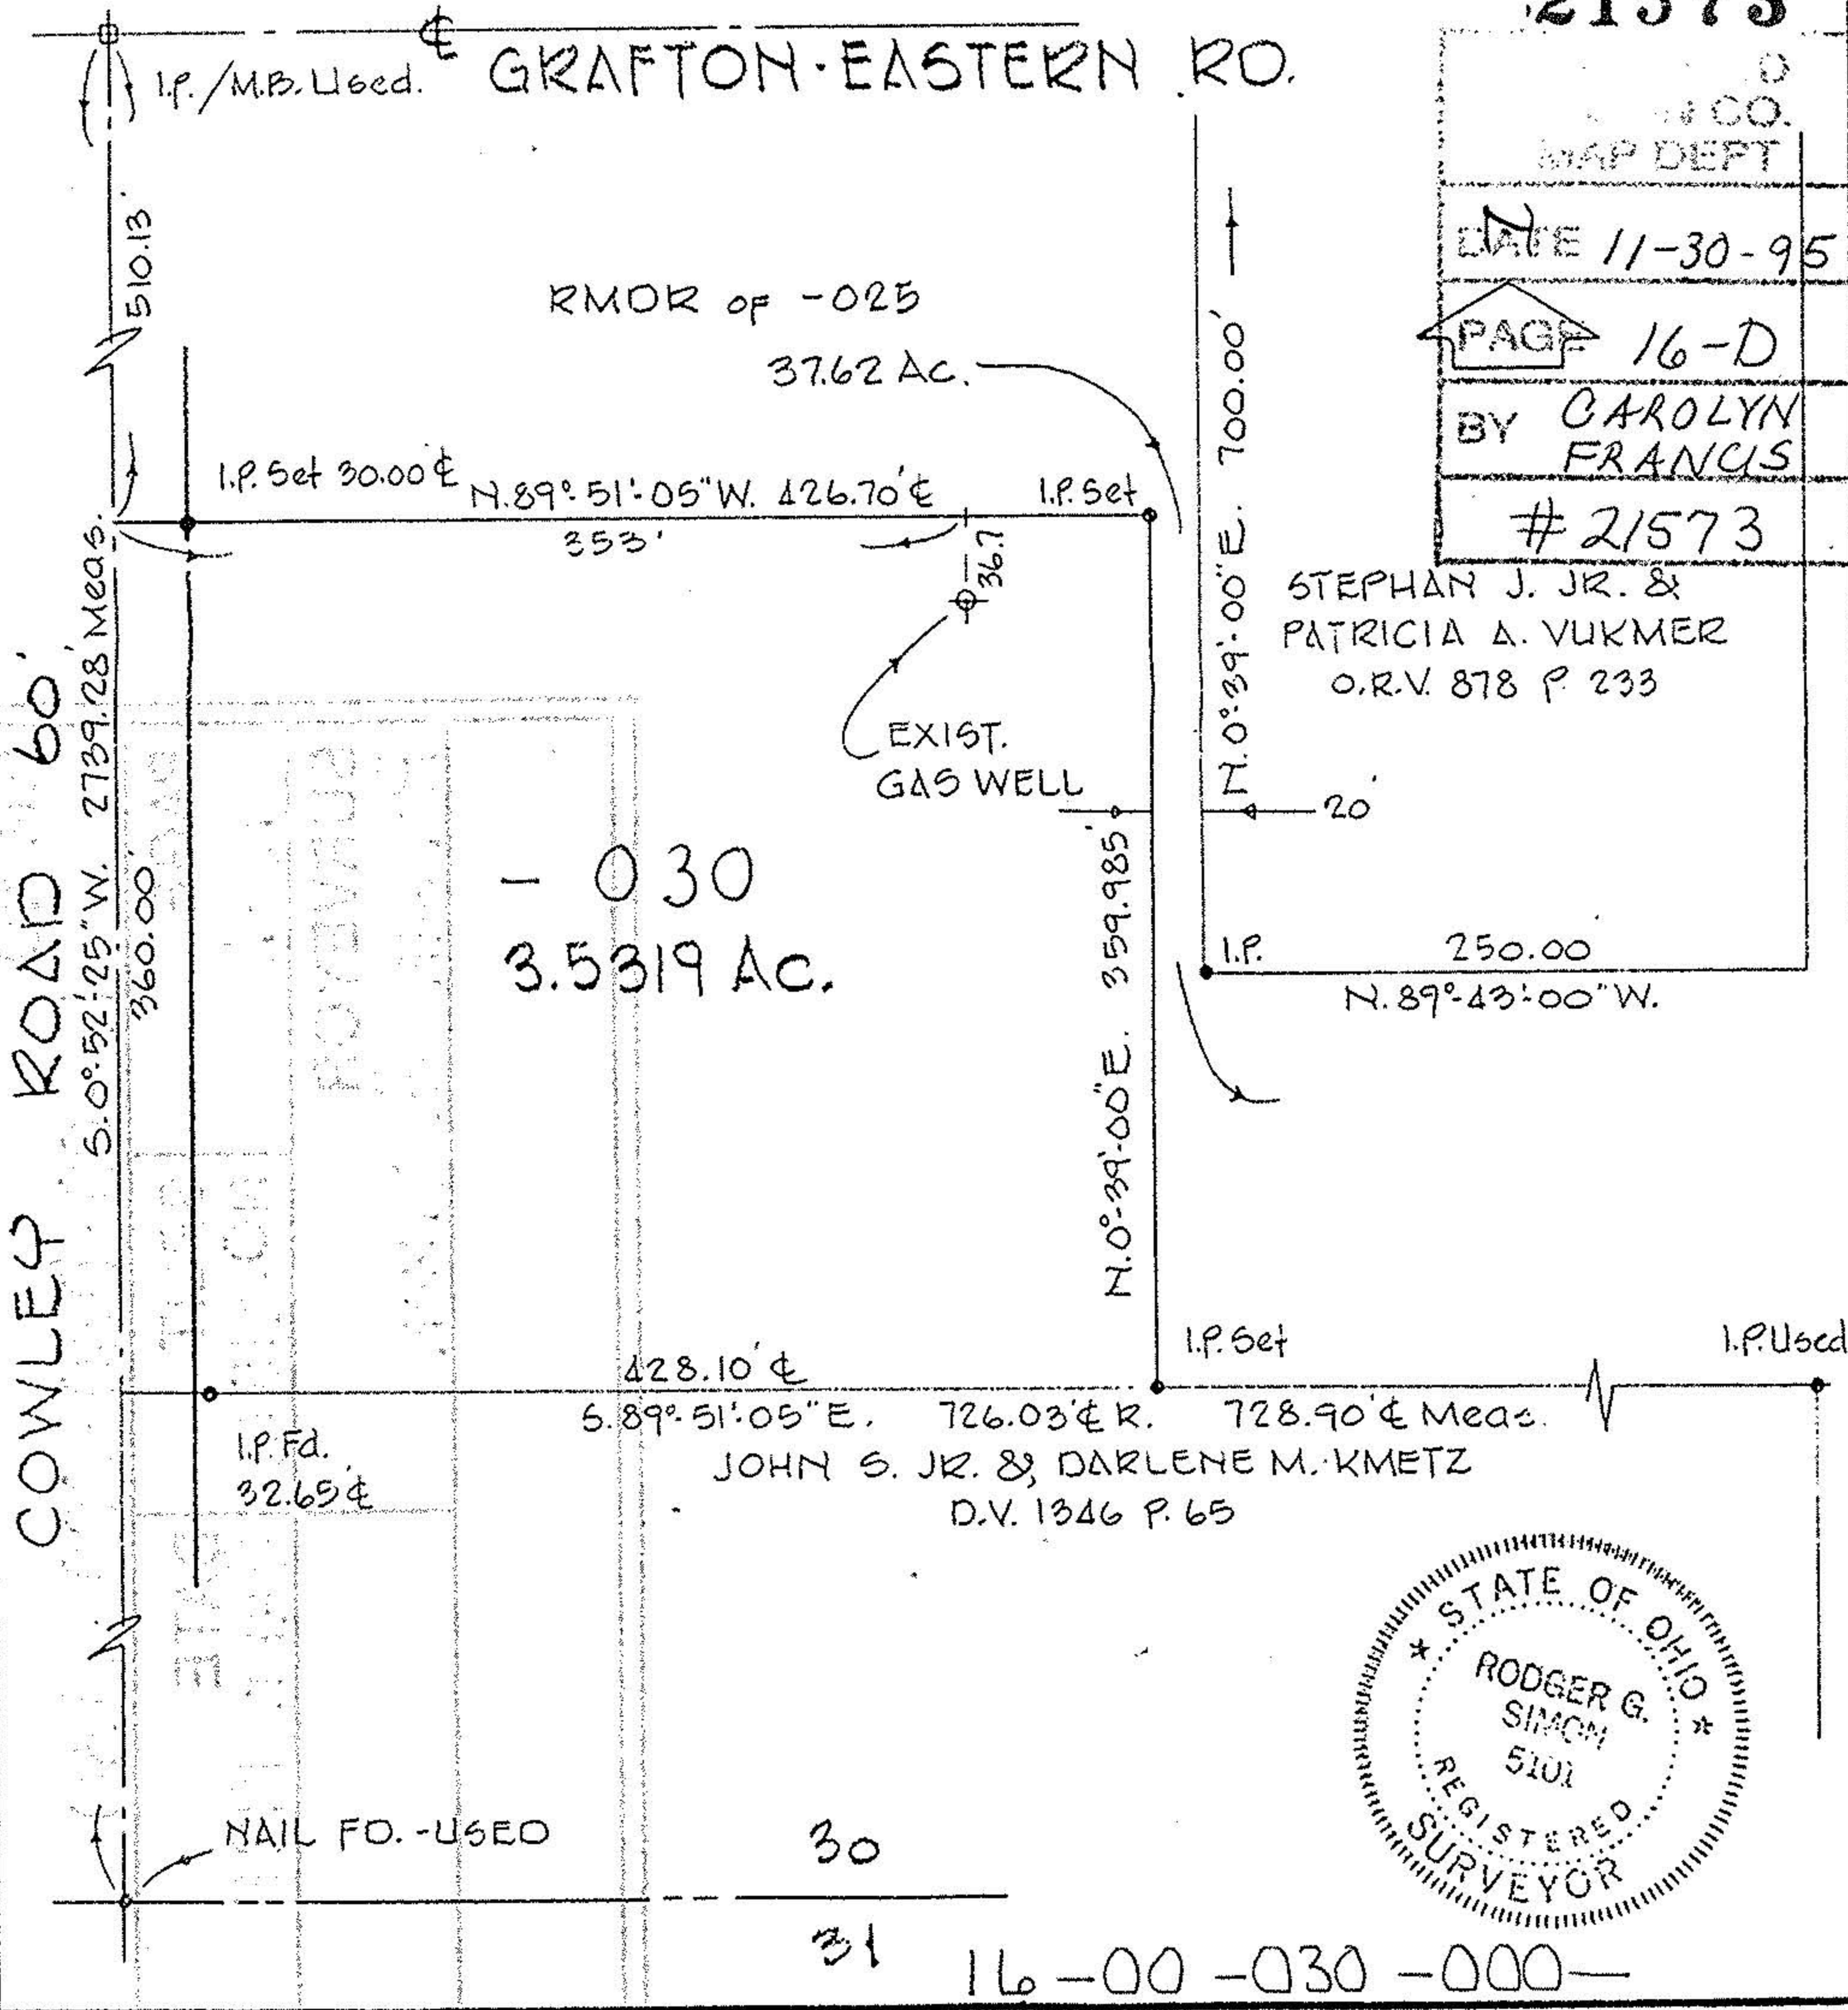

CO. MAP DEPT
DATE 11-30-95
PAGE 16-D
BY CAROLYN FRANCIS
#21573

STEPHAN J. JR. &
PATRICIA A. VUKMER
O.R.V. 878 P. 233

JOHN S. JR. & DARLENE M. KMETZ
D.V. 1346 P. 65

16-00-030-000-