




LAUNDON • SIMON • CAHL & ASSOC., INC.
 CONSULTING ENGINEERS & SURVEYORS
 110 MIDDLE AVE., ELYRIA, O. 44035

SURVEY FOR
Dominic Ferritto

Orig. Lot 30	City of	Date <i>April 19, 1996</i> Scale 1"=200'
Orig. Sec	Village of	Dwn. by <i>RC</i> Chkd. by <i>RS</i>
Tract	County of <i>Lorain</i>	Job No. <i>96-2853</i> F.B. <i>238 P. 62</i>
Township of <i>Grafton</i>	State of <i>Ohio</i>	Printed

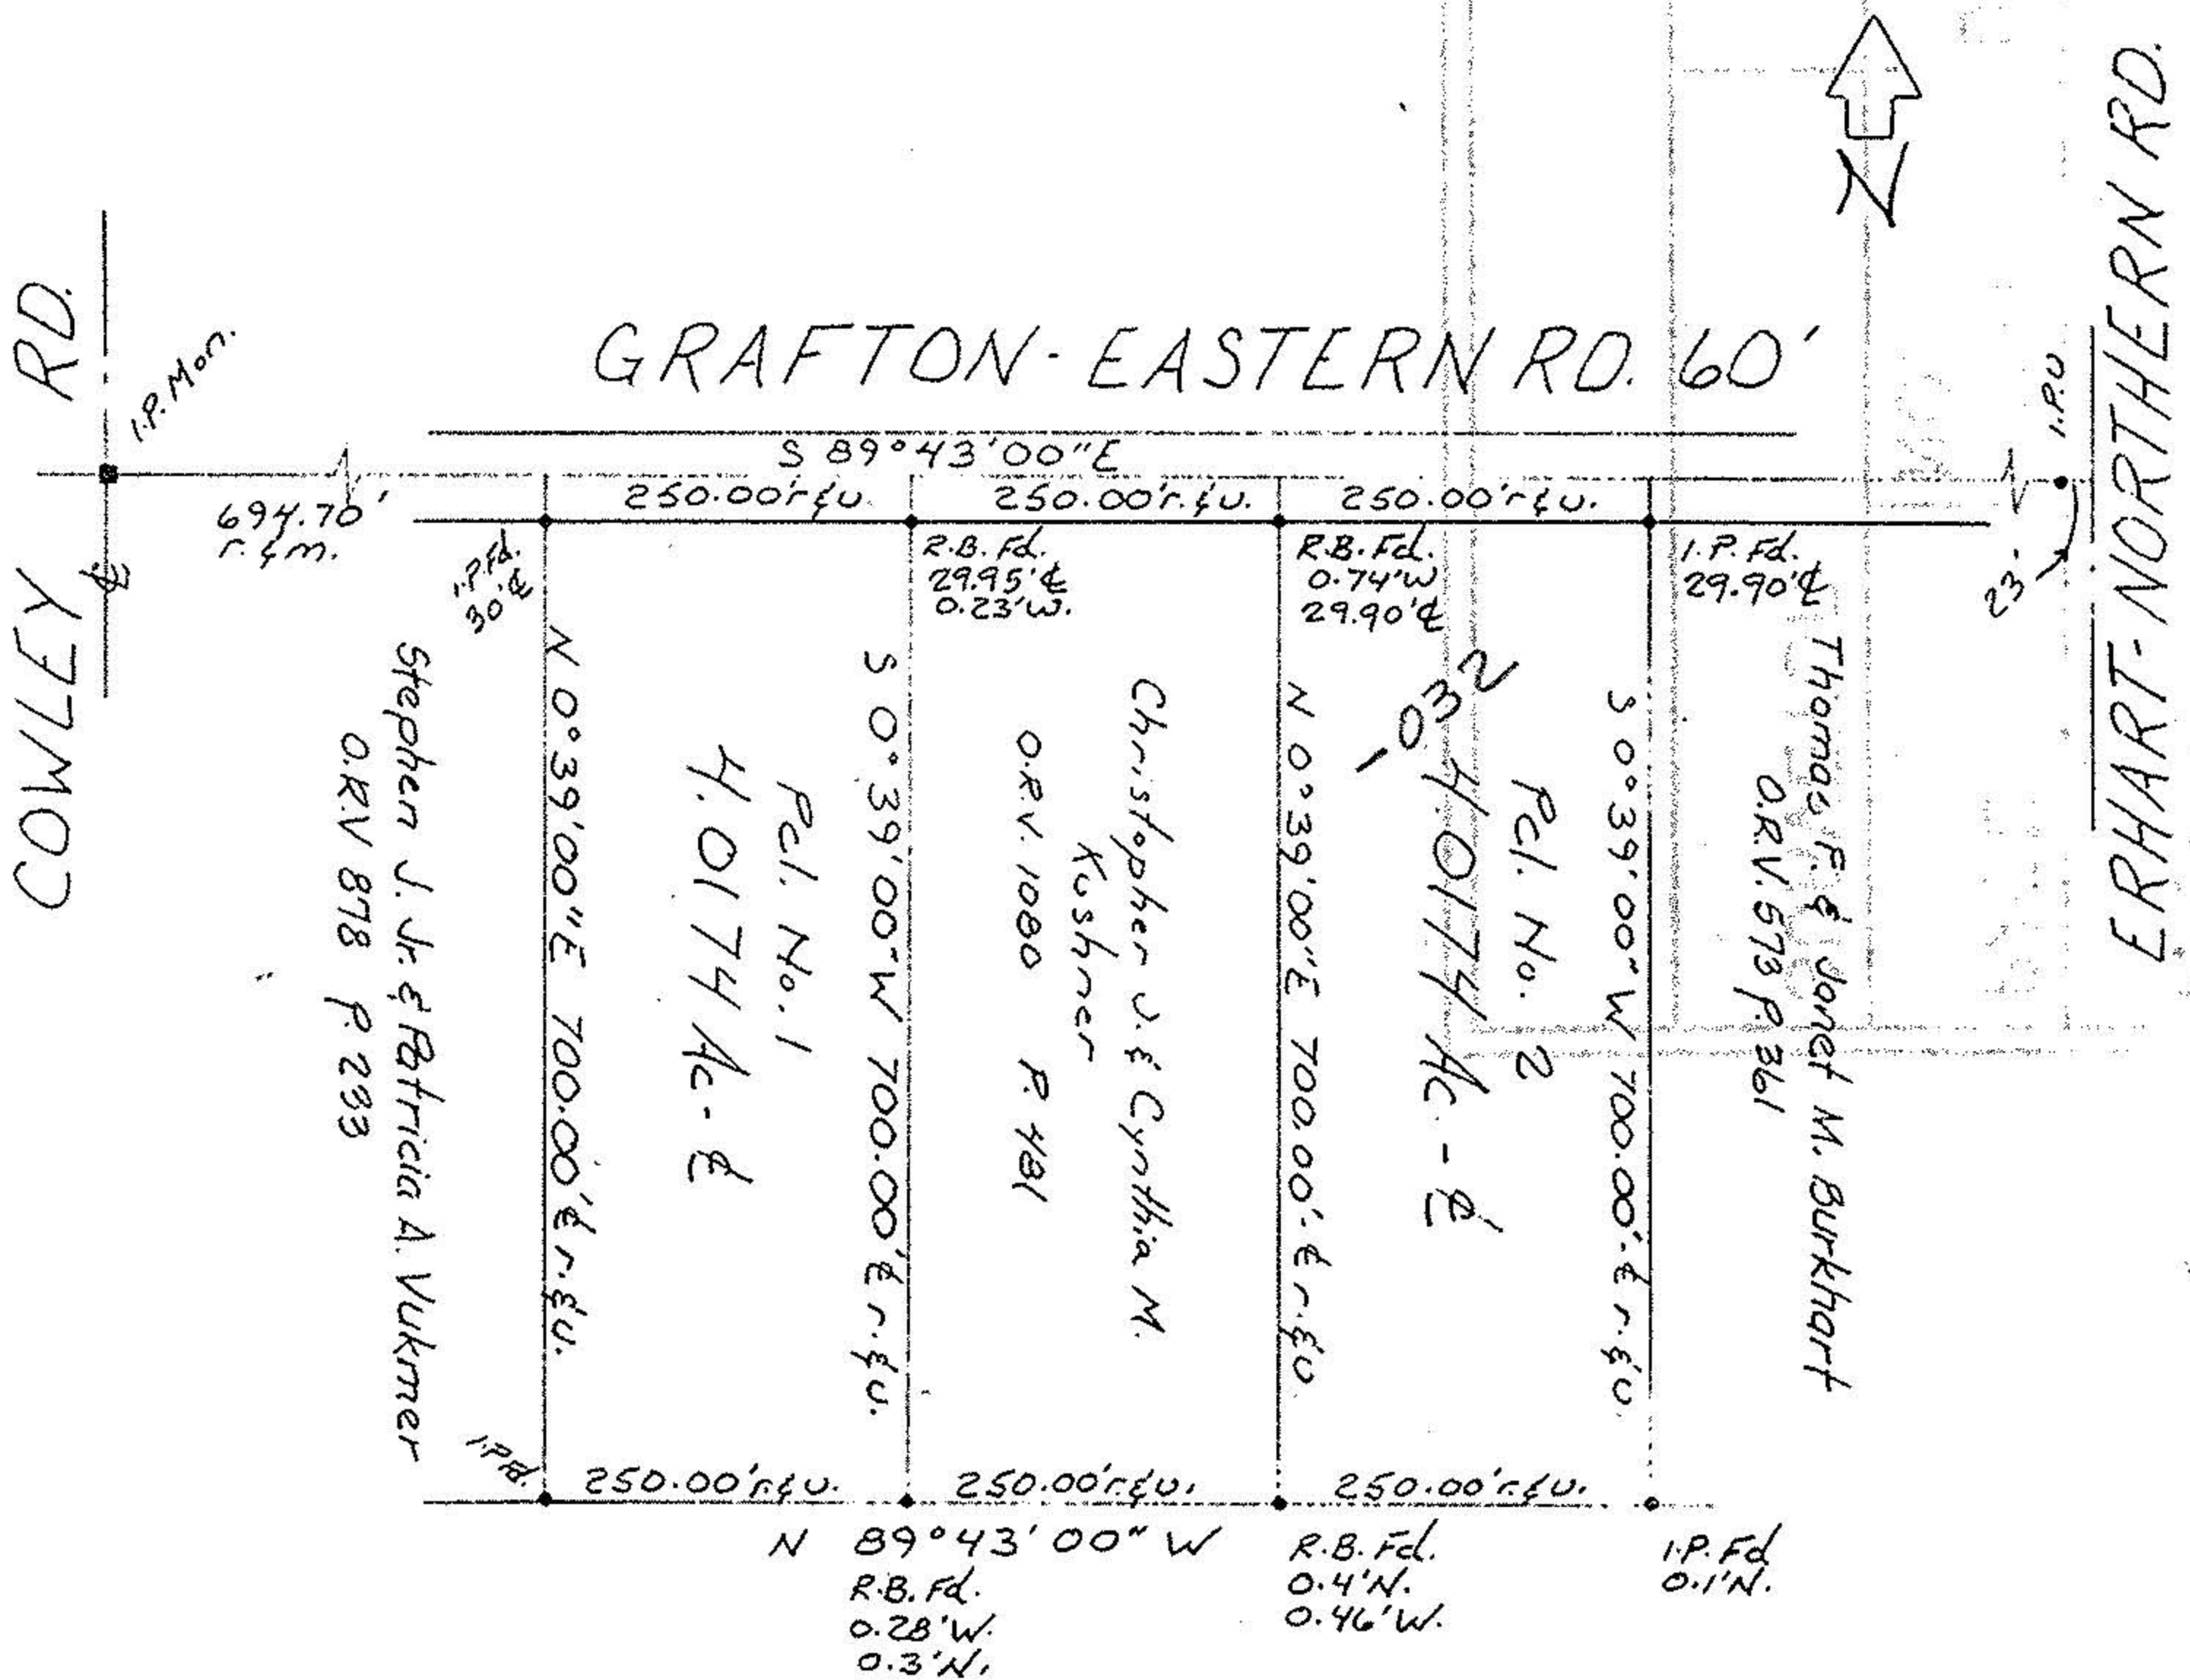

21854

APPROVED LORAIN CO. MAP DEPT.
DATE <i>7-18-96</i>
PAGE <i>16-D</i>
BY <i>K. DYE</i>
VOID AFTER # <i>21854</i>

Rmder. - 031 22.56 Ac. Calc.
 Dominic Ferritto
 D.V. 1360 P. 88

