




LAUNDON . SIMON . CAHL & ASSOC. INC.
 CONSULTING ENGINEERS & SURVEYORS
 ELYRIA, OHIO 44035

SURVEY FOR:

GEORGE & ANNA BOX

Orig. Lot 25	City of	Date AUG. '90 Scale 1"=100'
Orig. Sec	Village of	Dwn. by R.G.S. Chkd. by J.P.
Tract	County of LORAIN	Job No. 90-1954 F.B.
Township of GRAFTON	State of OHIO	Printed

SURVEY of PART of S/L's 29 & 30
 KINGSLEY ACRES PLAT VOL. 12 P. 29

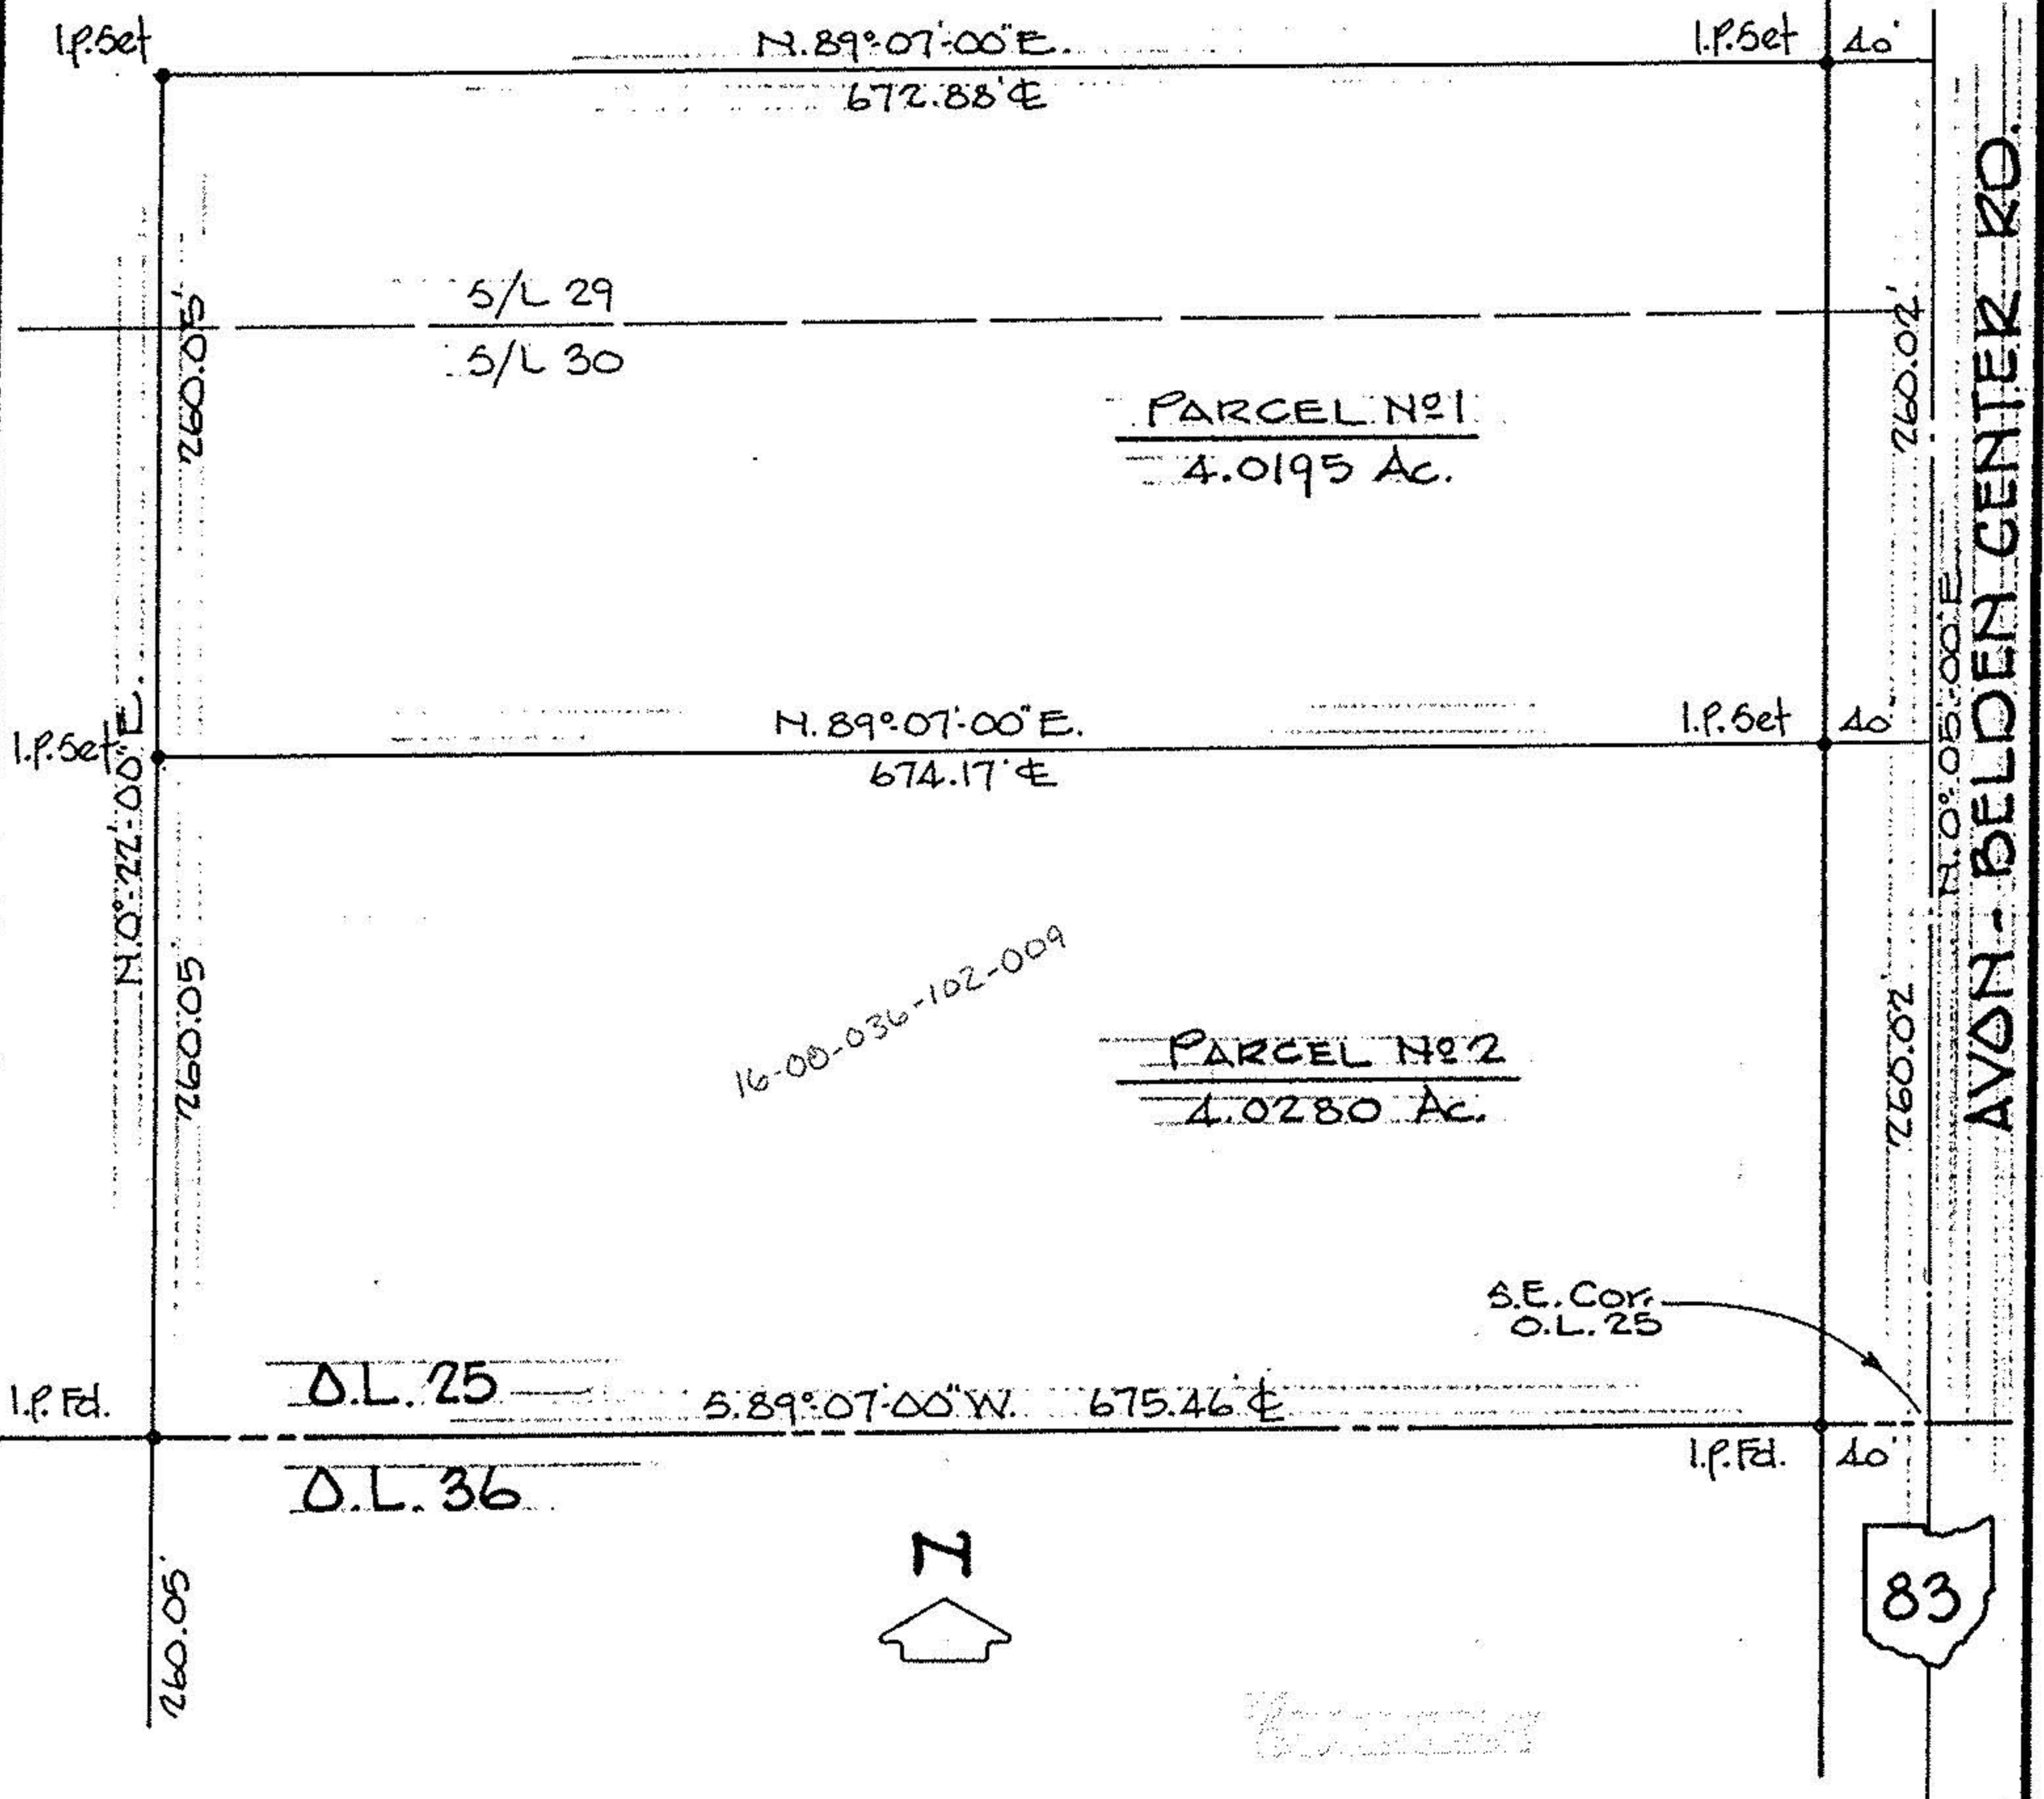

AVON-BELDEN CENTER RD.

83



[Faint signature or stamp]