


16-A

# 15495

16-00-038-000

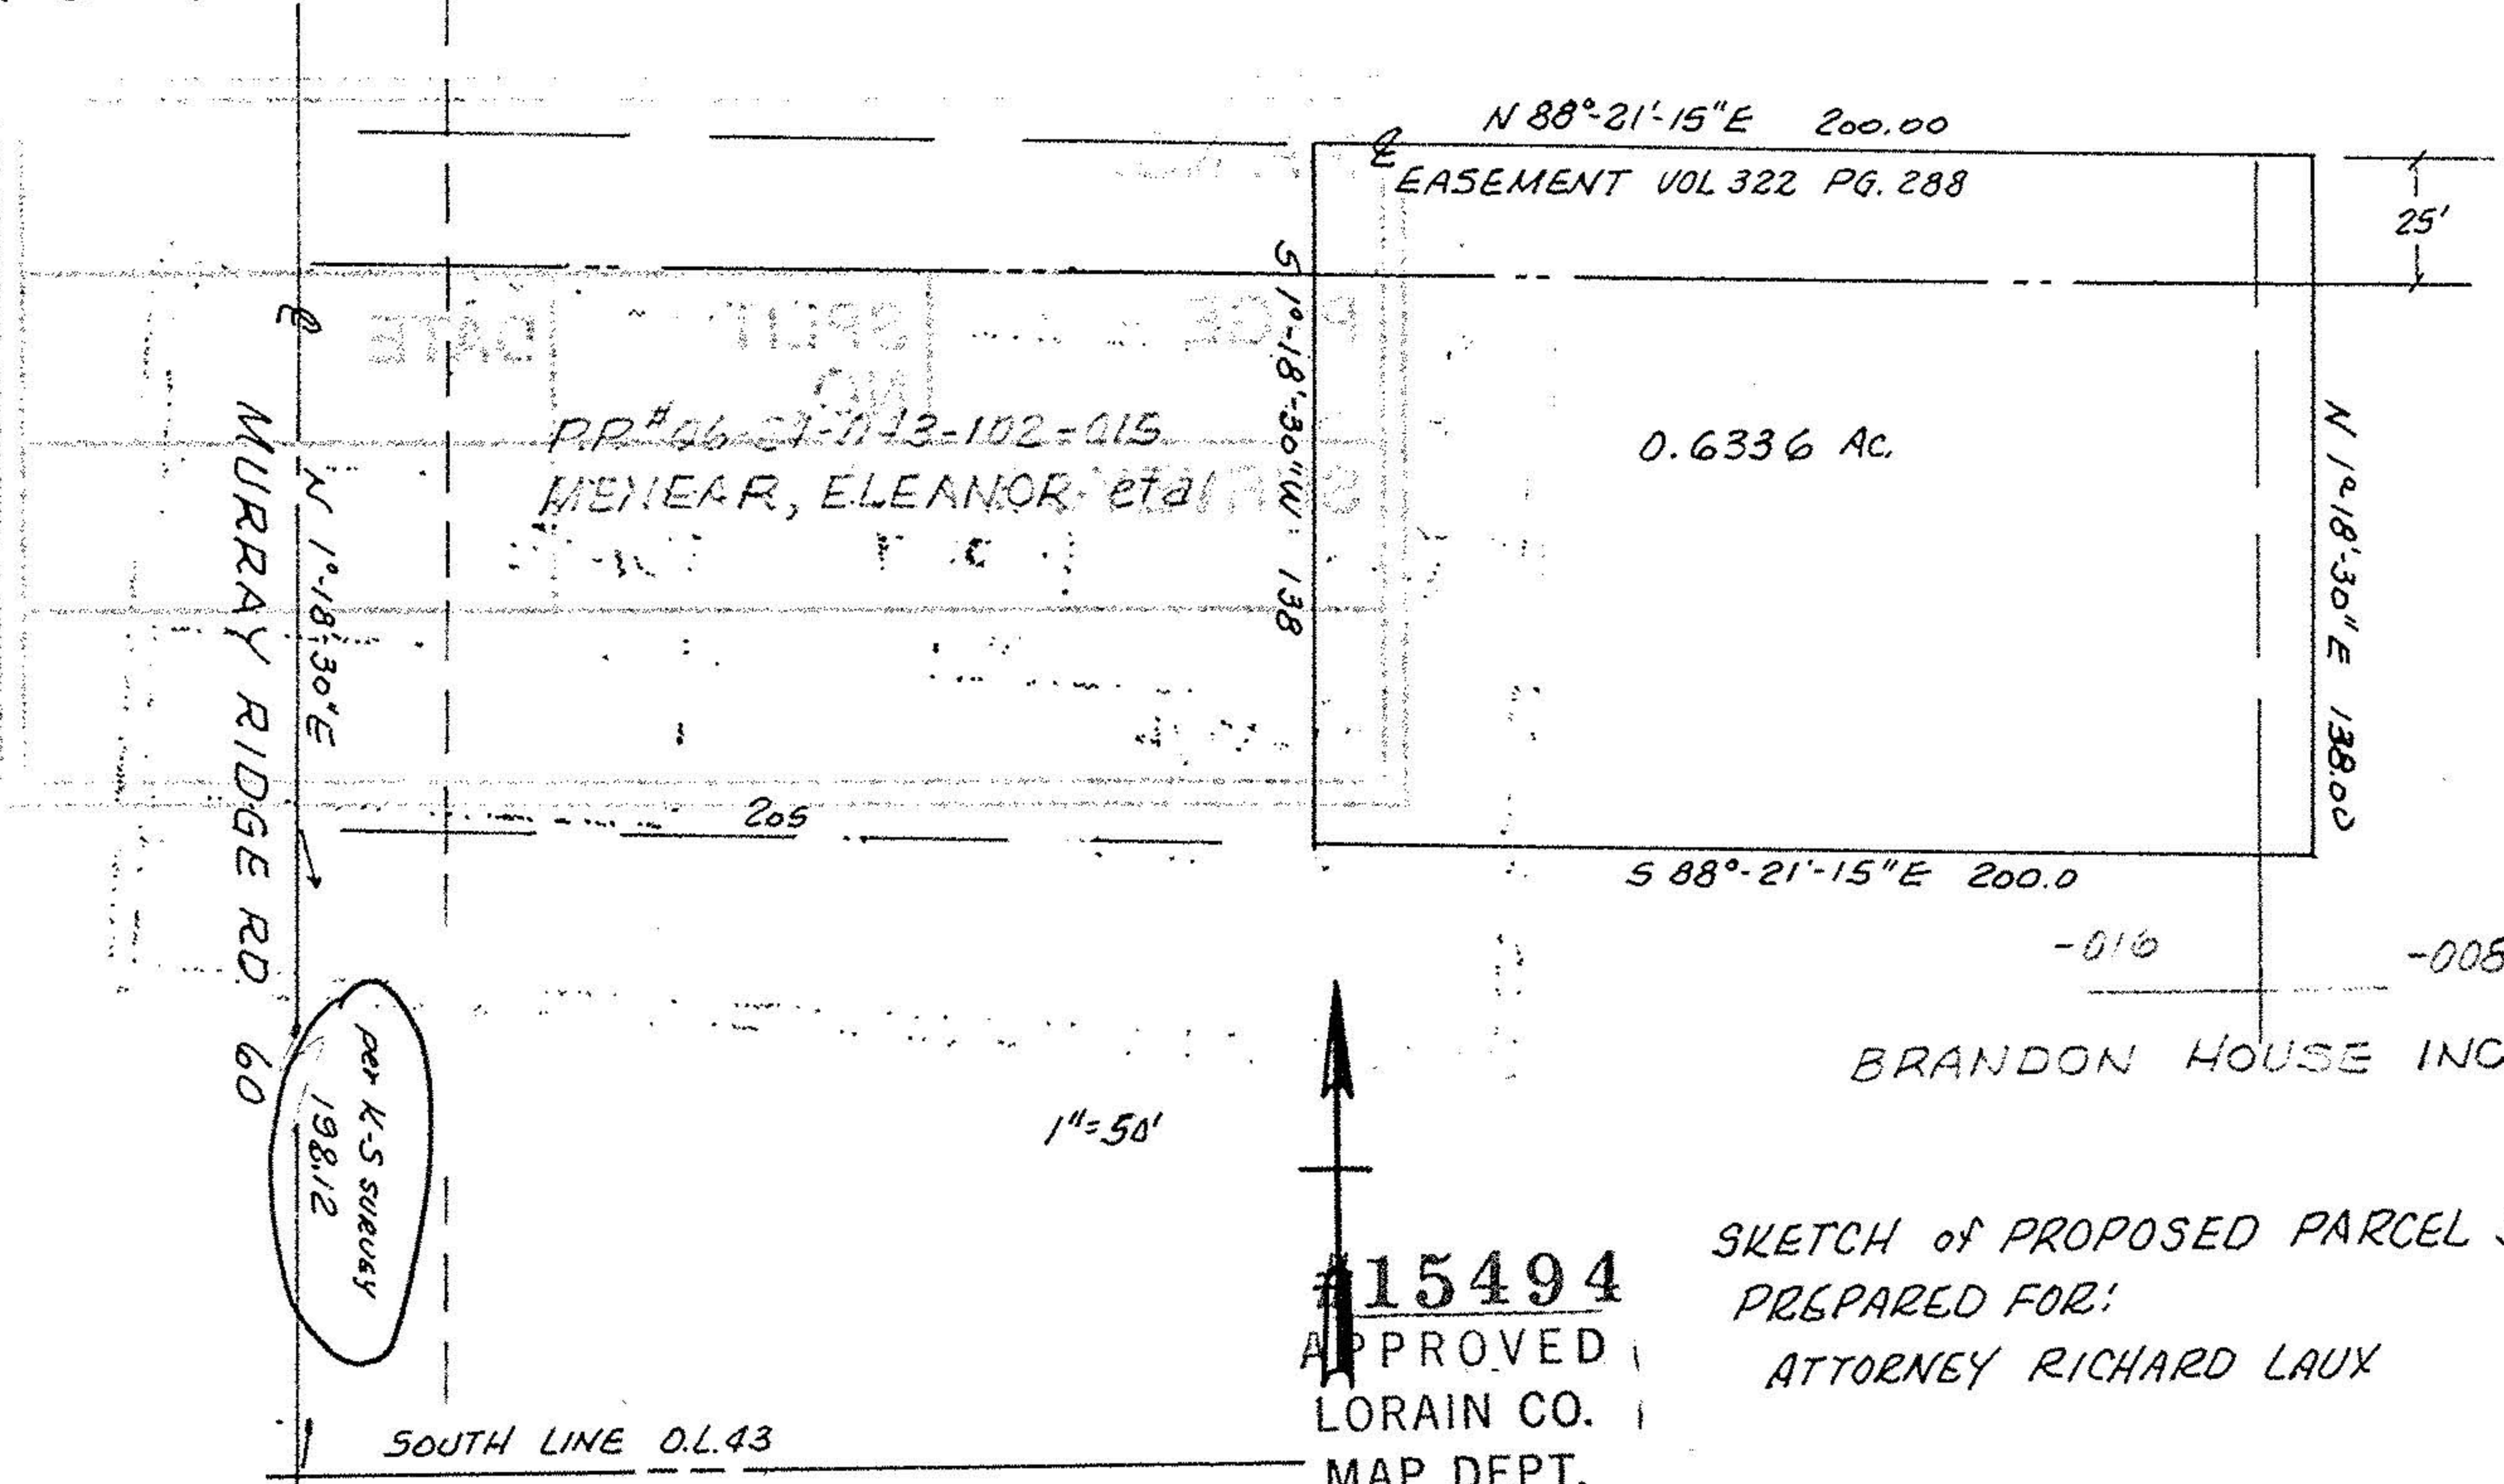

#15494  
 APPROVED  
 LORAIN CO.  
 MAP DEPT.  
 DATE 4-11-84  
 PAGE 6.58  
 BY T. McMain  
 VOID

SKETCH of PROPOSED PARCEL SPLIT  
 PREPARED FOR:  
 ATTORNEY RICHARD LAUX

THIS IS NOT A PLAT OF SURVEY:

PART of ORIG. ELYRIA  
 NOW in CITY of  
 LORAIN COUNTY

TWP. LOT 43 WEST OF BLACK RIVER  
 , OHIO

McGLINCHY & ASSOCIATES INC.

MAR 22, 1984

#848256