


H10001

Taylor Mc. Arroy

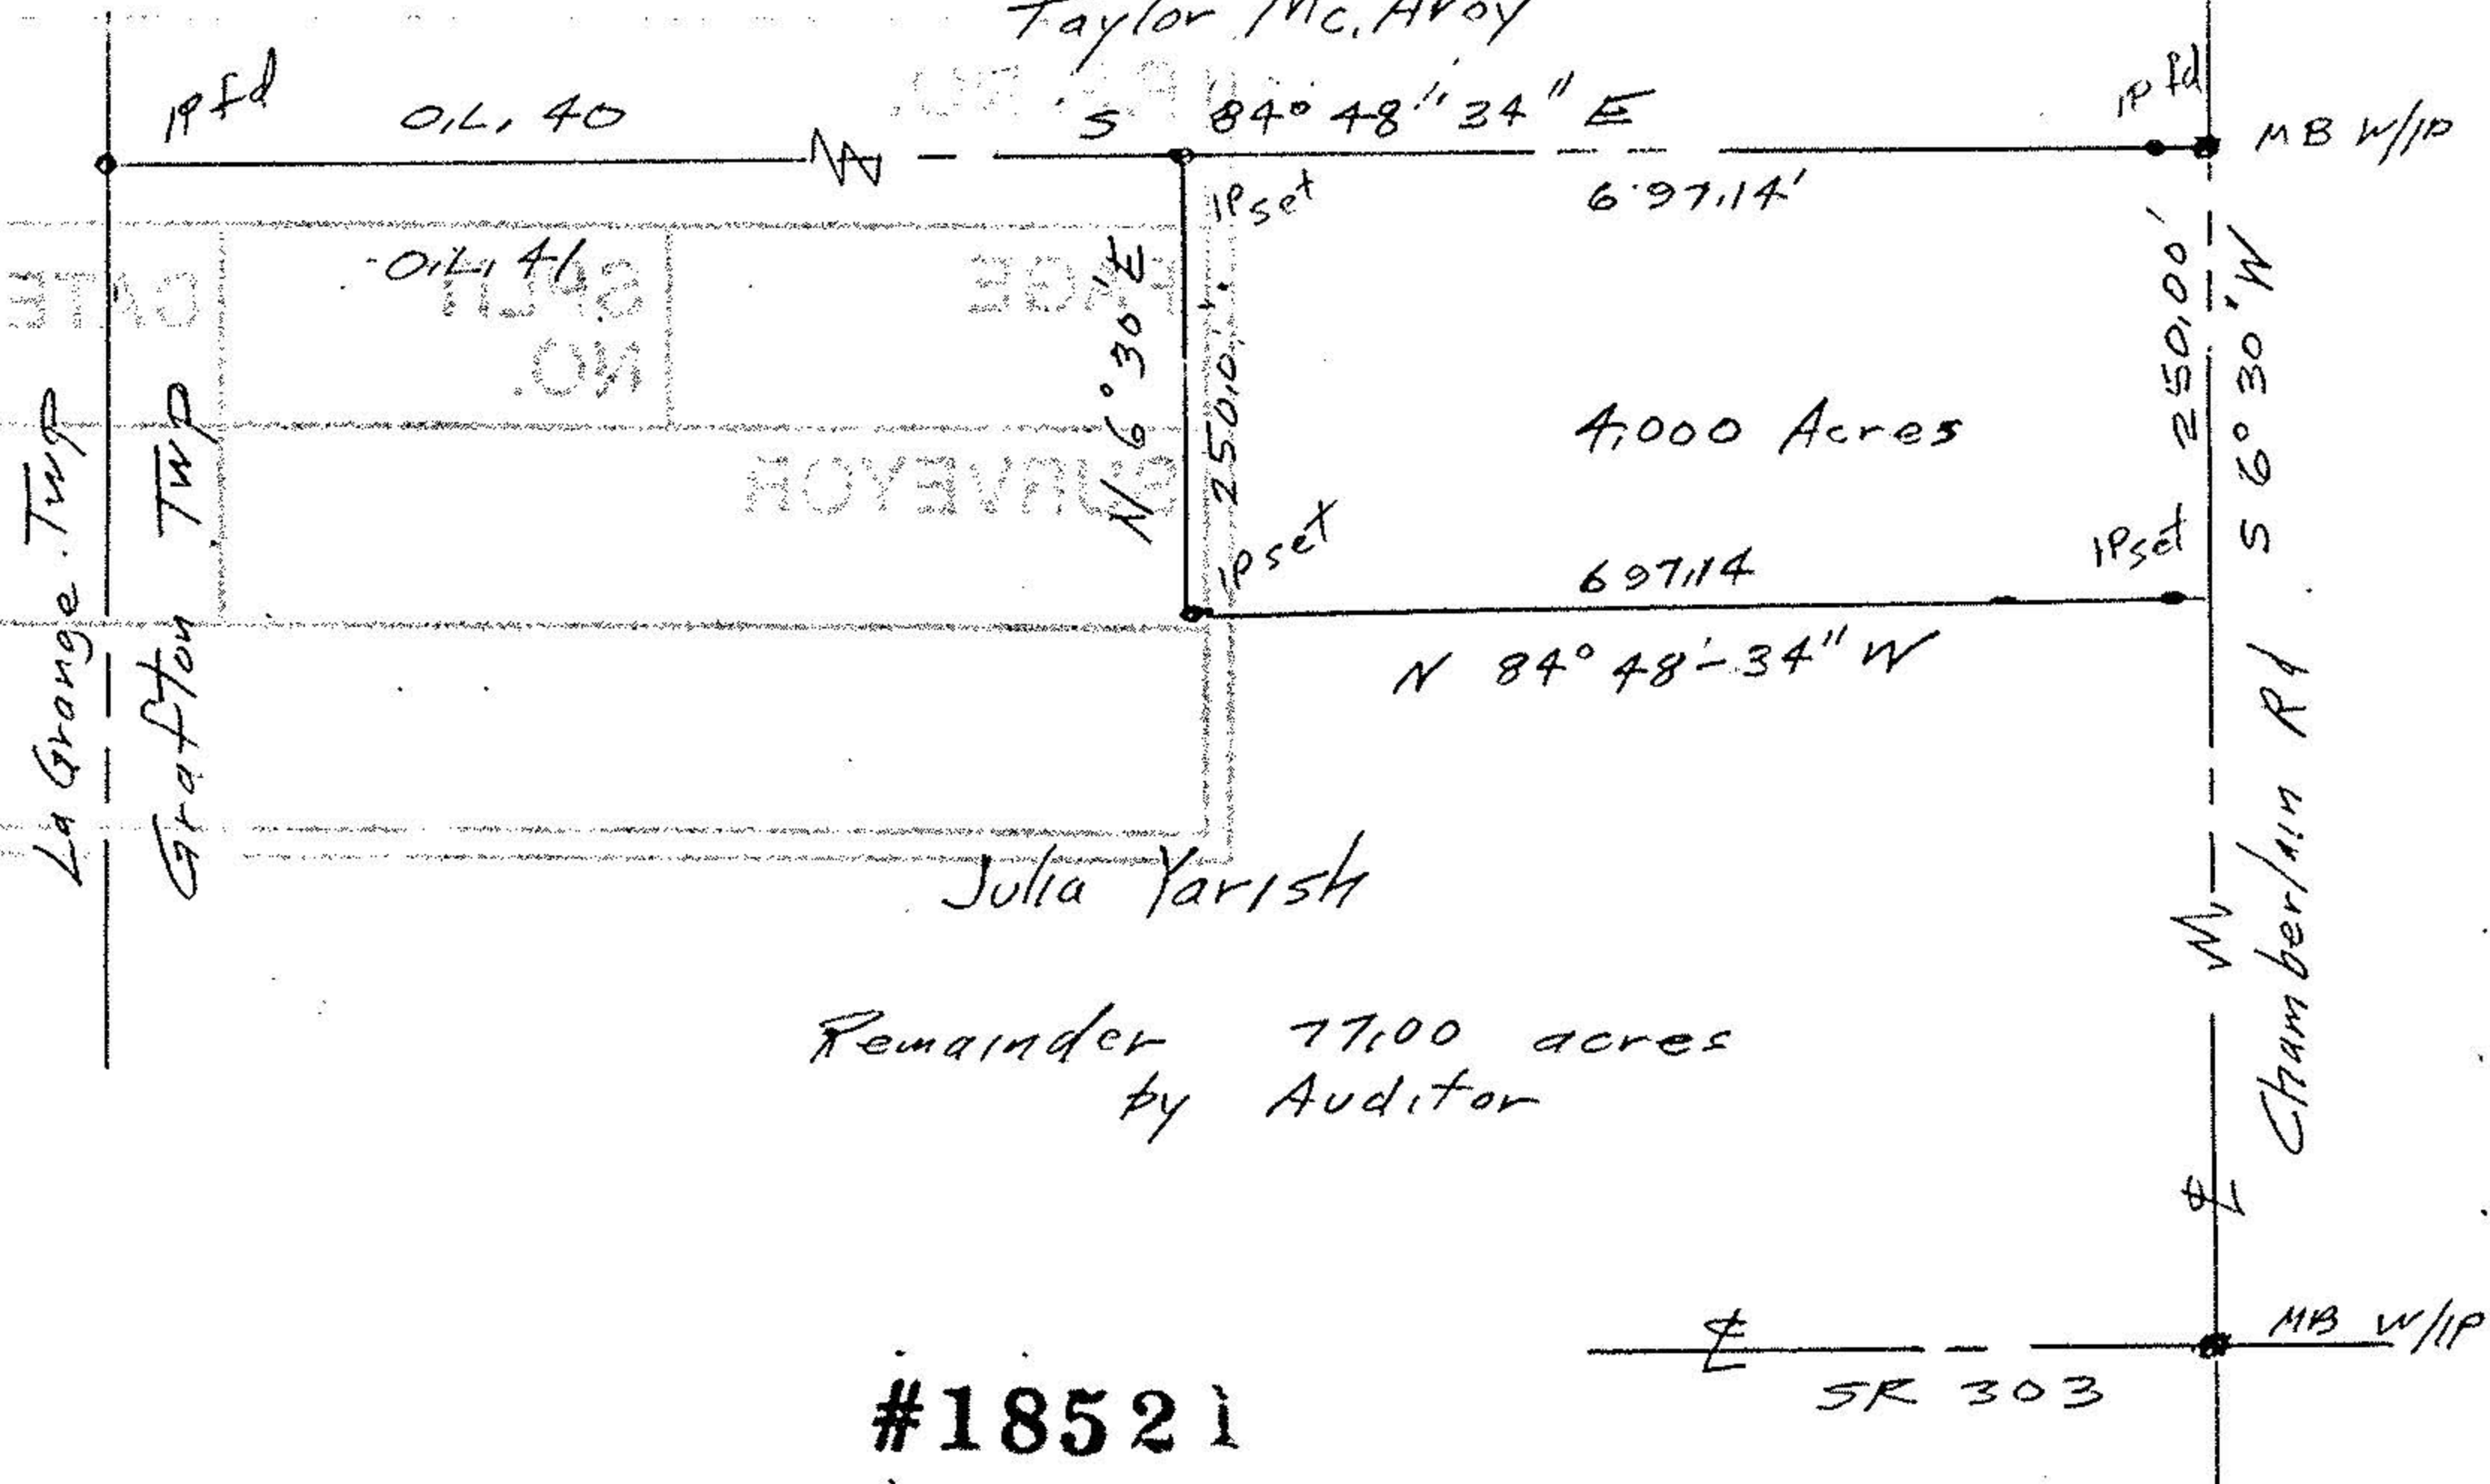

Remainder 77.00 acres
by Auditor

#18521

APPROVED	
LORAIN CO.	
MAP DEPT.	
DATE 5-7-11-89	
PAGE 16-A	
BY T. McMain	
VOID AFTER	18521

John Reg
Surveyor
5292

Survey of a Parcel Split
of 4,000 acres
Part of Original Lot 41
Grafton Township
Lorain Ohio
Scale 1"=200' Jun 25, 1989