


Map of Survey Part of Lot 2 Tract 7 Brighton Wp.
 Linn Co. Mo scale 1" = 100'
 April 20, 1971
 By Arnold J. Kory Registered Surveyor

5038

17-D

5037
 5038

17-07-001-000

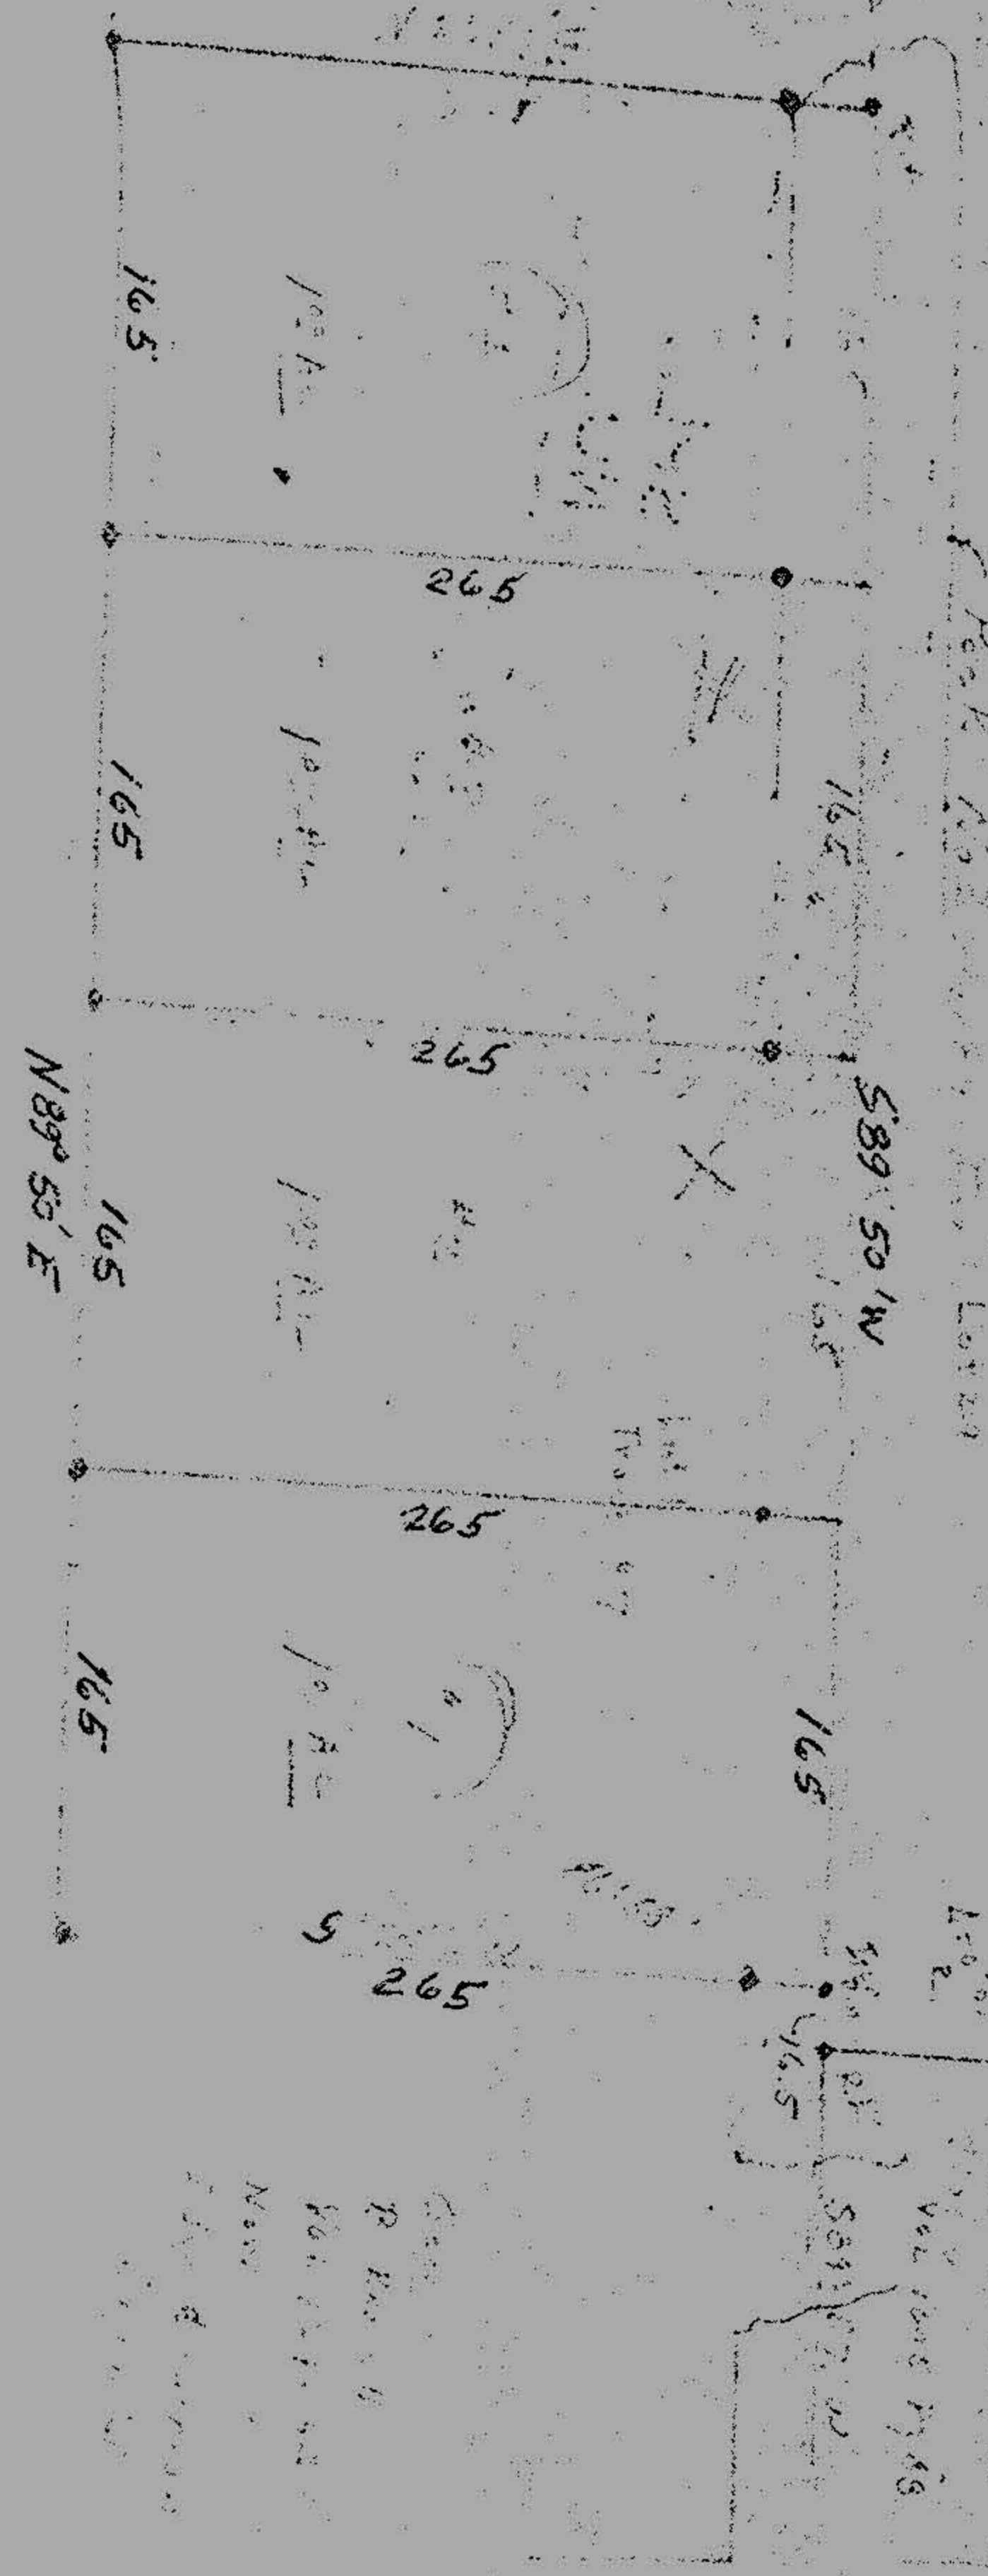

Rock Lot
 Lot 2

Section 16.5
 100' AL
 100' AL
 100' AL

Section 16.5
 100' AL
 100' AL