


17-07-003-000

17-0

10582
17C

17-07-003

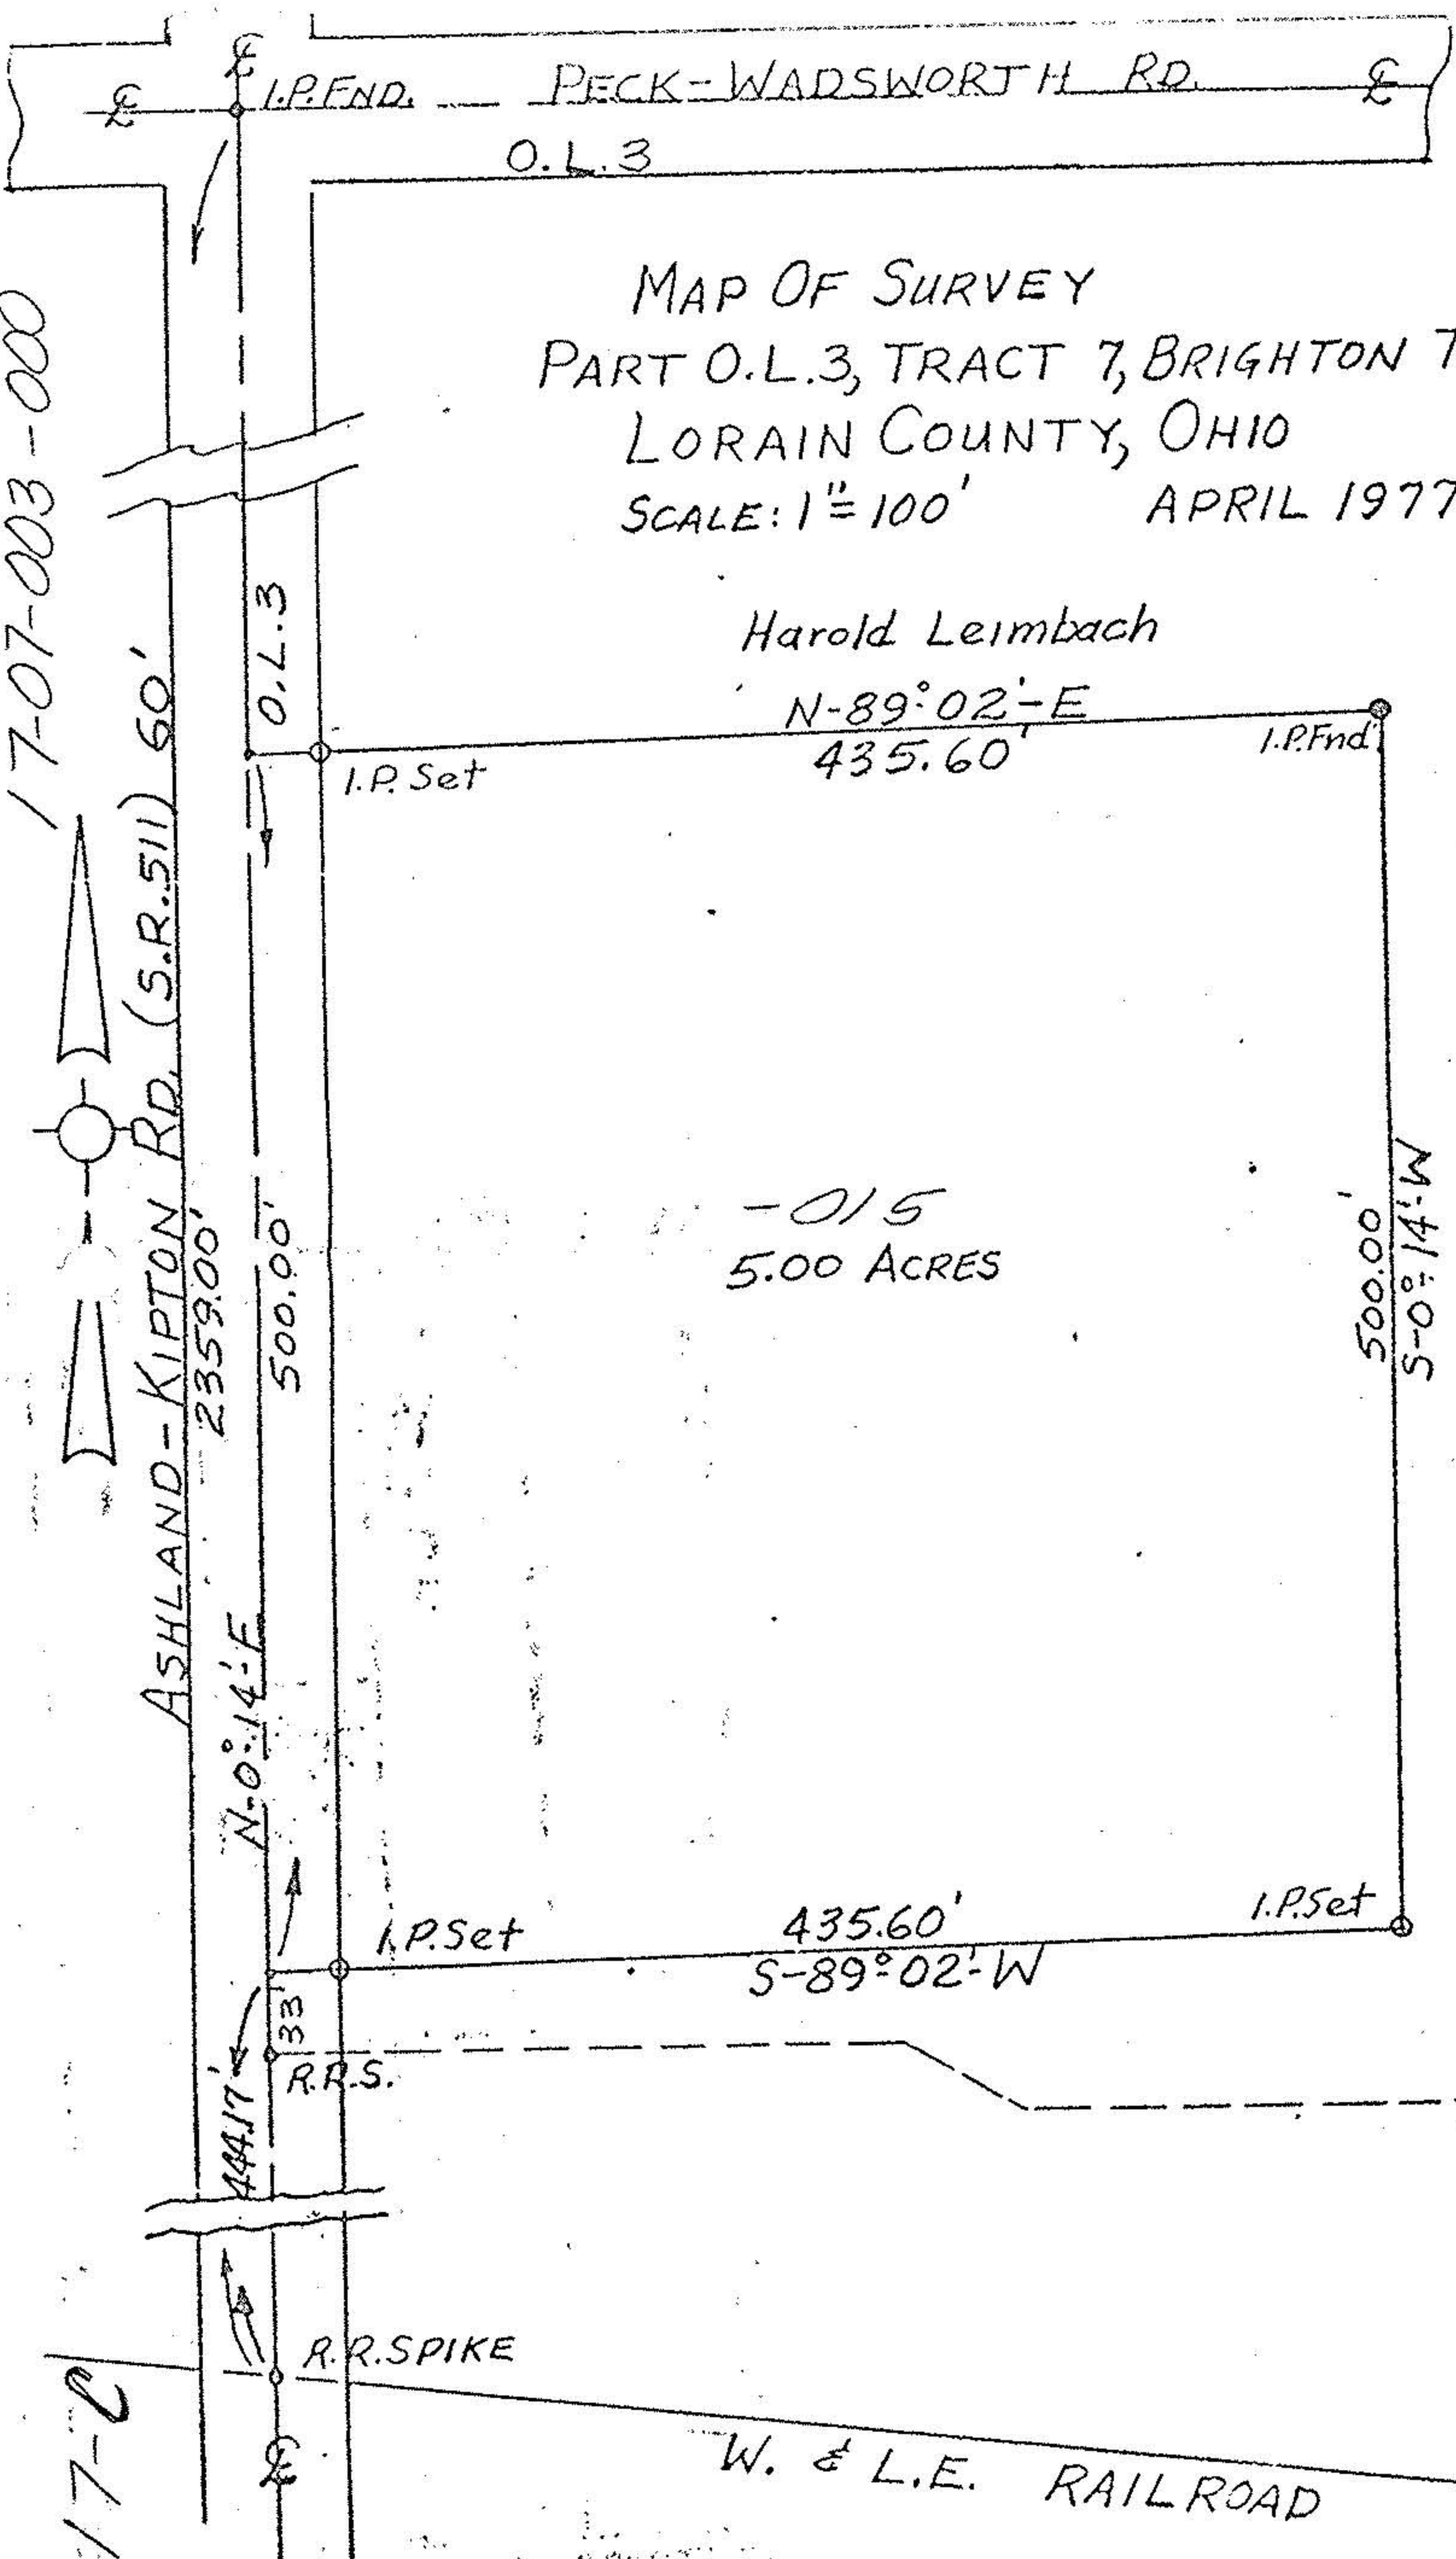


MAP OF SURVEY
 PART O.L.3, TRACT 7, BRIGHTON TWP.
 LORAIN COUNTY, OHIO
 SCALE: 1" = 100' APRIL 1977

Harold Leimbach
 N-89°02'-E
 435.60'

-015
 5.00 ACRES

MAY 31 1977

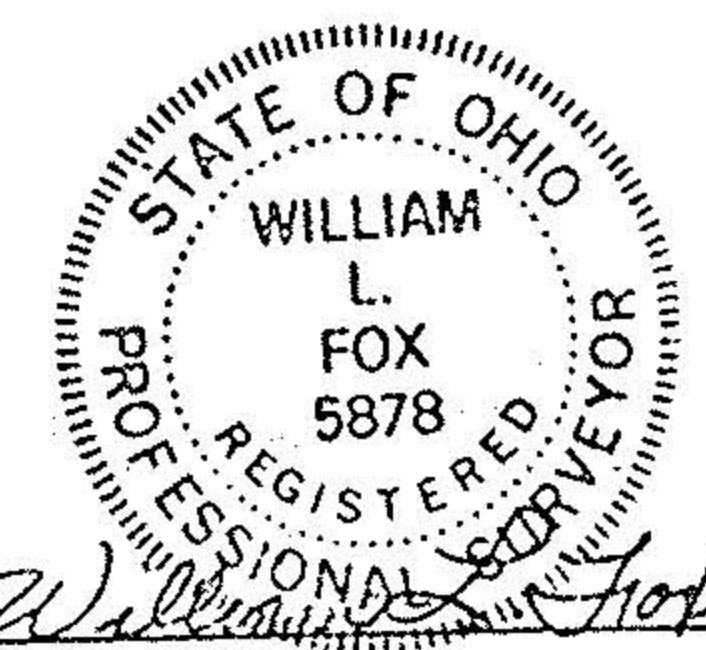

William L. Fox
 WILLIAM L. FOX
 REG. SURVEYOR
 REG. No. 5878

In R No. 77-118