


17-07-005-000

#16964

17-A


PECK WADSWORTH ROAD

Map of Survey Part of Lot 5 Tract 7 Brighton Twp.
Lorain Co. Ohio Scale 1" 100'
By Arnold F. Koepp Reg. Surveyor No. 4306
June 28, 1986

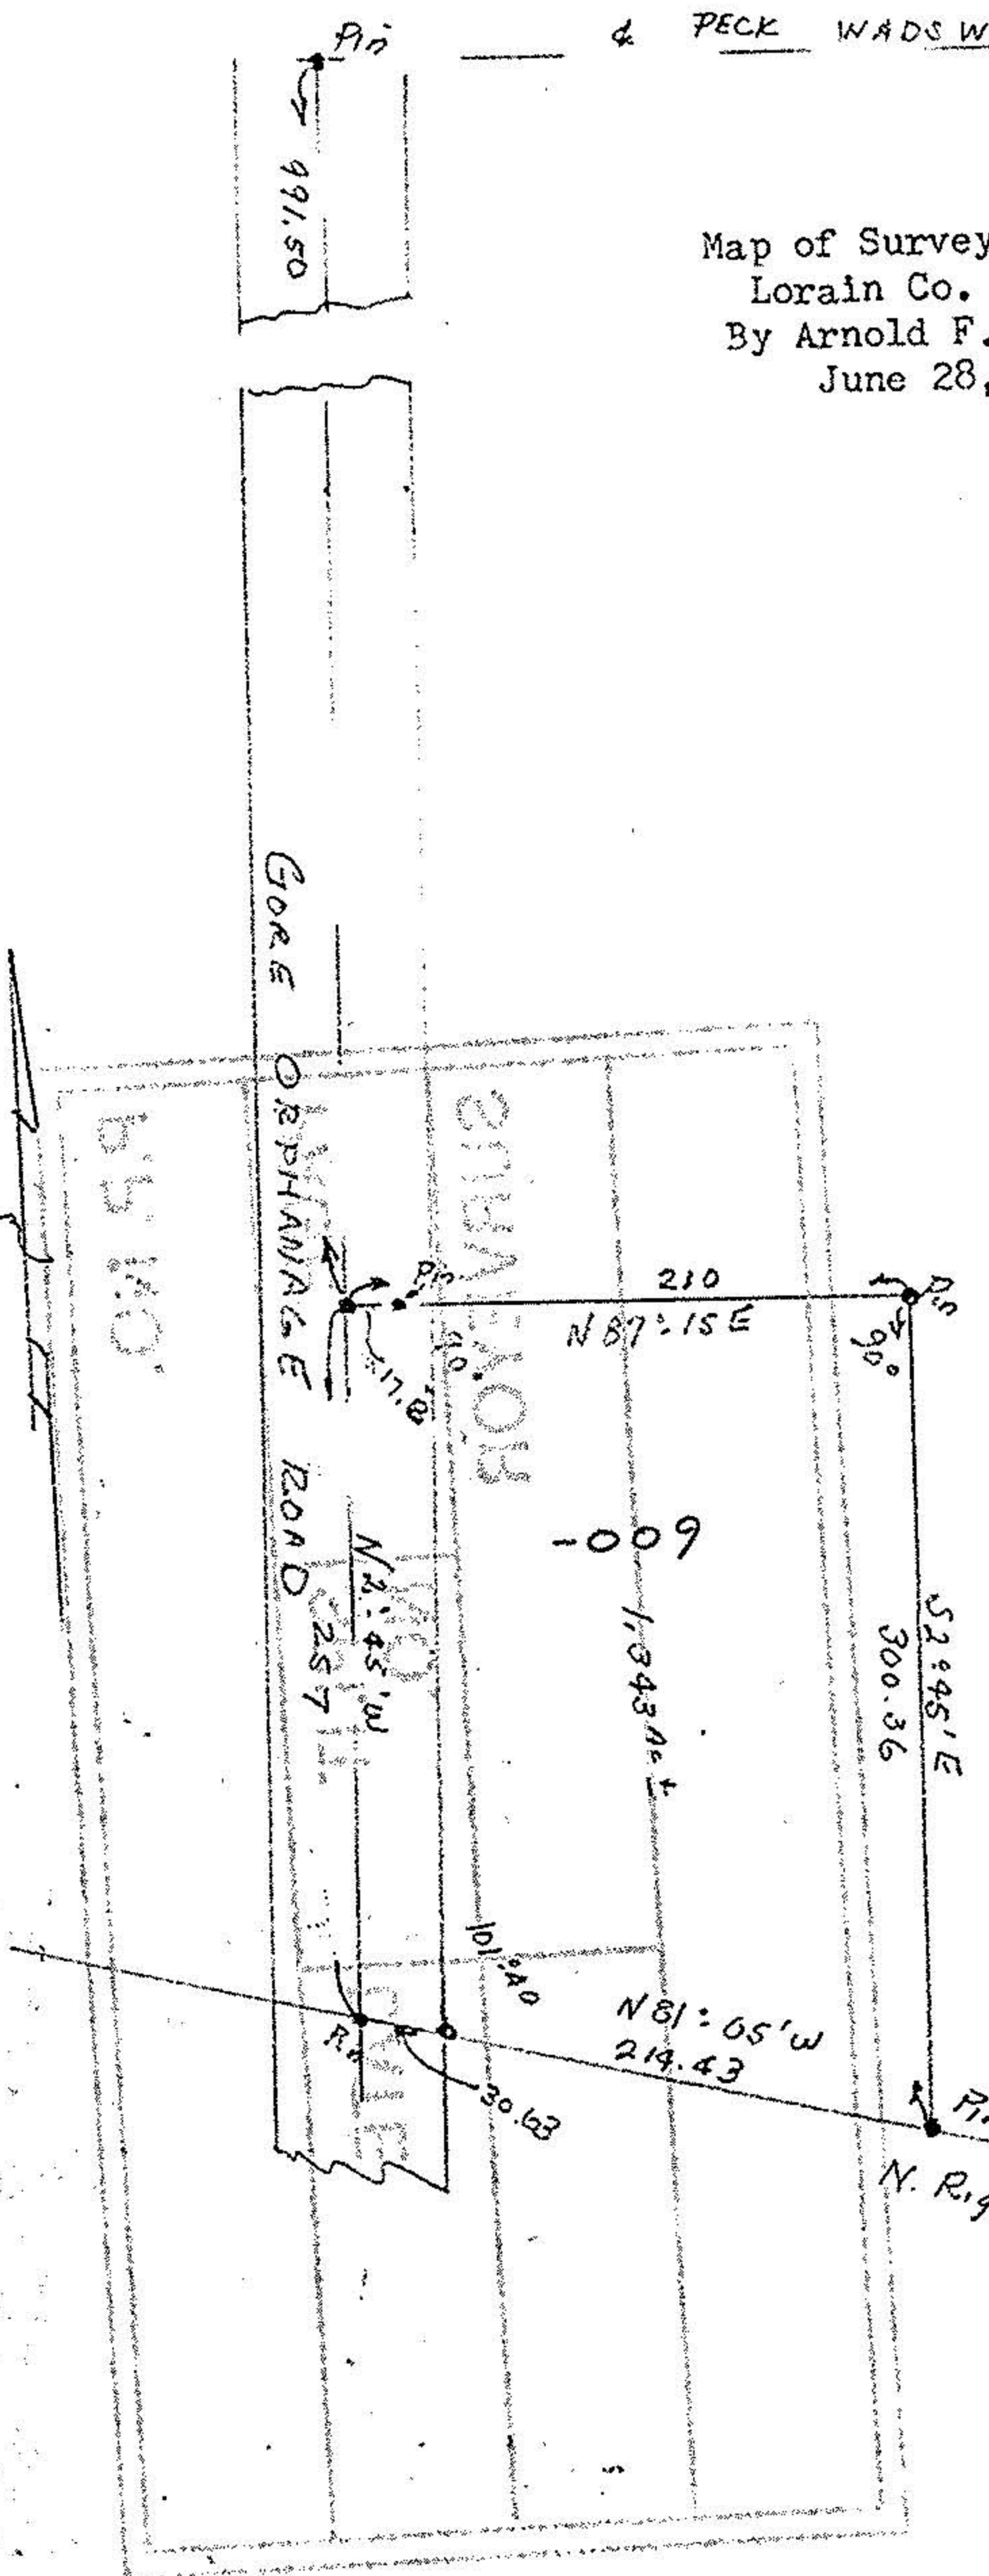

#16964

APPROVED	
LORAIN CO.	
MAP DEPT.	
DATE	8-29-86
PAGE	17-A
BY	<i>J. Koepp</i>
VOID AFTER	16964

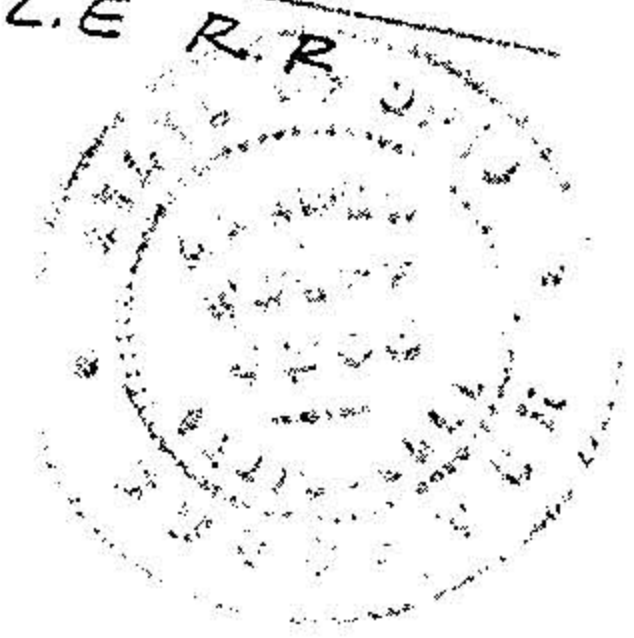

N. Right of Way W & L.E.R.R.