


17-H

17-07-011-000

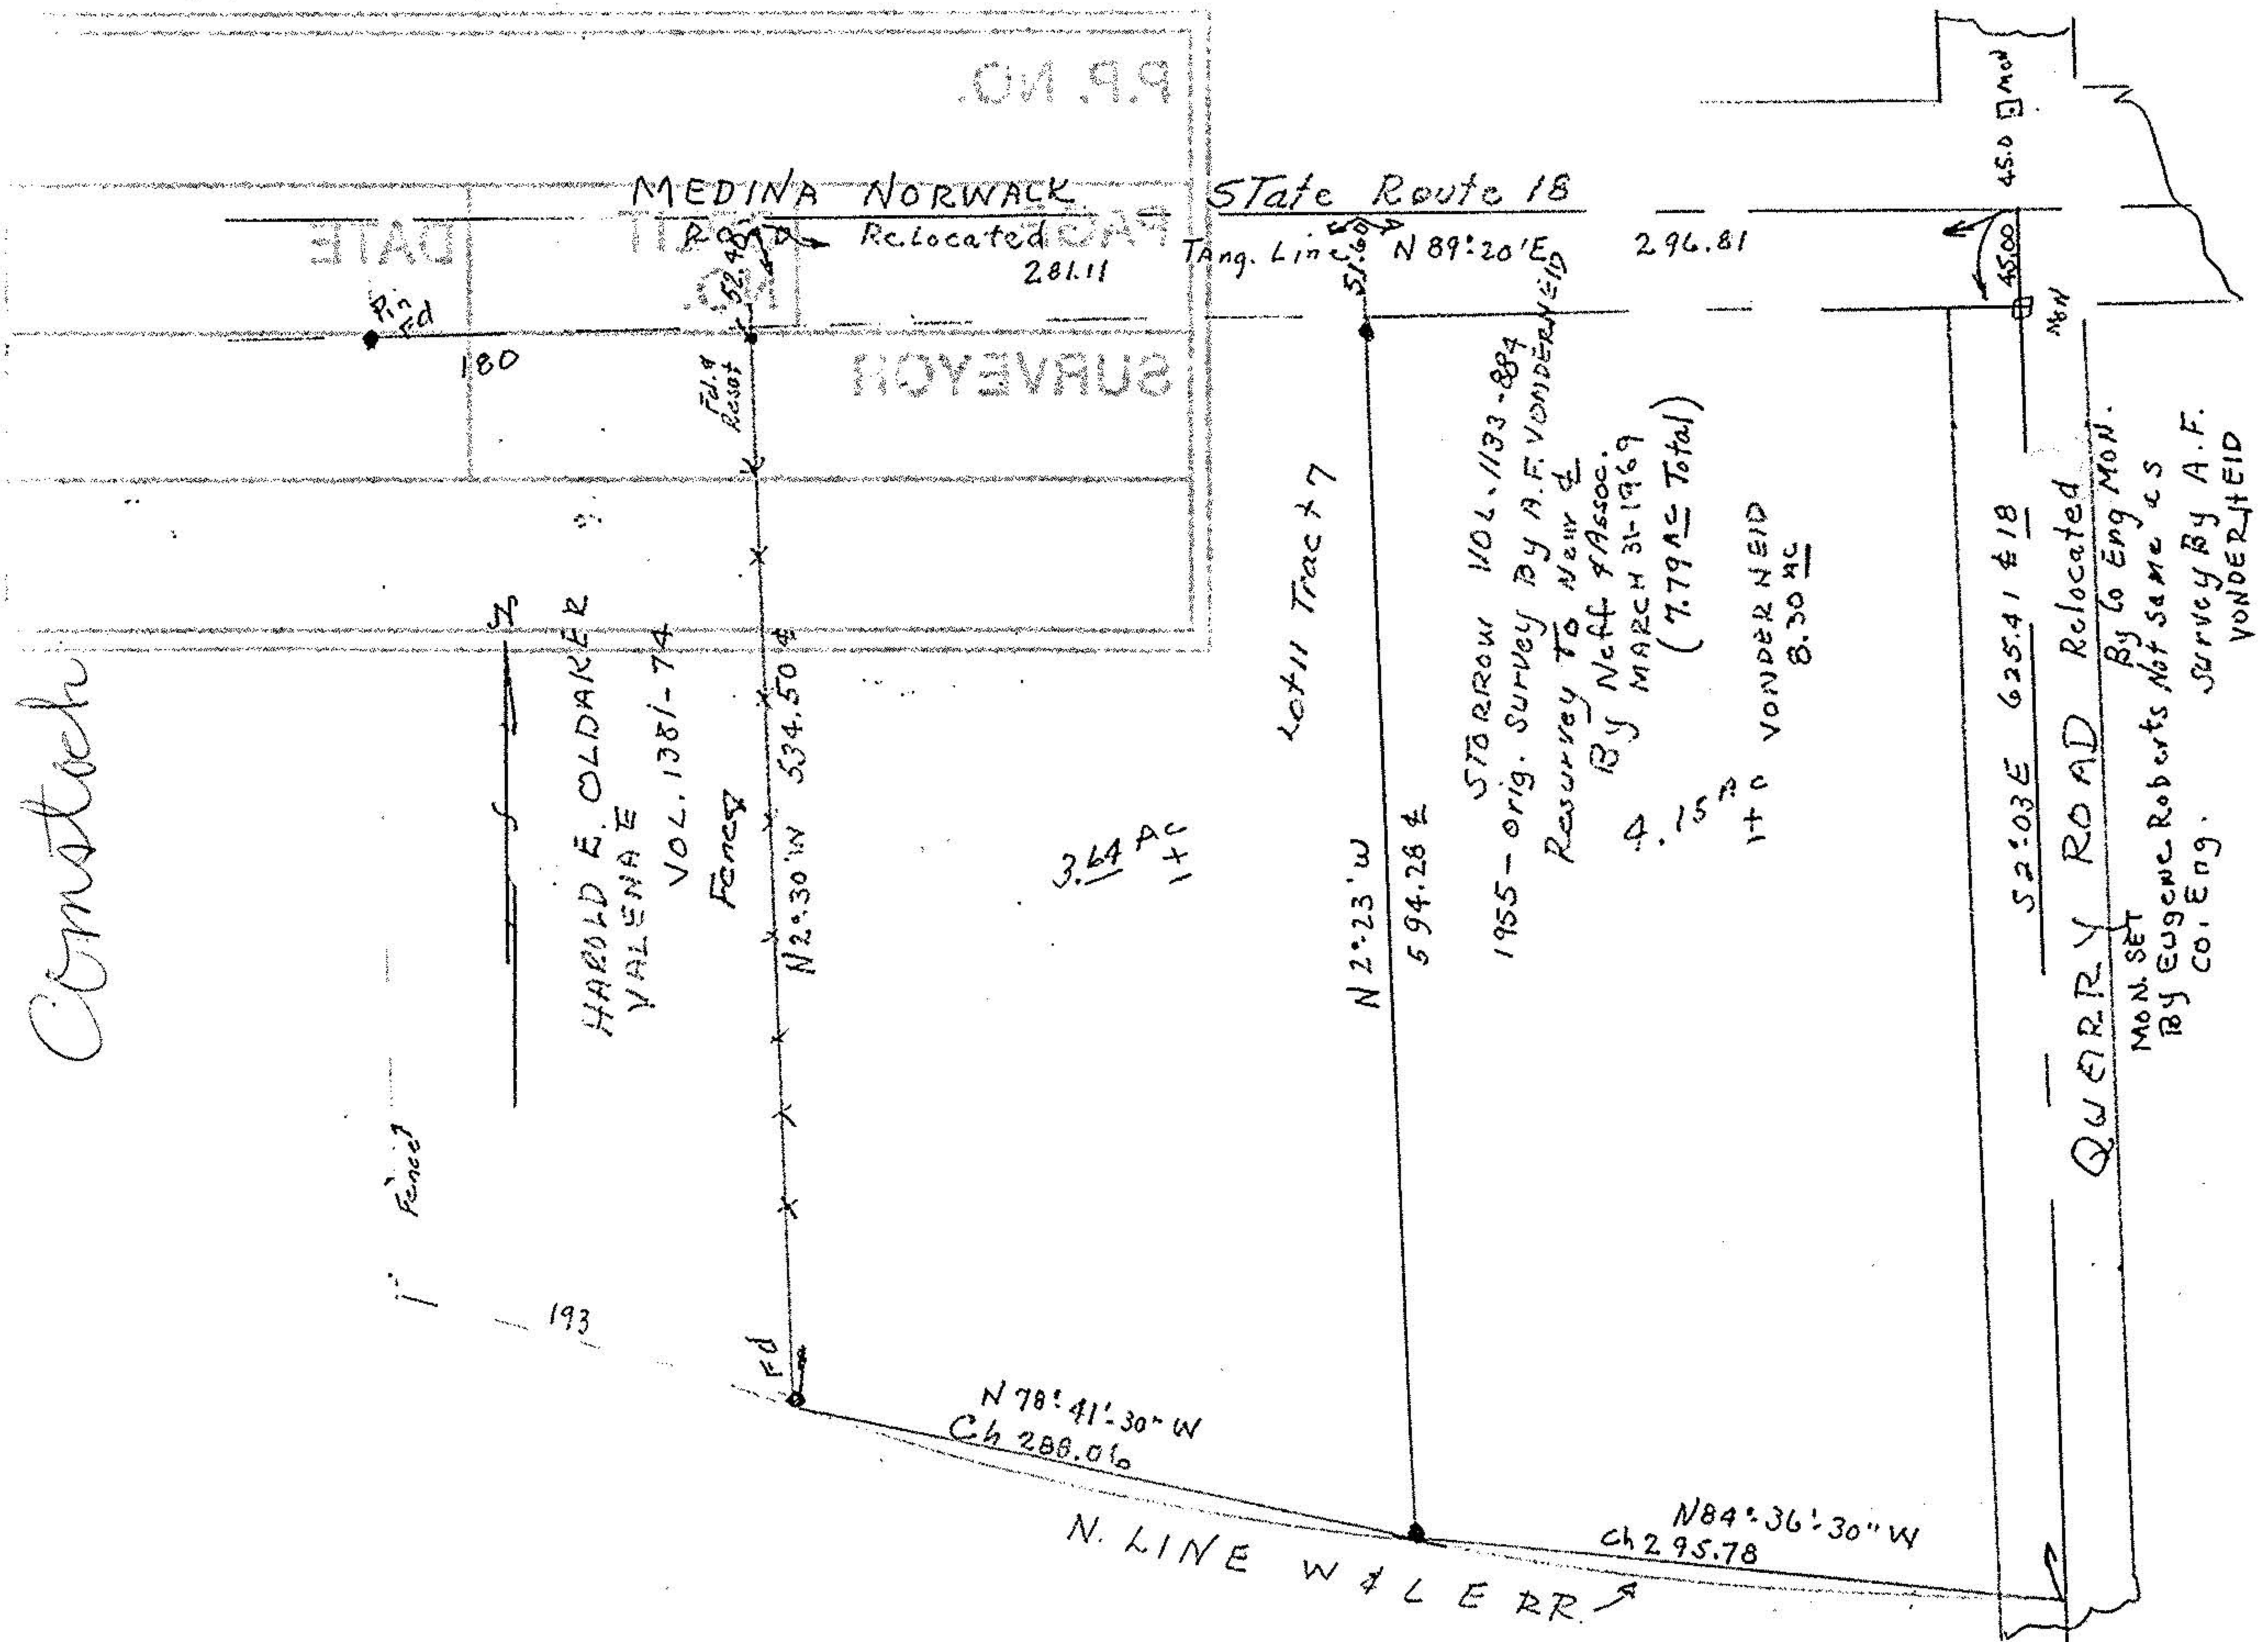

Constach

Map of Part of Lot 11 Tract 7 Brighton Twp. Lorain Co. Ohio
 Scale 1" = 100' May 12, 1986 by Arnold F. Koepf Reg. Surveyor No 4306