


17-60161

17 60161

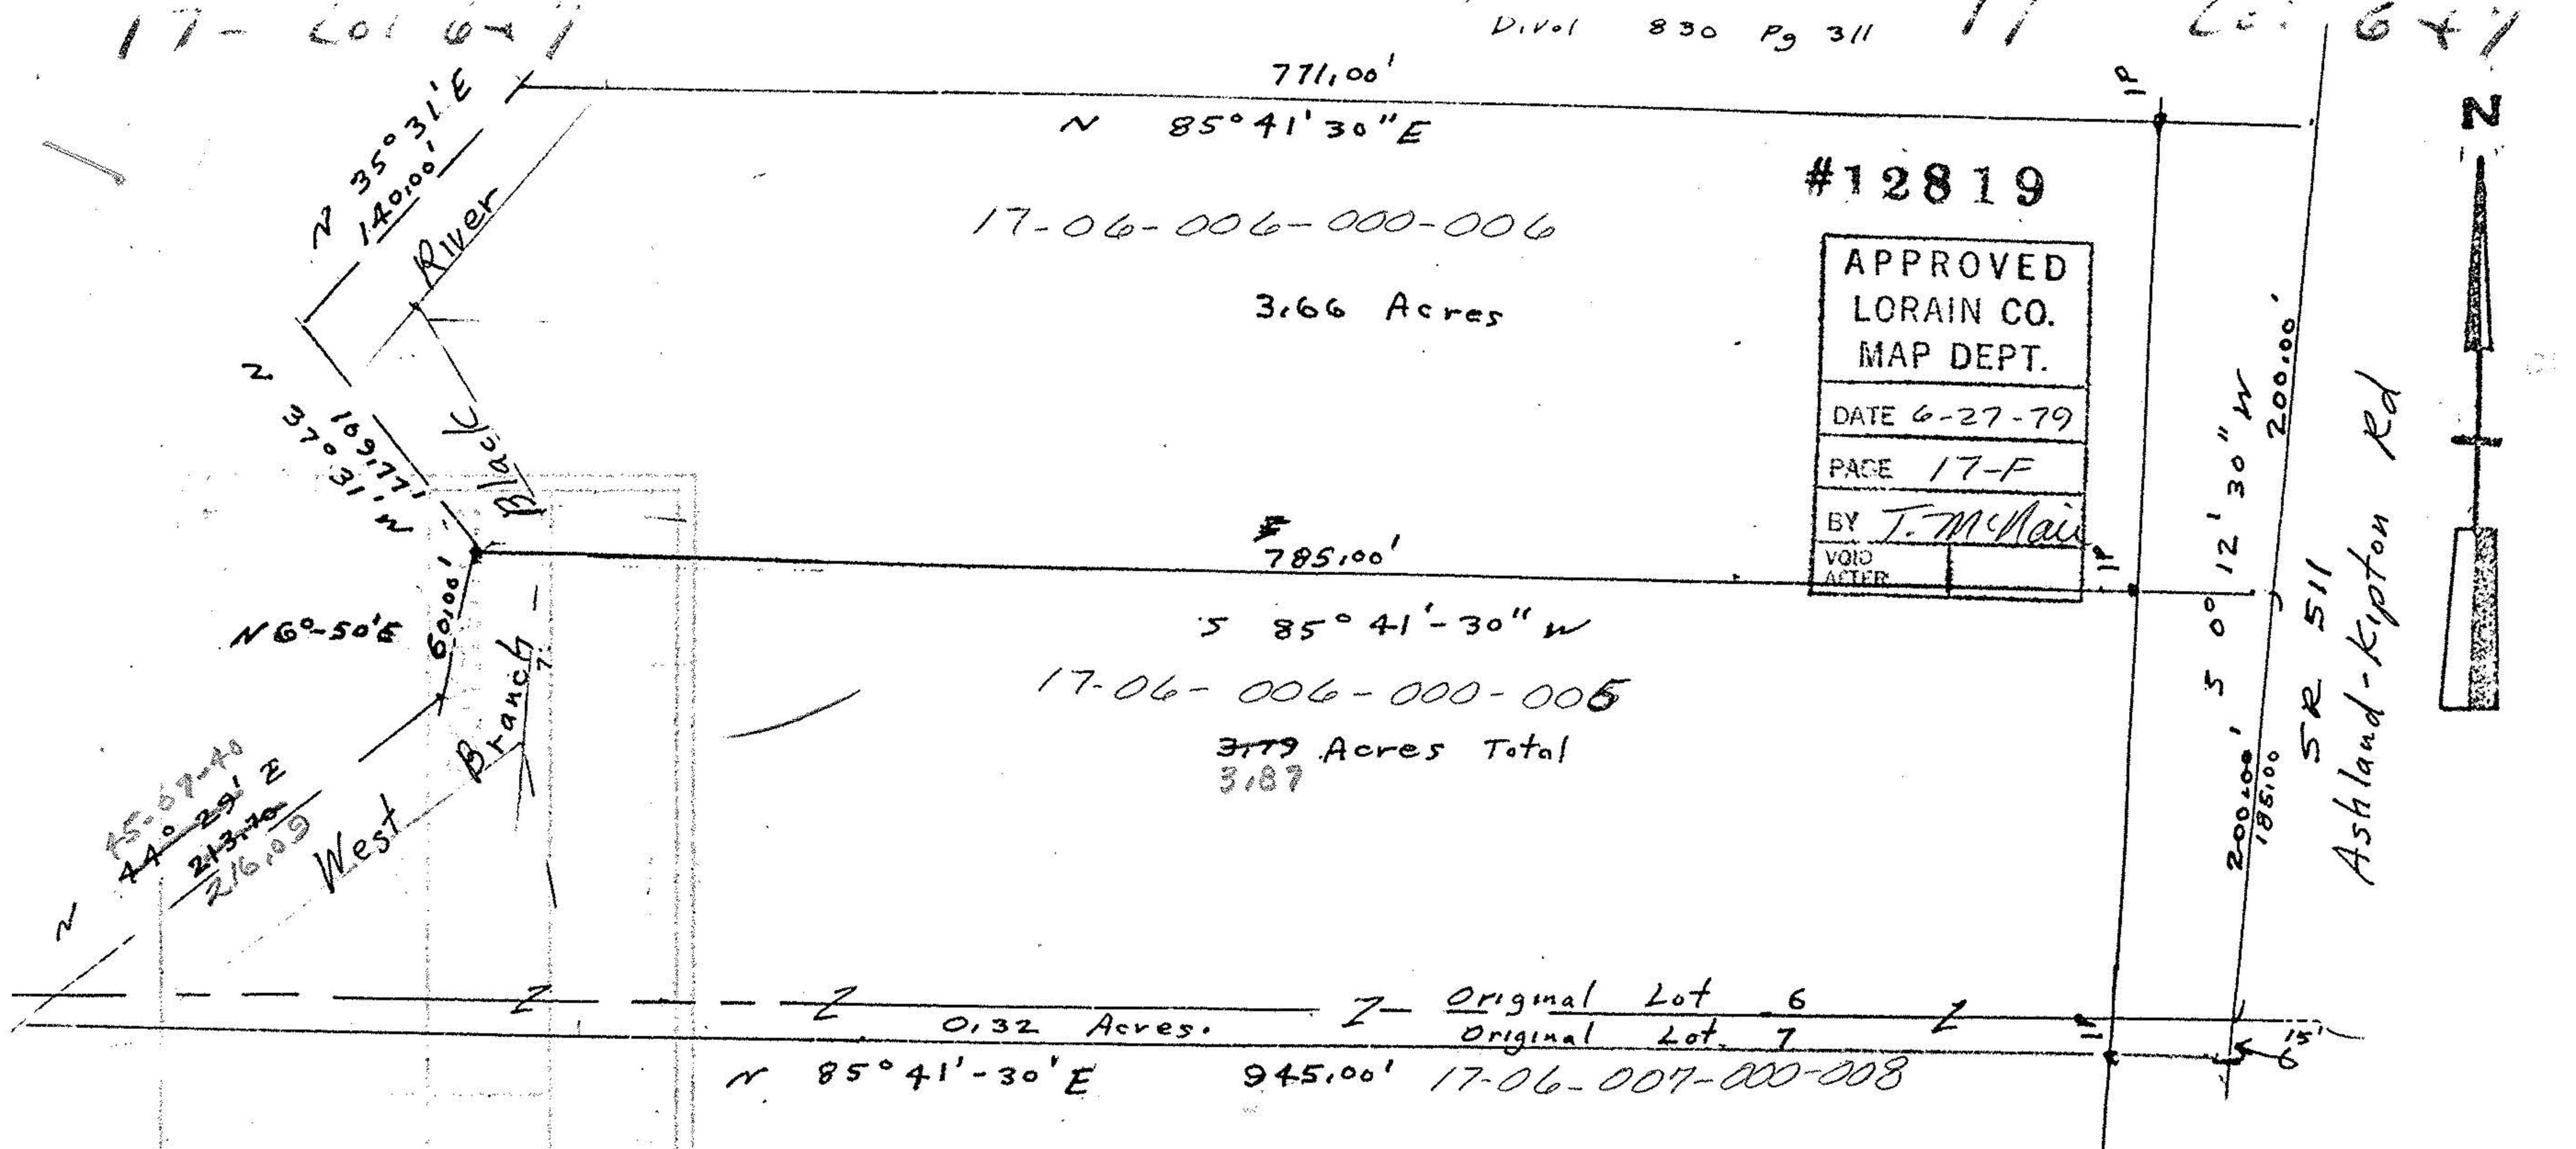

John
Reg
Poznywak
Surveyor
5292

Survey for Glenn Brennan
Original Lots 6 & 7
Tract 6
Brighton Twp
Lorain County Ohio
Scale 1"=80' April 1979

