


17-Lot 8
Gore-Orphanage Road

17-06-008-000
17-06-008-004

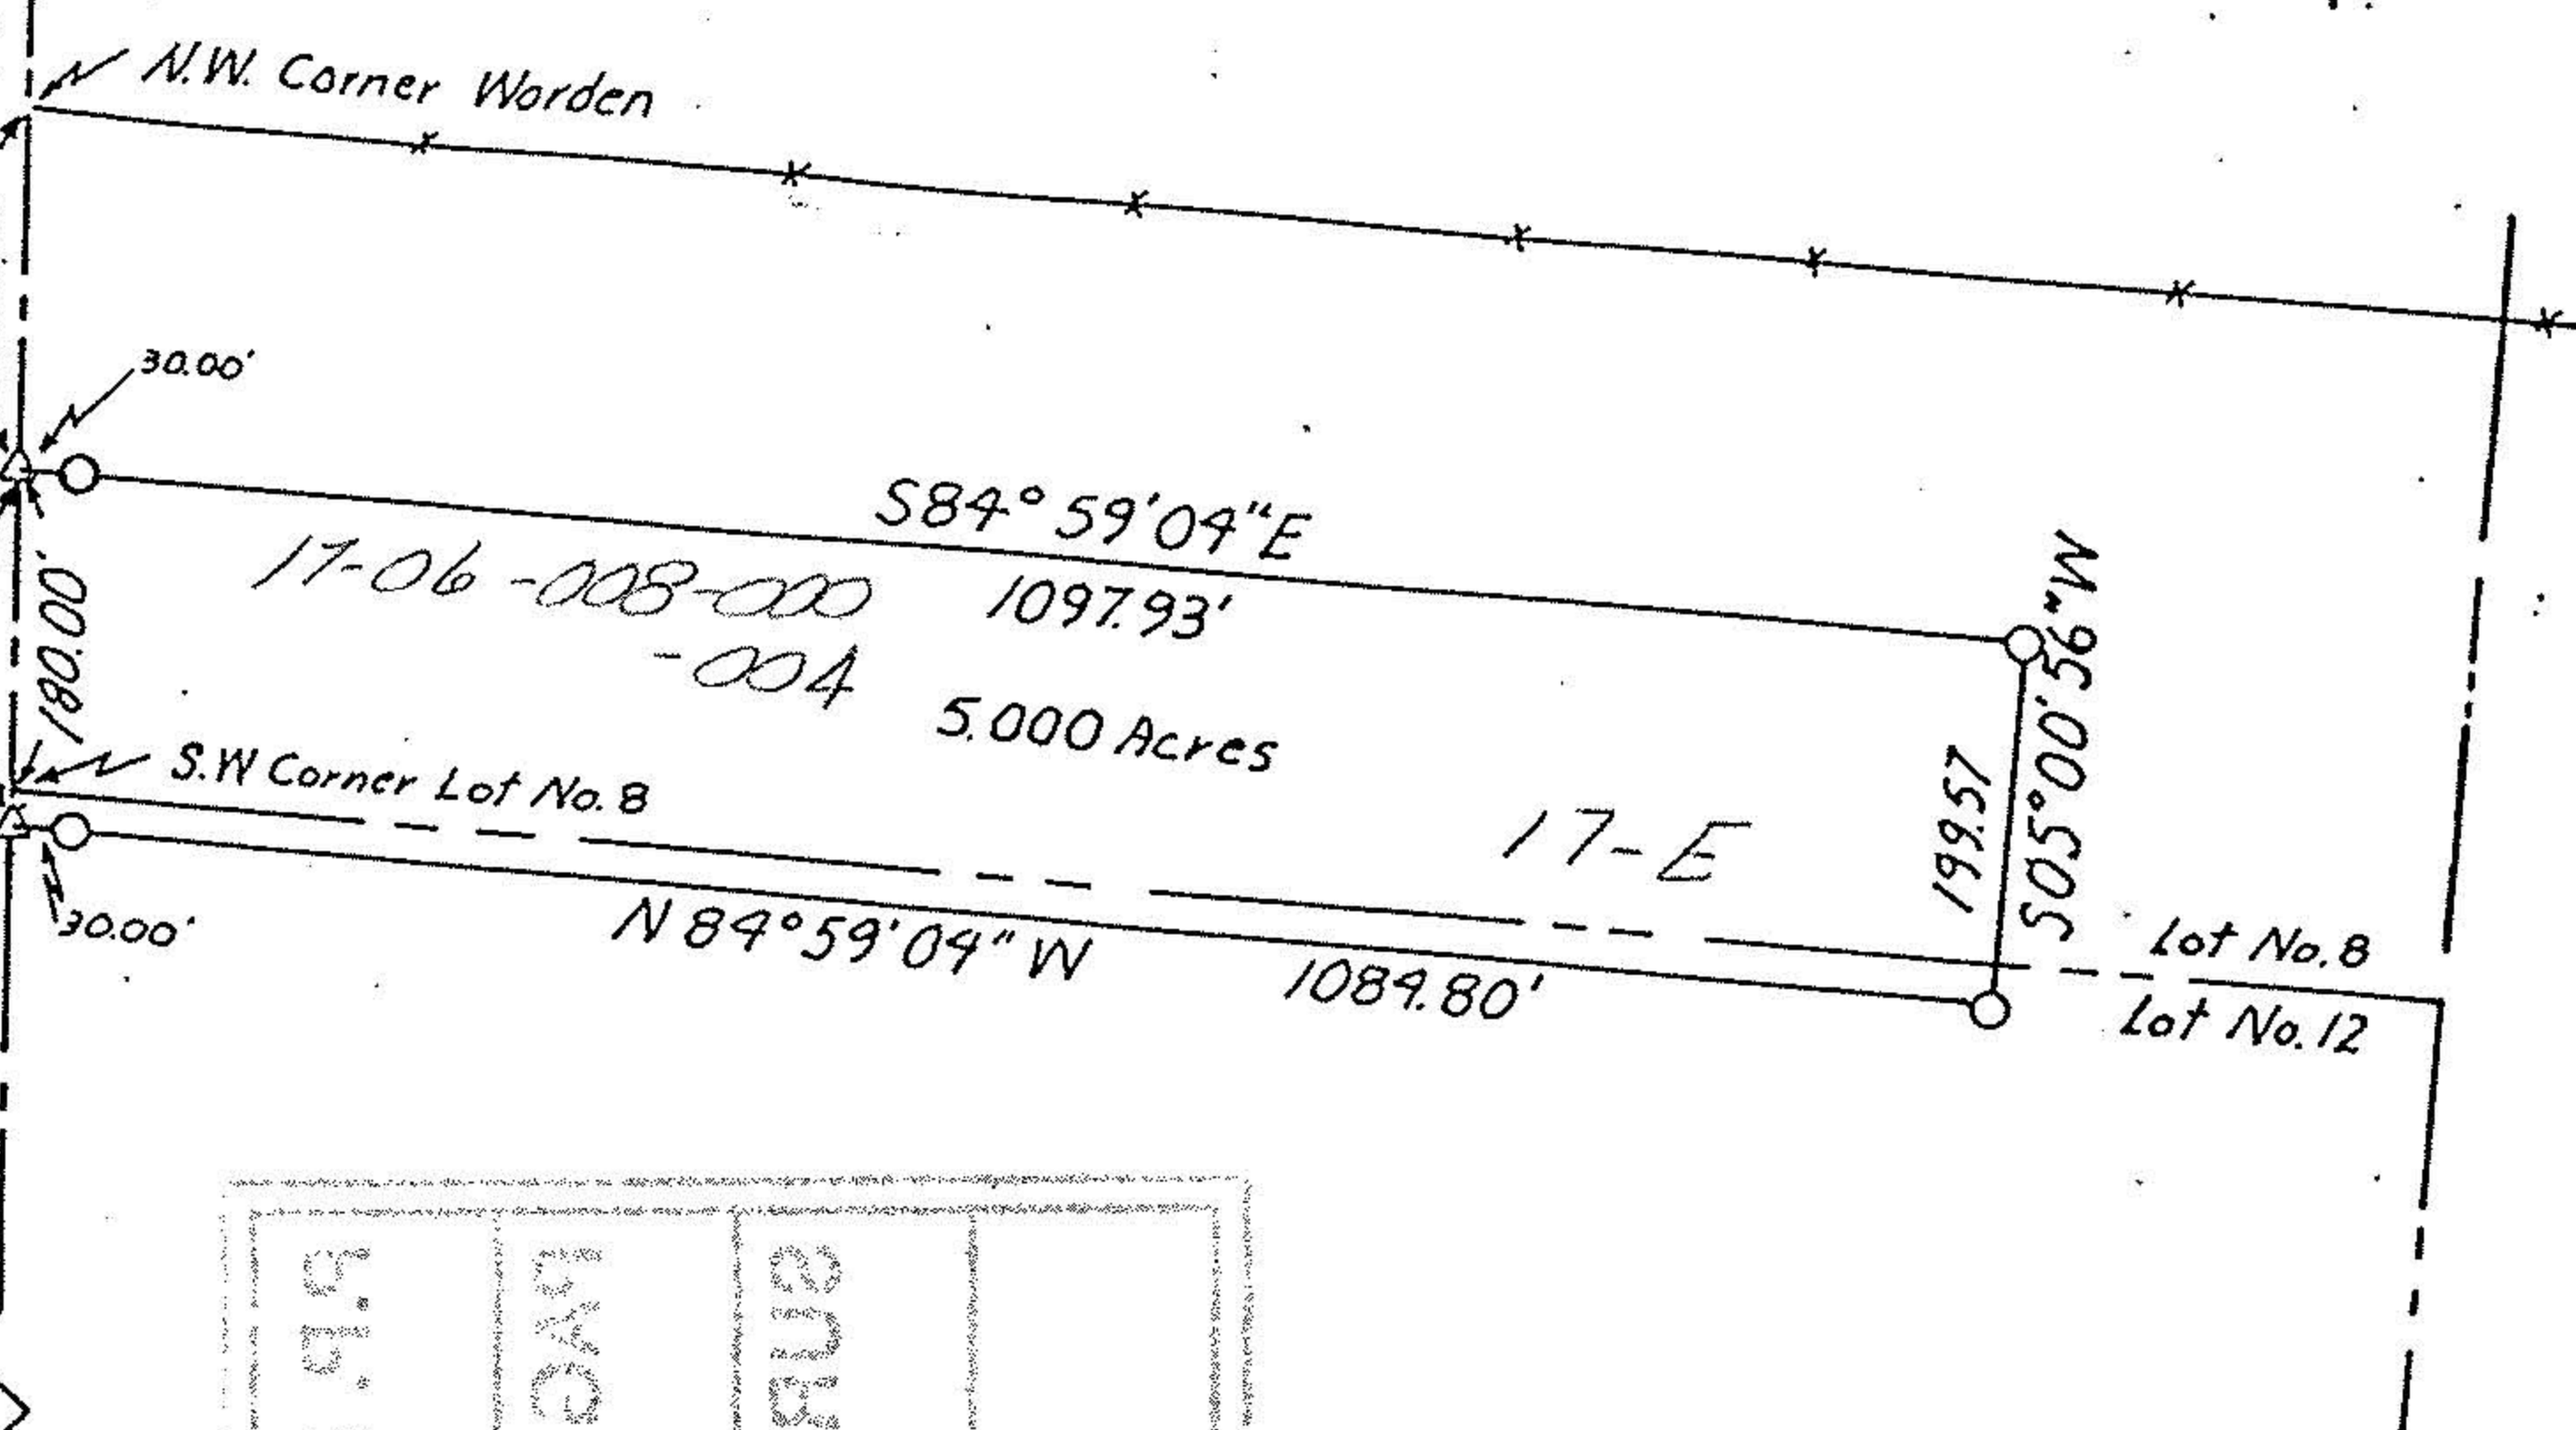

515 NO.
PAGE
SURVEYED
DATE


I hereby certify this plat to be a true delineation of a field survey made by FOX SURVEYING and that all monuments were found or set as shown.

William L. Fox

William L. Fox, Reg. Surveyor No. 5878

All bearings are assumed and are to be used for the determination of angles only.

#12652

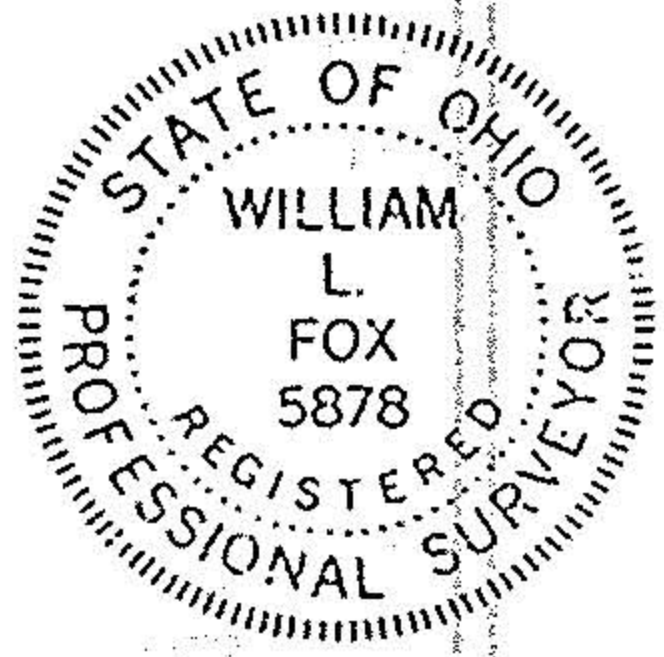

APPROVED	
LORAIN CO.	
MAP DEPT.	
DATE	5-1-79
PAGE	17-E
BY	<i>[Signature]</i>
VOID AFTER	

- Legend
- △ Railroad Spike Set
 - △ Railroad Spike Found
 - Iron Pipe Set
 - *-*-* Fence

Parts of Lot Nos. 8 and 12		
Brighton Township, Lorain County, O.		
Survey For Dolores Worden et al.		
Wm. L. Fox Reg. Surveyor #5878		
287 West Main Street		
Ashland, Ohio 44805		
Scale: 1"=200'	Job. No. 79-110	Date: 4-12-79

17-E