


17-06-018-000-010  
011  
-013

17-4

See 17-F for detail of parcels here.

TON

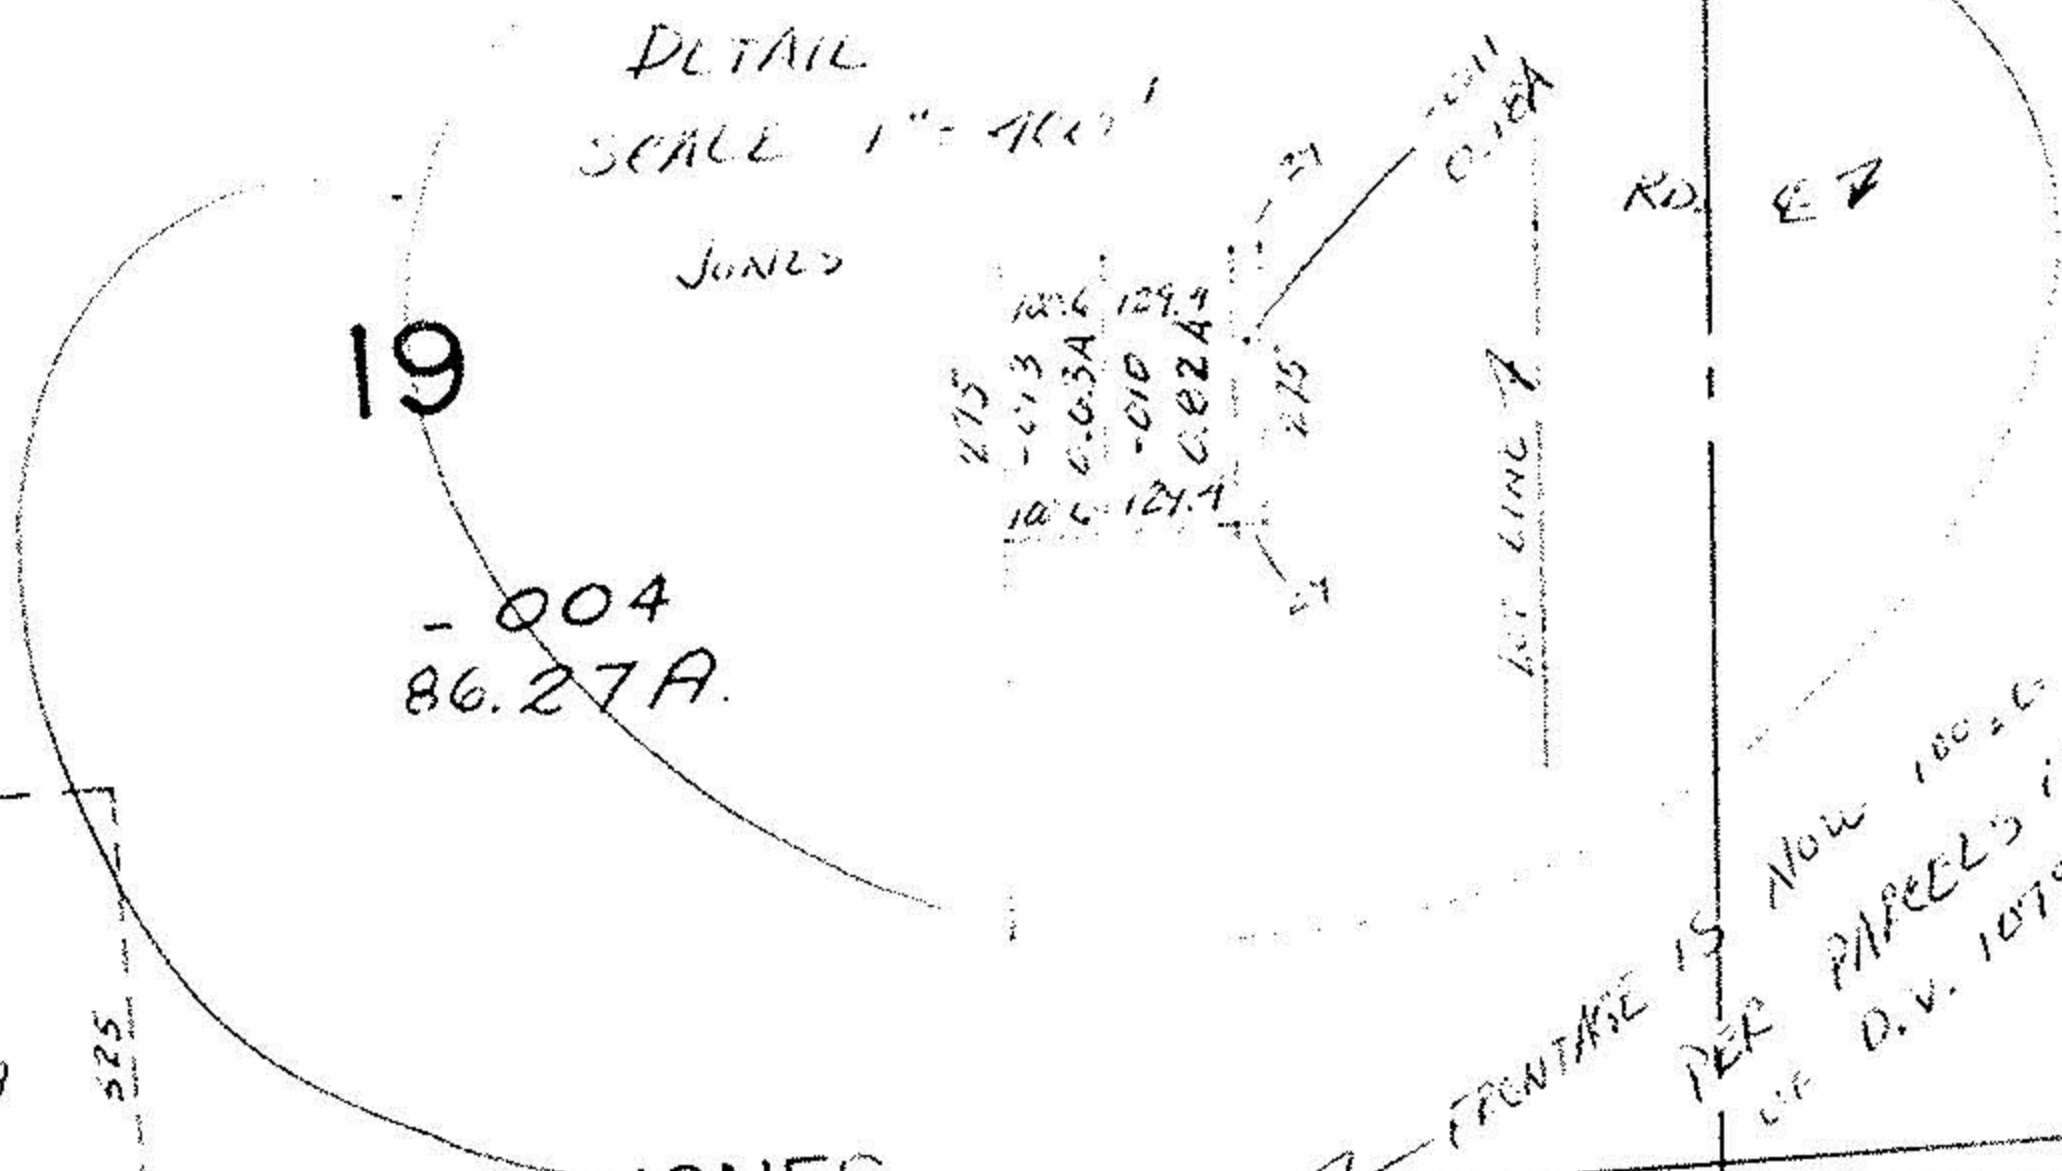

# MAP CORRECTION ONLY

-003  
51.25A

NO. NUMBER

APPROVED
LORAIN CO.
MAP DEPT.
DATE 1-19-81
PAGE 17-6
BY T. McHair
VOID AFTER

FEB 25 1983

18

100.6  
129.4  
29  
-----  
259.0

-005  
25.00A

-006  
25.00A

-001  
37.14A

R

A

C

T

FRONTAGE IS NOW 100.26  
PER PAPERS P. 2  
OF D.V. 1079/P 18

-001  
42.00

8299  
330

71.6 129.4 274.49  
-011  
18A  
215  
-013  
63A  
-010  
82A  
215  
71.6 129.4 274.49