


17-06-032

17-06-032 000 013

Map of survey part of Tract 6 lot 30 Brighton Twp. Lorain Co. Ohio
Scale 1" = 200' Oct. 7, 1977
By Arnold F. Koopp Reg. Surveyor No. 43063

SCAN # 27742

014

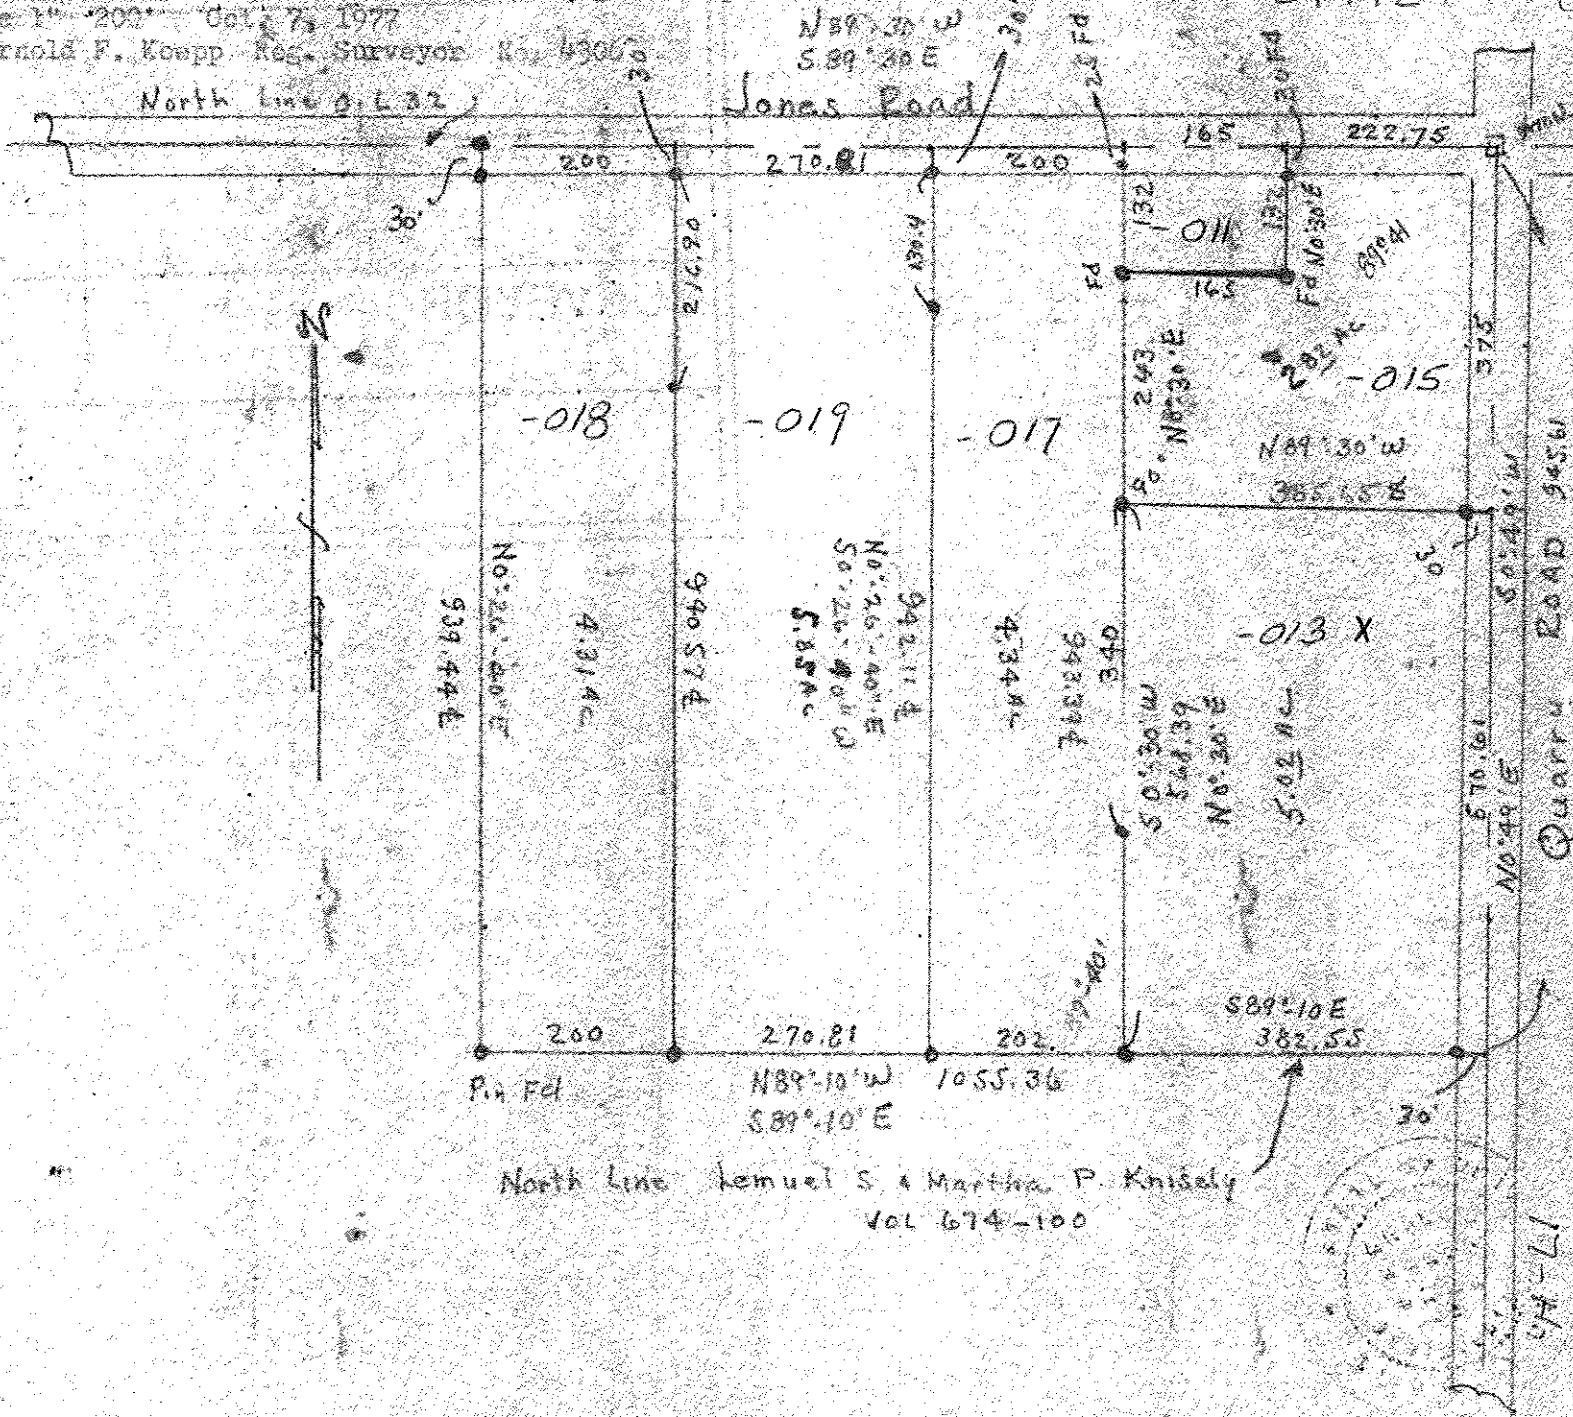

North Line Lemuel S. & Martha P. Knisely
Vol 674-100

#11222
17-14